



2251

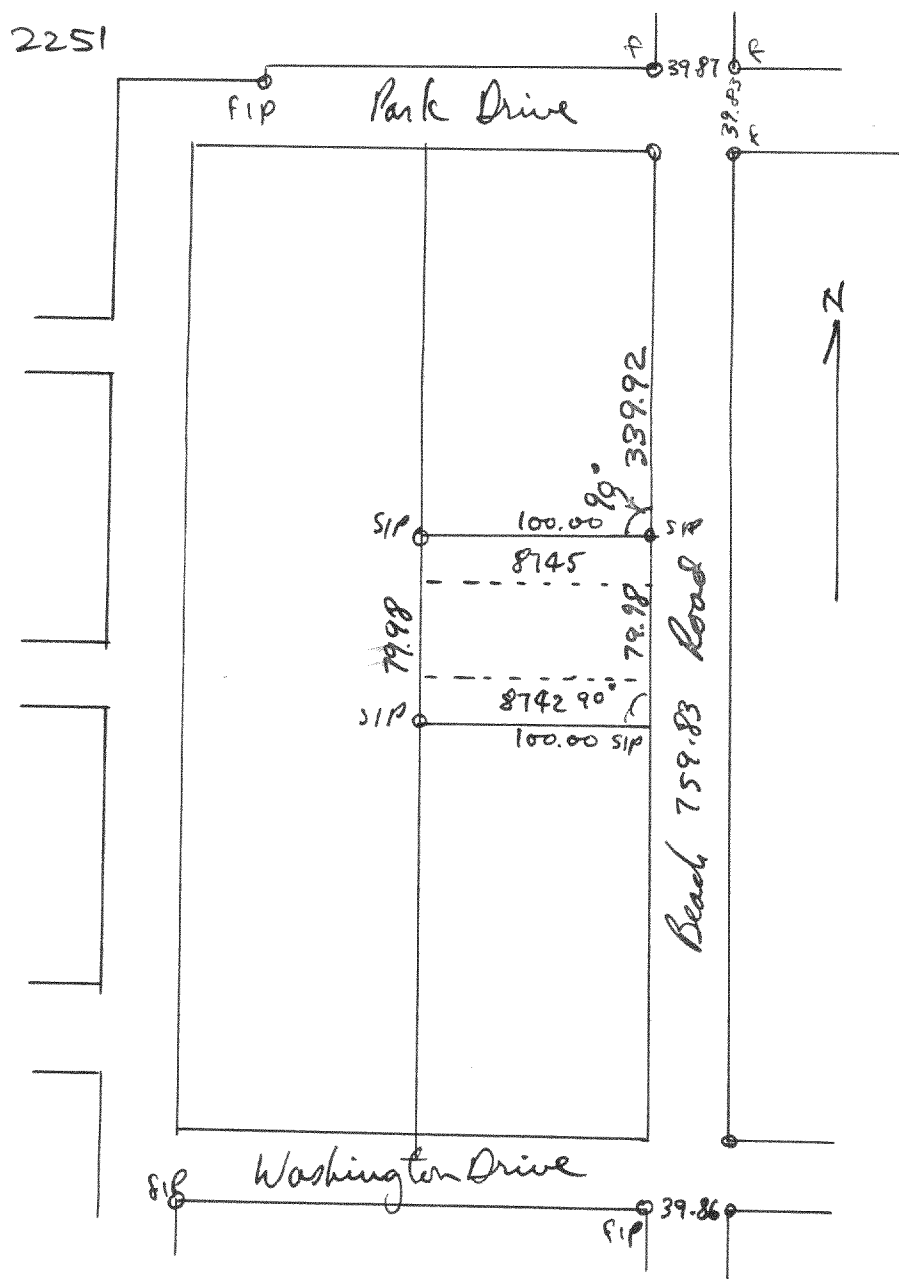

Plot of survey of Tds 8742-8745 of Lake Como Beach
Subd located in Sec 21 & 22 T2N R17E of Walworth
County, Wisconsin
Aug 8, 1950
Floyd L. Jensen

Lloyd L. Jensen
County Surveyor

2252

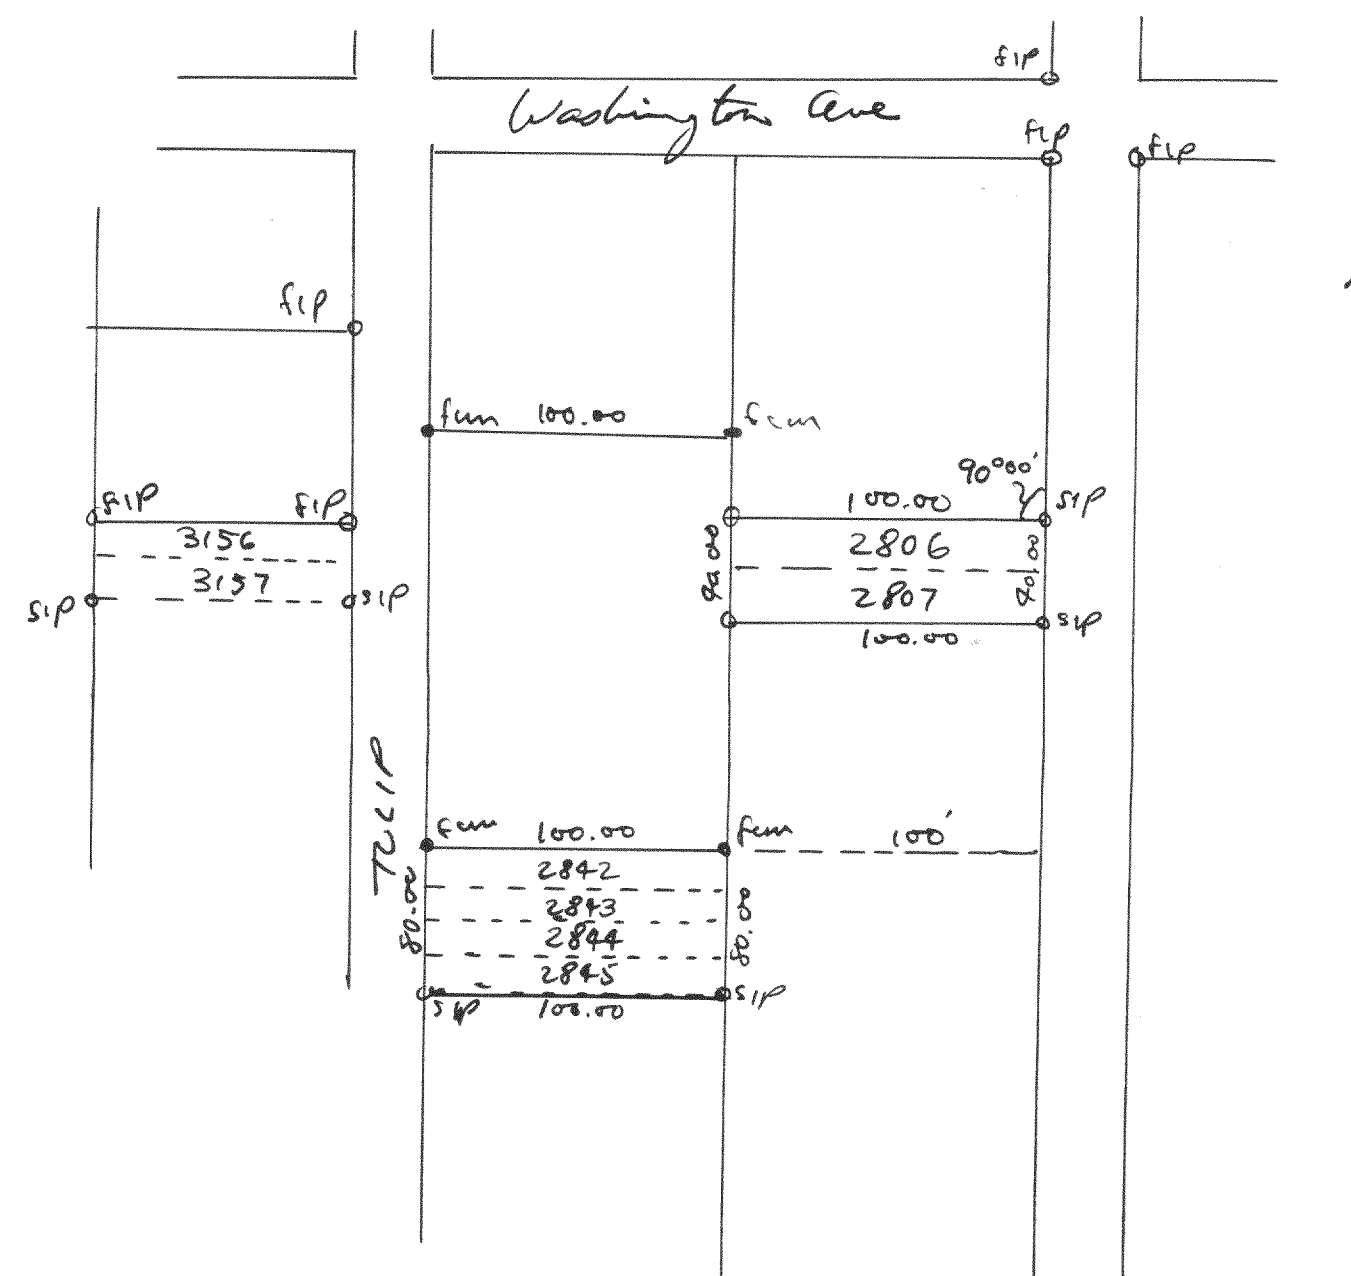

Plot of survey of fols 3156-7, 2842-5, 2806-7, Lake County Wash
Subd located in Sec 21 & 22, T2N R1E of Helmer County, Wyo.
Aug 28, 1950
Floyd S. Jensen
County Surveyor