



2260

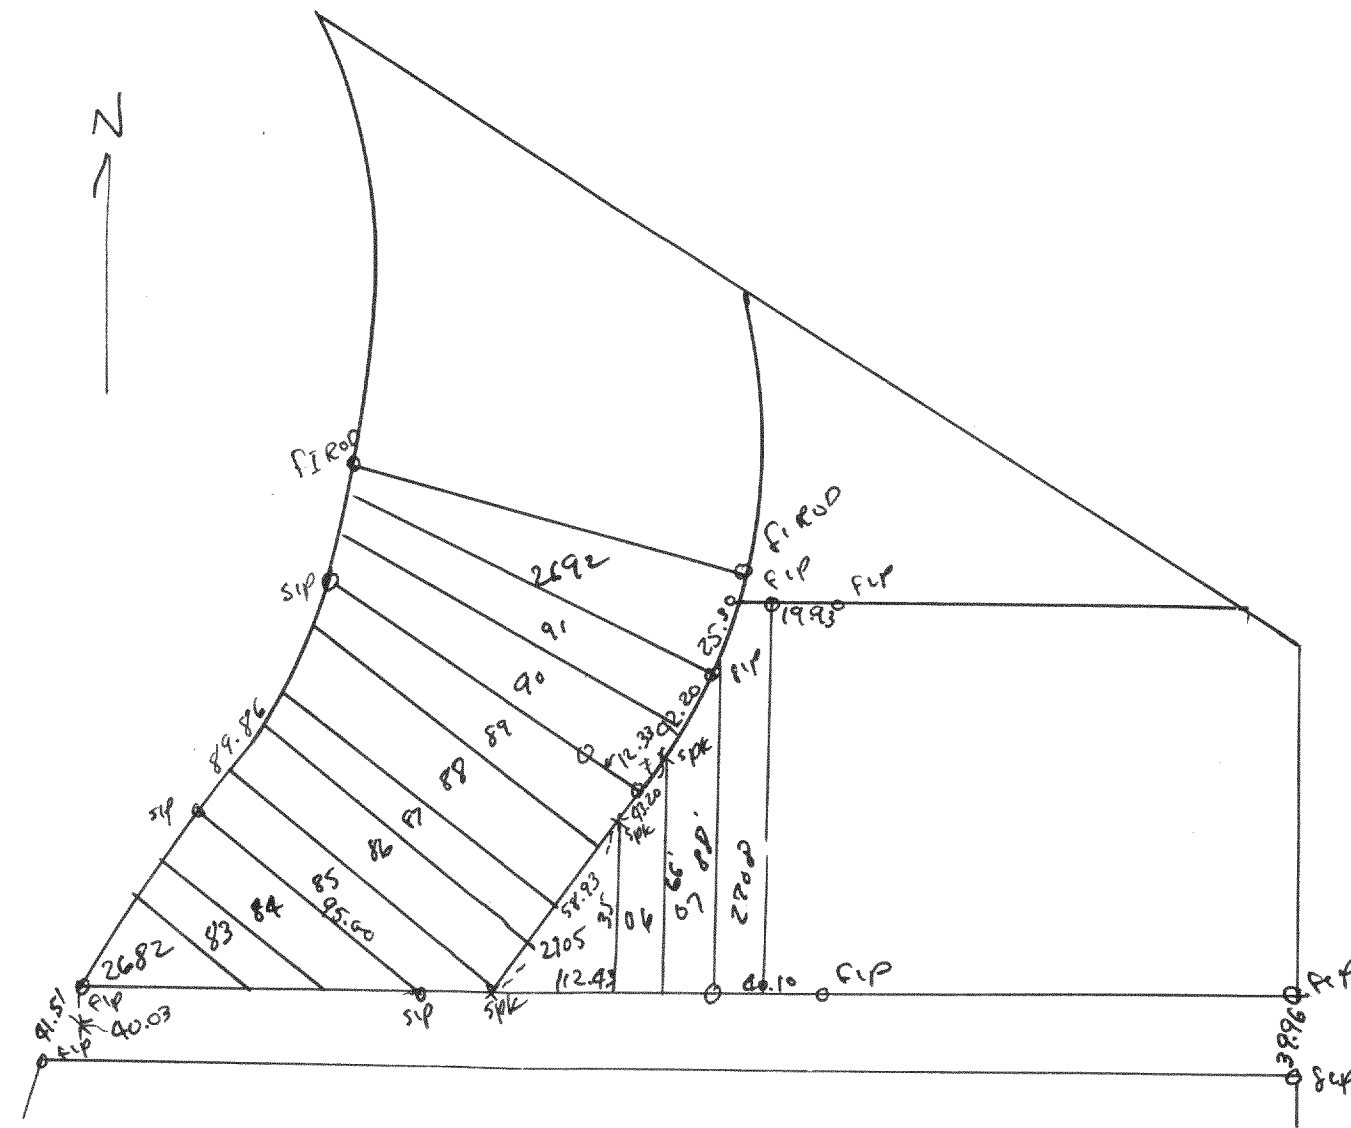

Plat of survey of lots 2685-2689, 2705-2707 Pell Lake Subdivision located in Sec 15 & 22, T14N R18E of Walworth County, Wis.
Sept 26, 1950


Lloyd S. Jensen
County Surveyor

2261

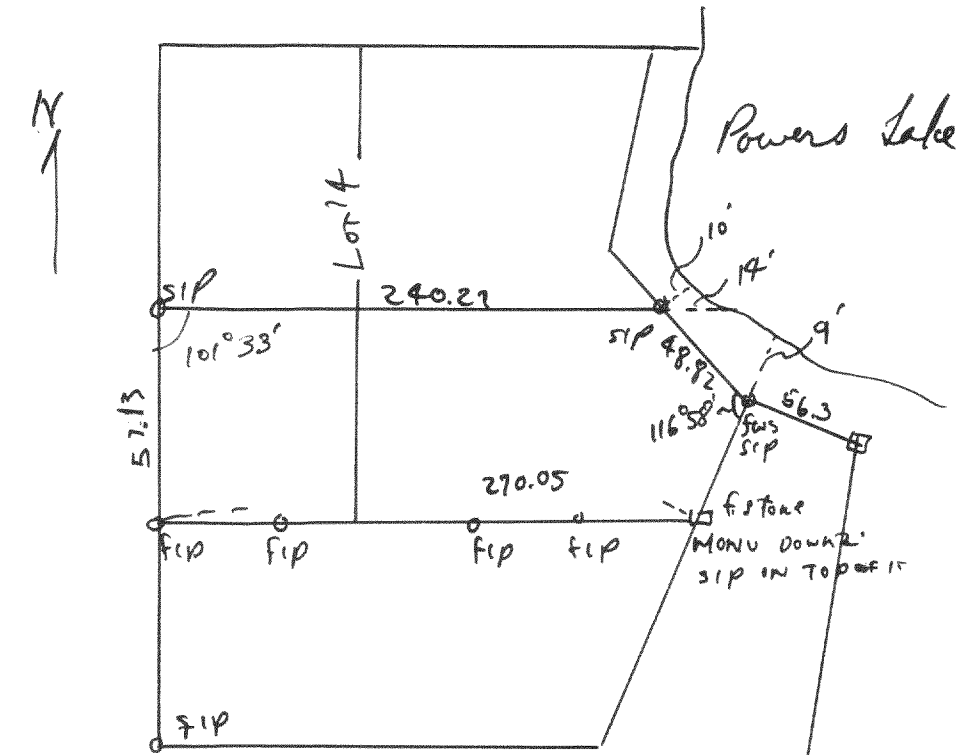

Plat of survey of part of lot 18 of W^m Elliot Subd located at Powers Lake in Sec. 13, T14N R18E, Walworth County, Wis.
Sept 29, 1950
Lloyd S. Jensen
County Surveyor

2262

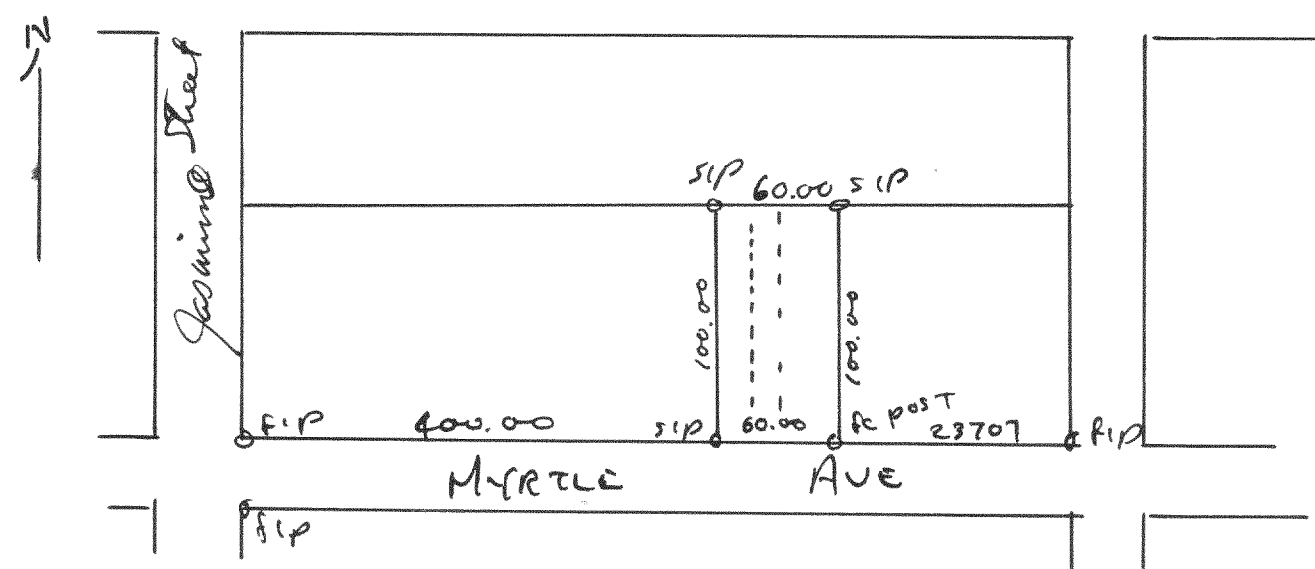

Plat of survey of lots 3441-3443 Pell Lake Subdivision located in Sec 15 & 22, T14N R18E of Walworth County, Wis.
Nov 28, 1950
Lloyd S. Jensen
County Surveyor