



2266

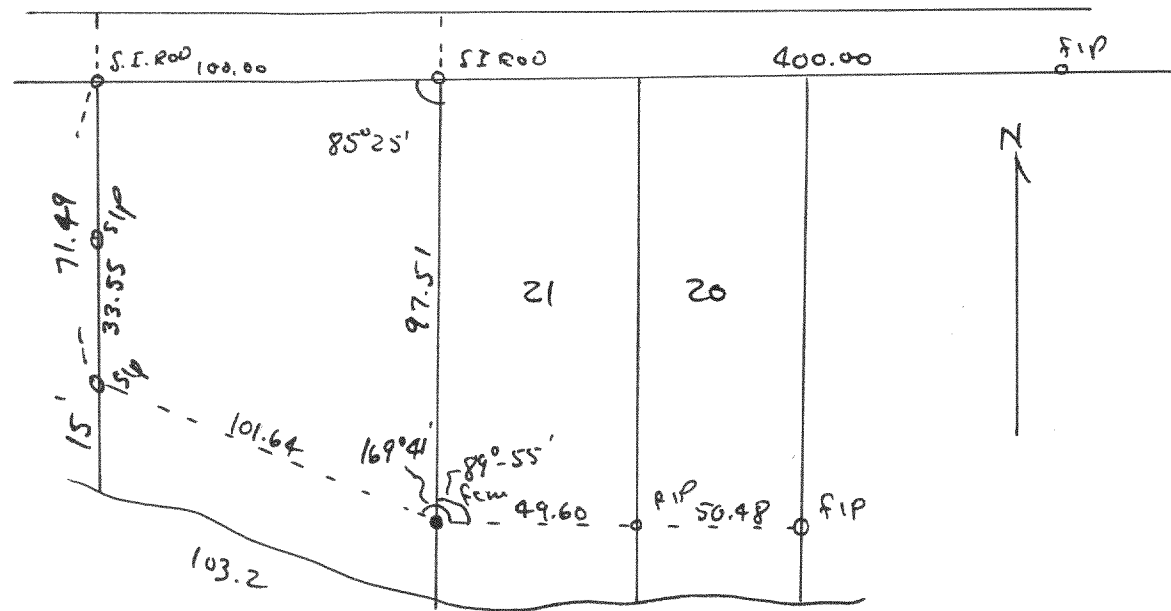


Plat of survey of a parcel of land owned by Stein & located at the west end of Freueks 2nd Subd in Sec 18, T4N R18E of Walworth County, Wis.
May 5, 1950
Hoyd S. Jensen
County Surveyor

2267

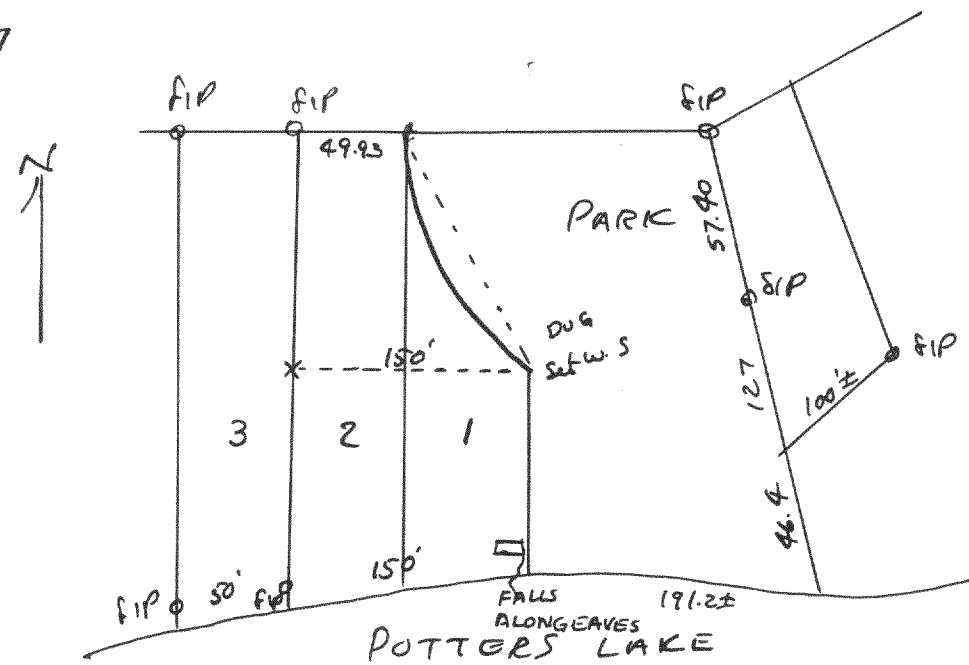


Partial Survey of the Private Park Area located in Miramar Subd in Sections 10 & 11, T4N R18E, Walworth County, Wis.
May 19, 1950
Hoyd S. Jensen
County Surveyor

2268

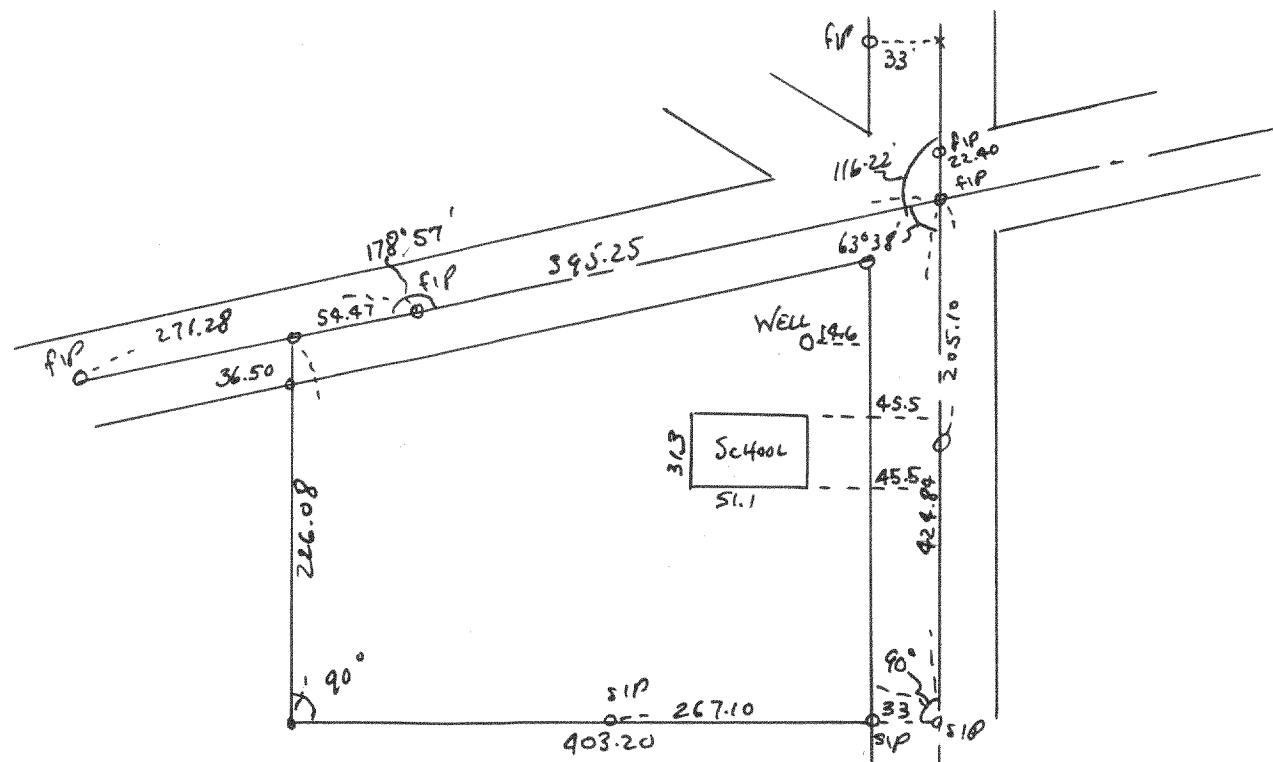

Plat of survey of Lancelot Stone School located in SE 1/4 of SE 1/4 of Sec 11, T4N R18E of Walworth Co., Wis.
Aug 14, 1950
Hoyd S. Jensen
County Surveyor

2269

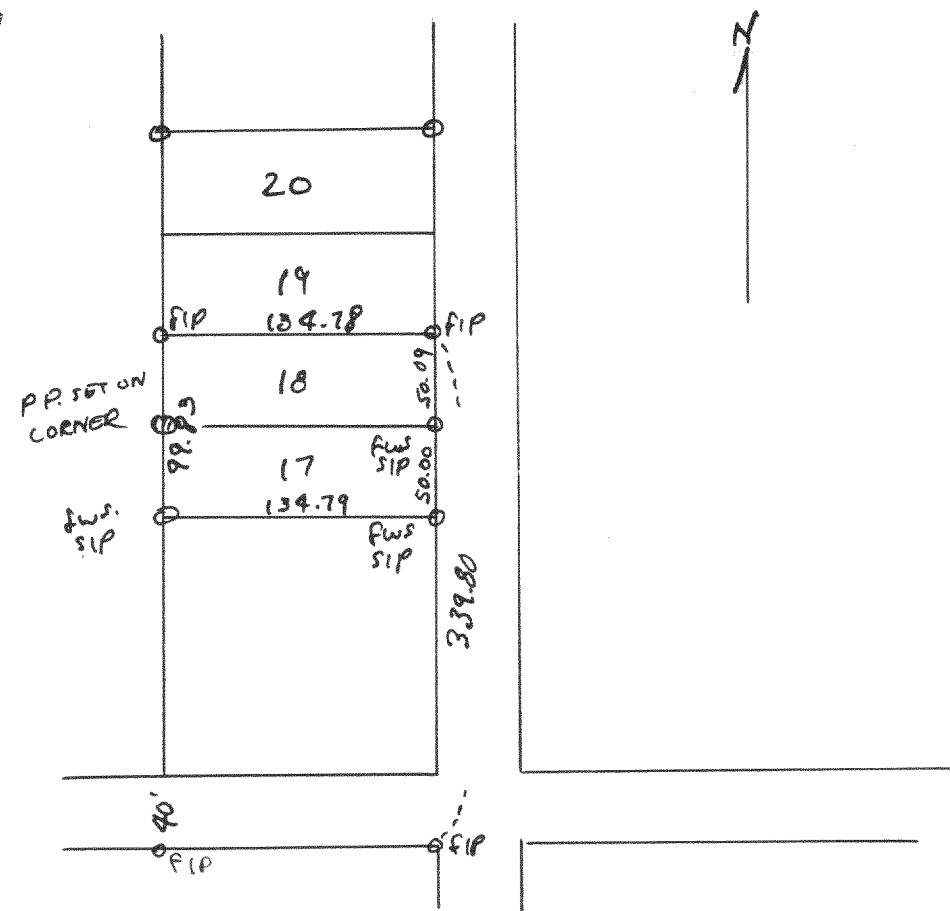

Plat of Survey of Lot 17, Blk 13, Miramar Subd in Sections 10 & 11, T4N R18E, Walworth County, Wisconsin
Sept 12, 1950
Hoyd S. Jensen
County Surveyor