


SURVEY NO. 1277

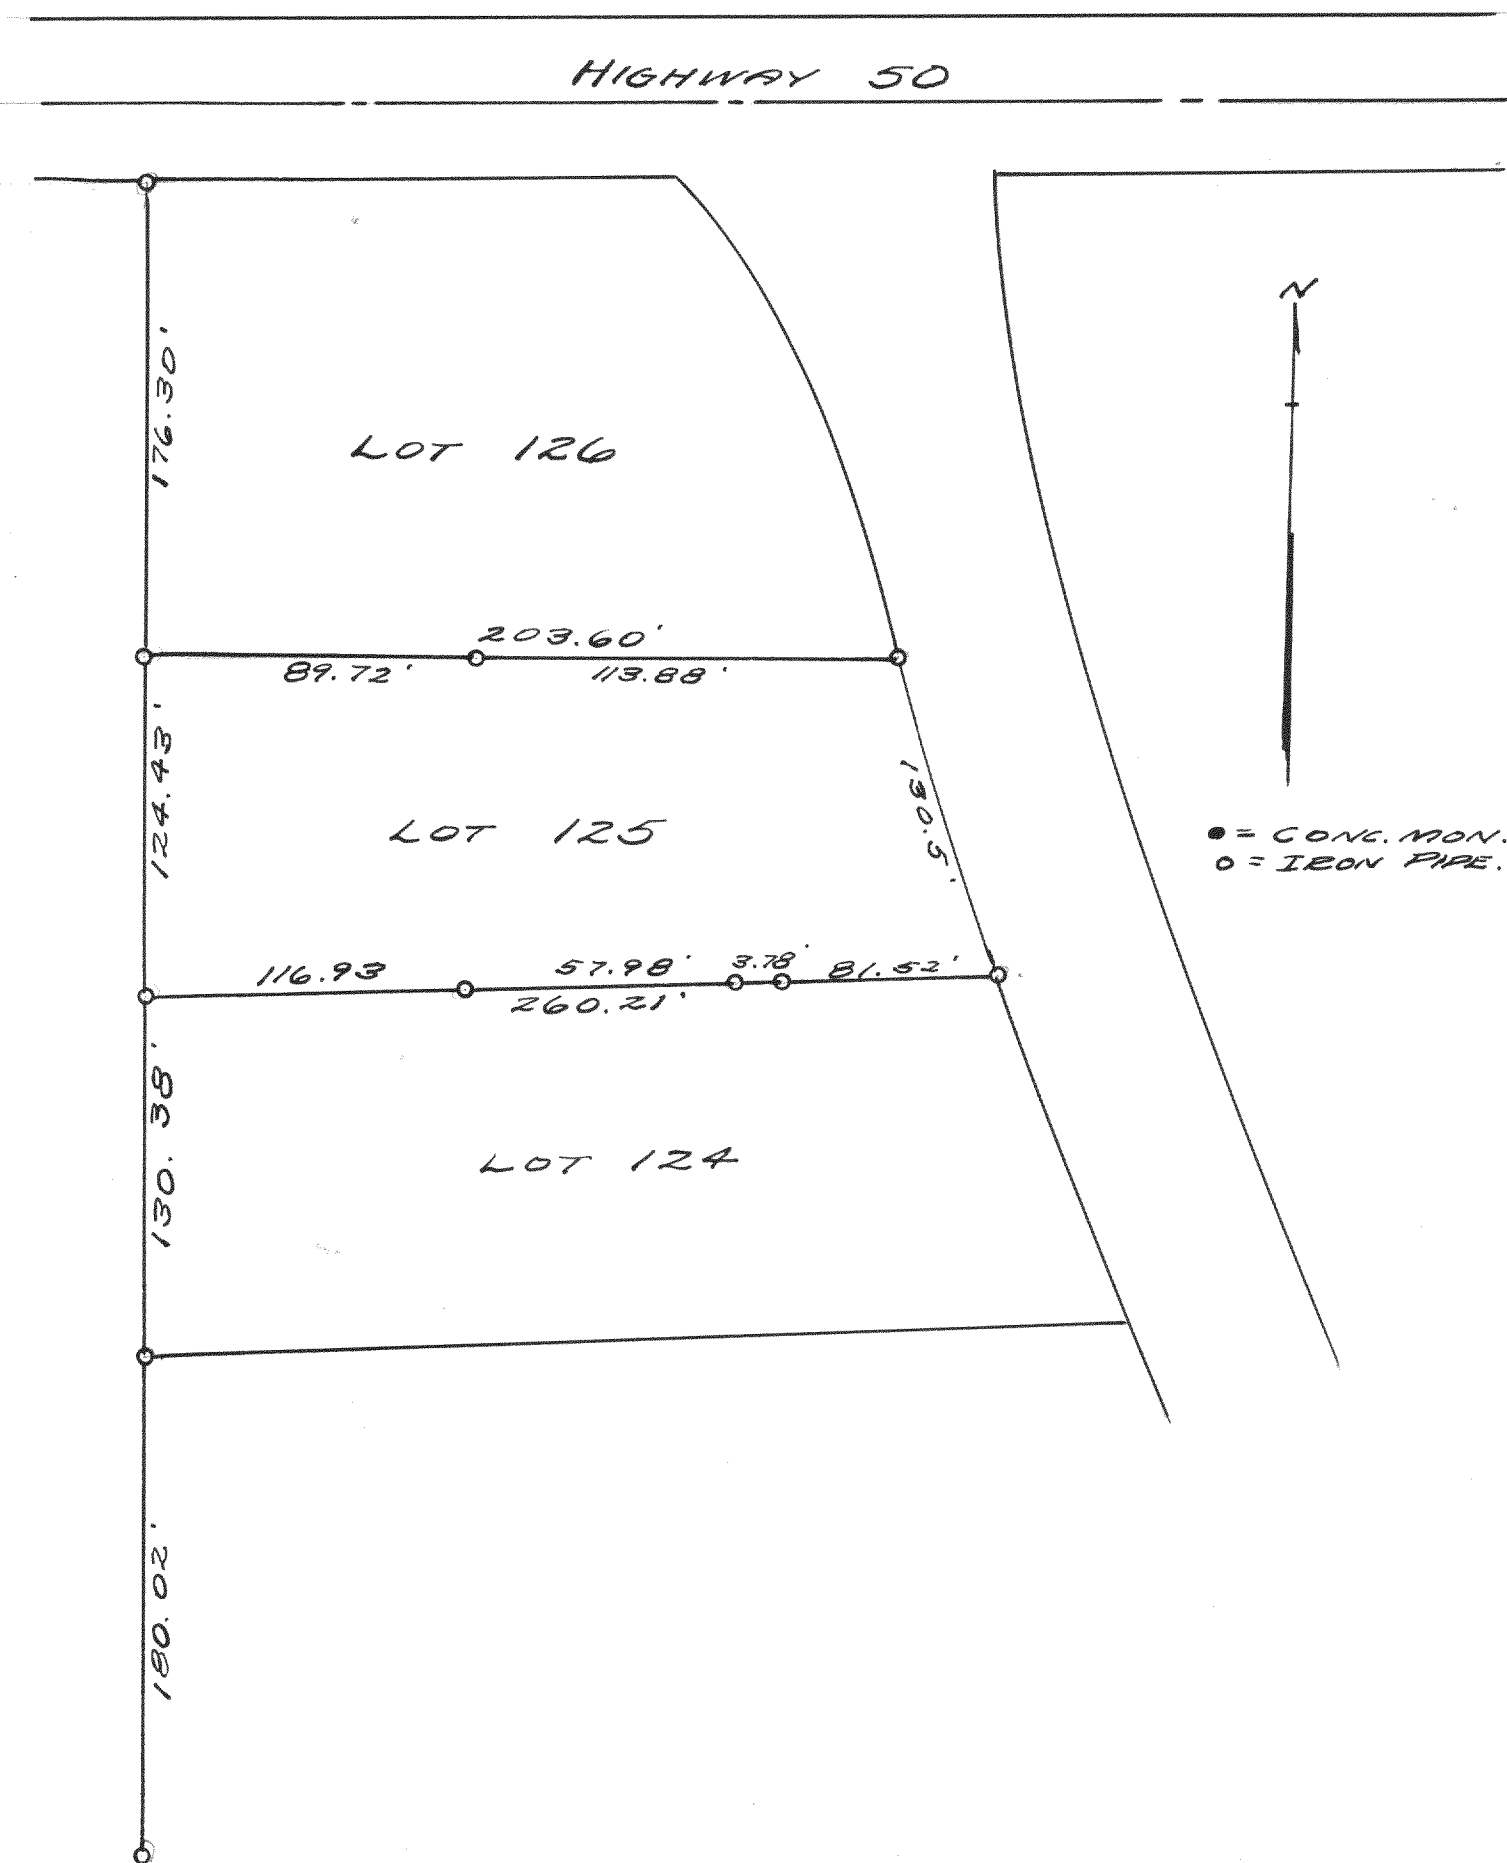


PLAT OF SURVEY OF LOT 125 OF GRAND
TERRACE SUBDIVISION IN THE VILLAGE OF
WILLIAMS BAY, WALWORTH COUNTY, WISC.

JAN. 14, 1942

Lloyd L. Jensen
K.E.J.

SURVEY NO. 1278

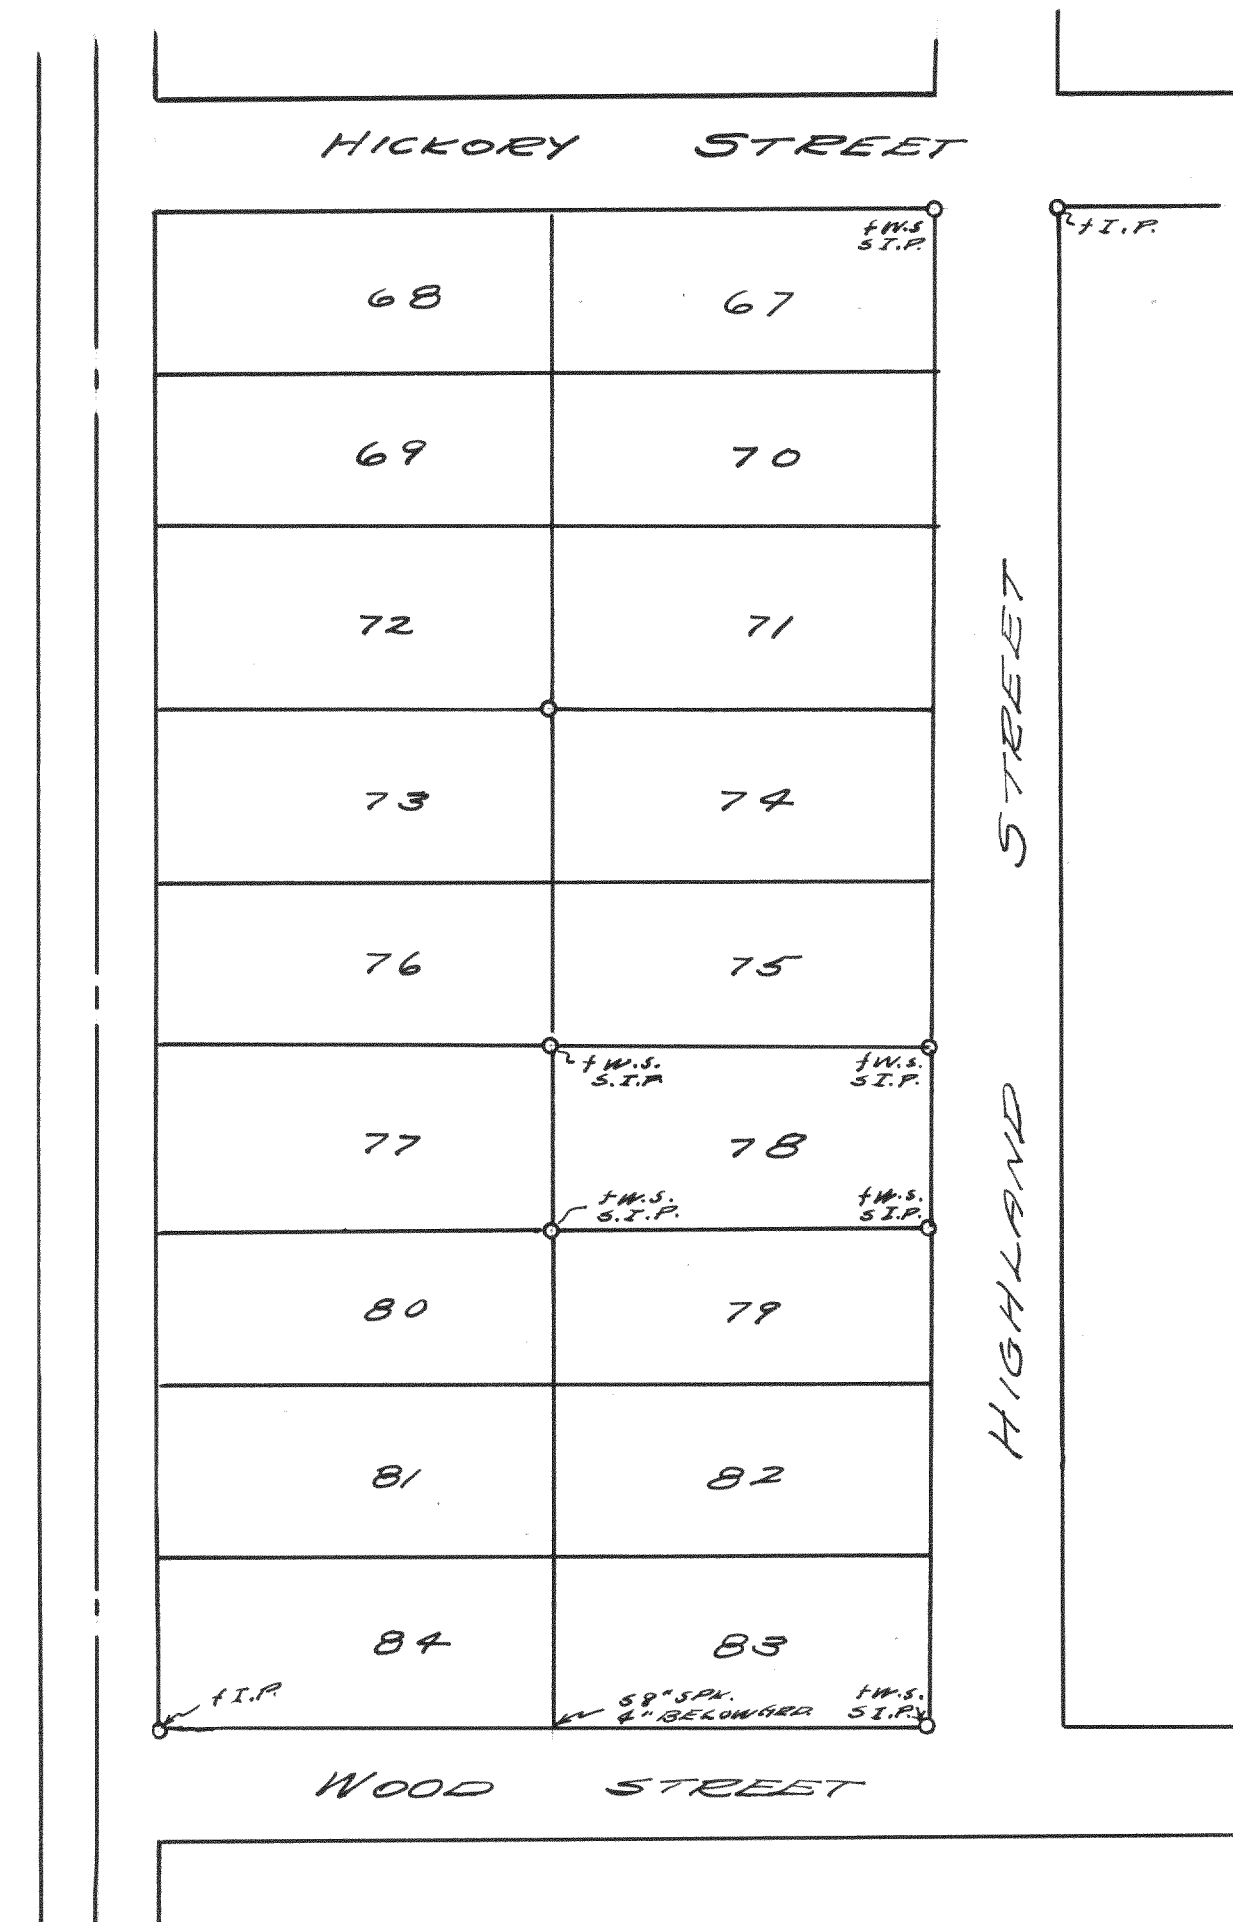

PLAT OF SURVEY OF LOT 78 OF BAY
VIEW SUBDIVISION, IN THE VILLAGE OF
WILLIAMS BAY, WALWORTH CO., WISC.

JULY, 1941

Lloyd L. Jensen
K.E.J.