



#2277

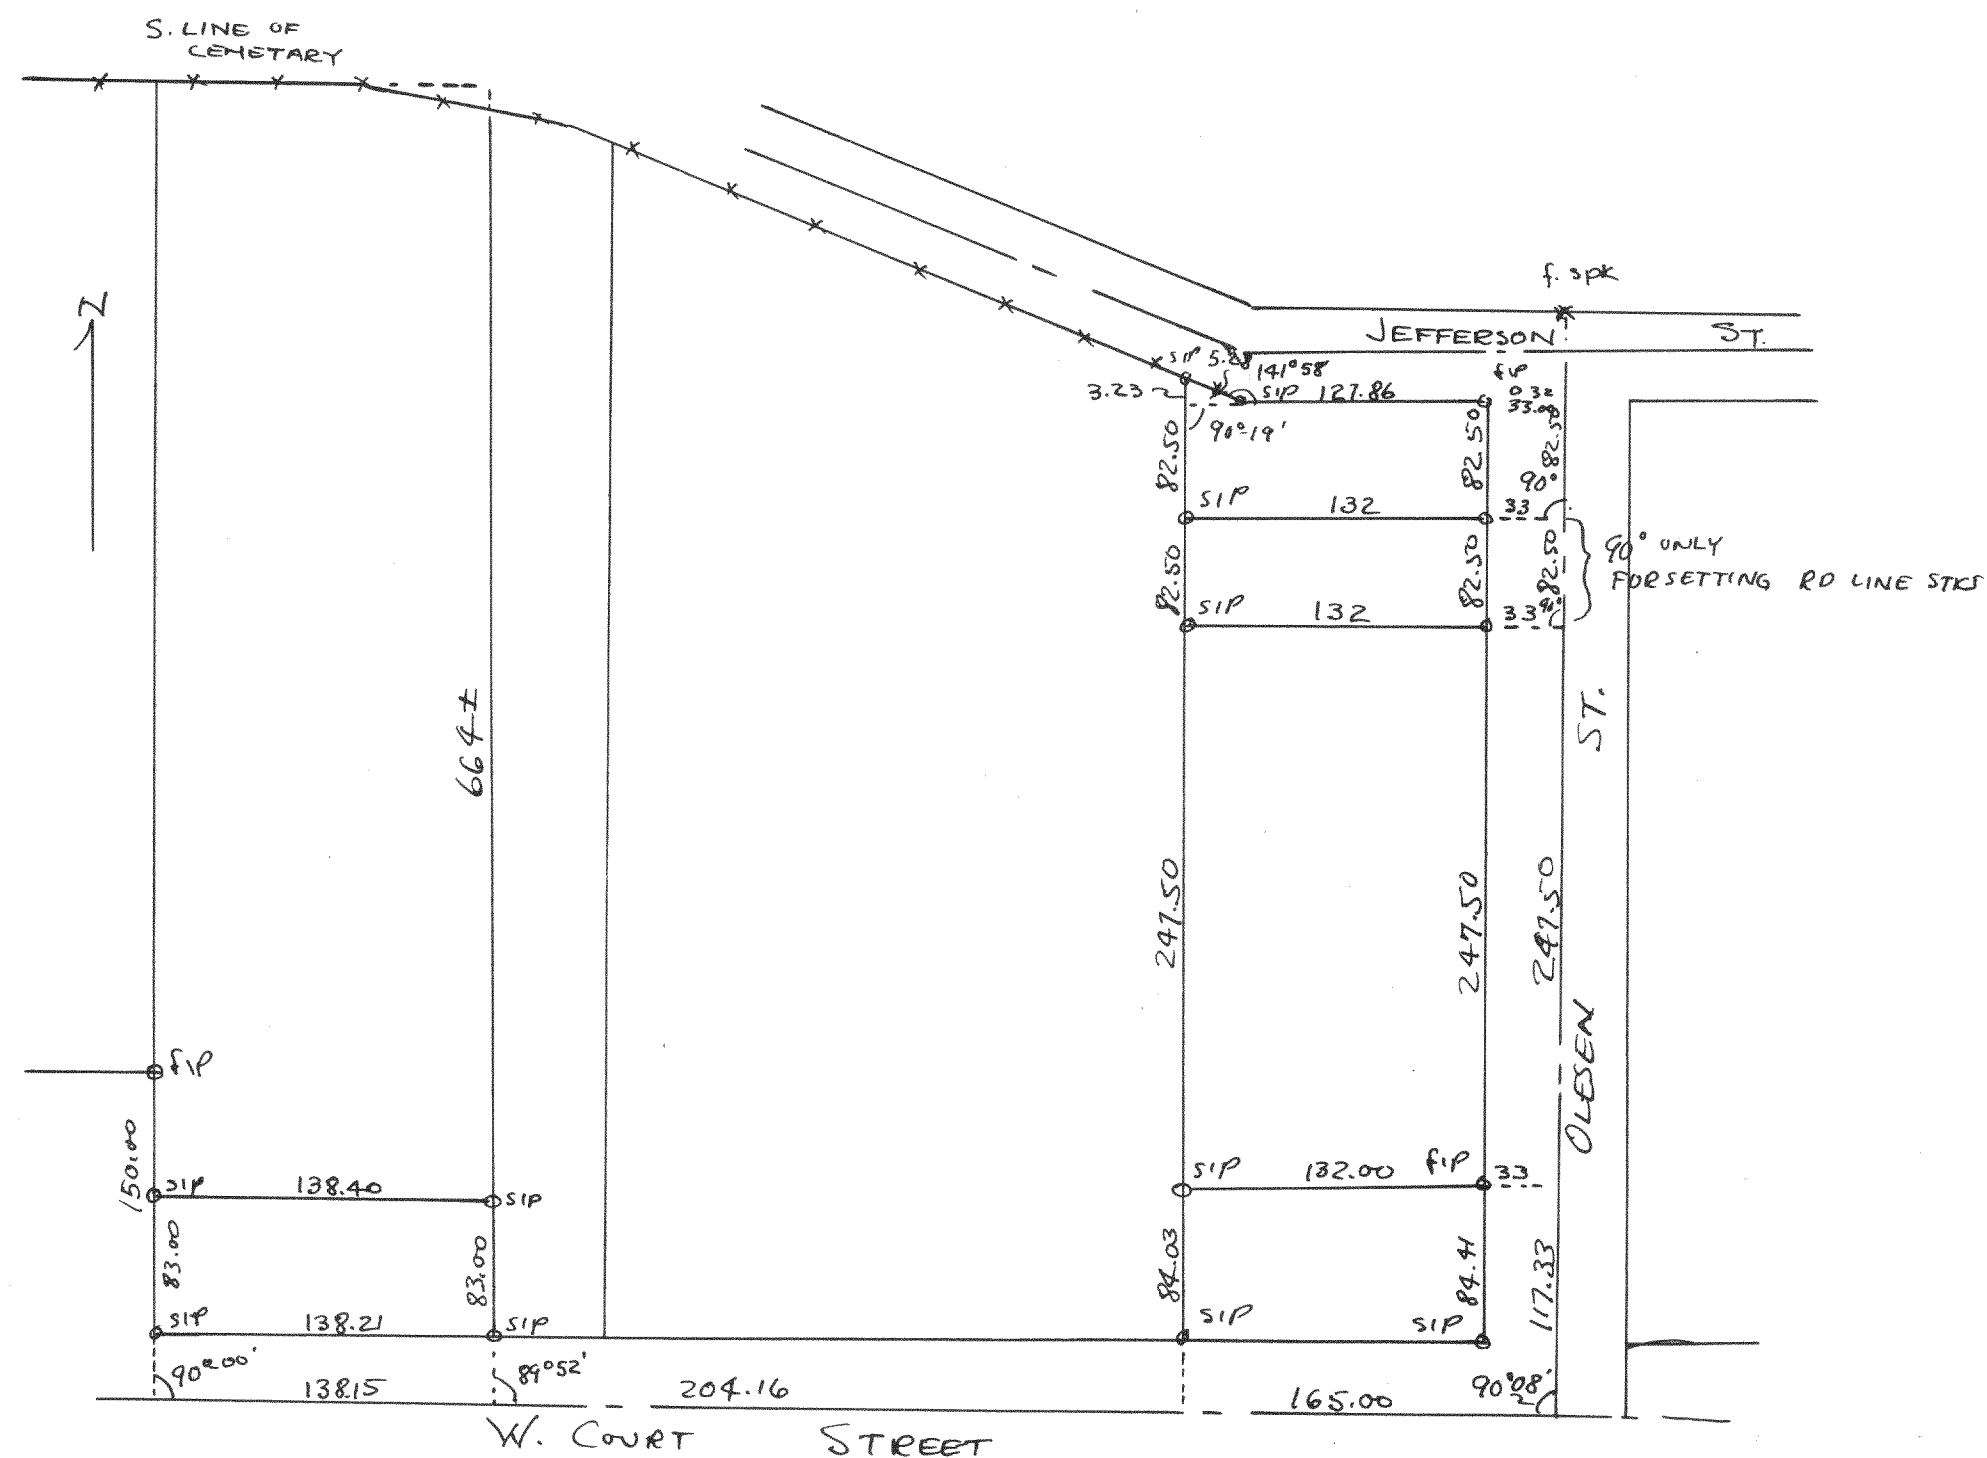

Plot of survey of parcels of land for Karamoski located in
the City of Elkhorn, Walworth County, Wisconsin
July 25, 1950
Lloyd S. Jensen
County Surveyor

2278

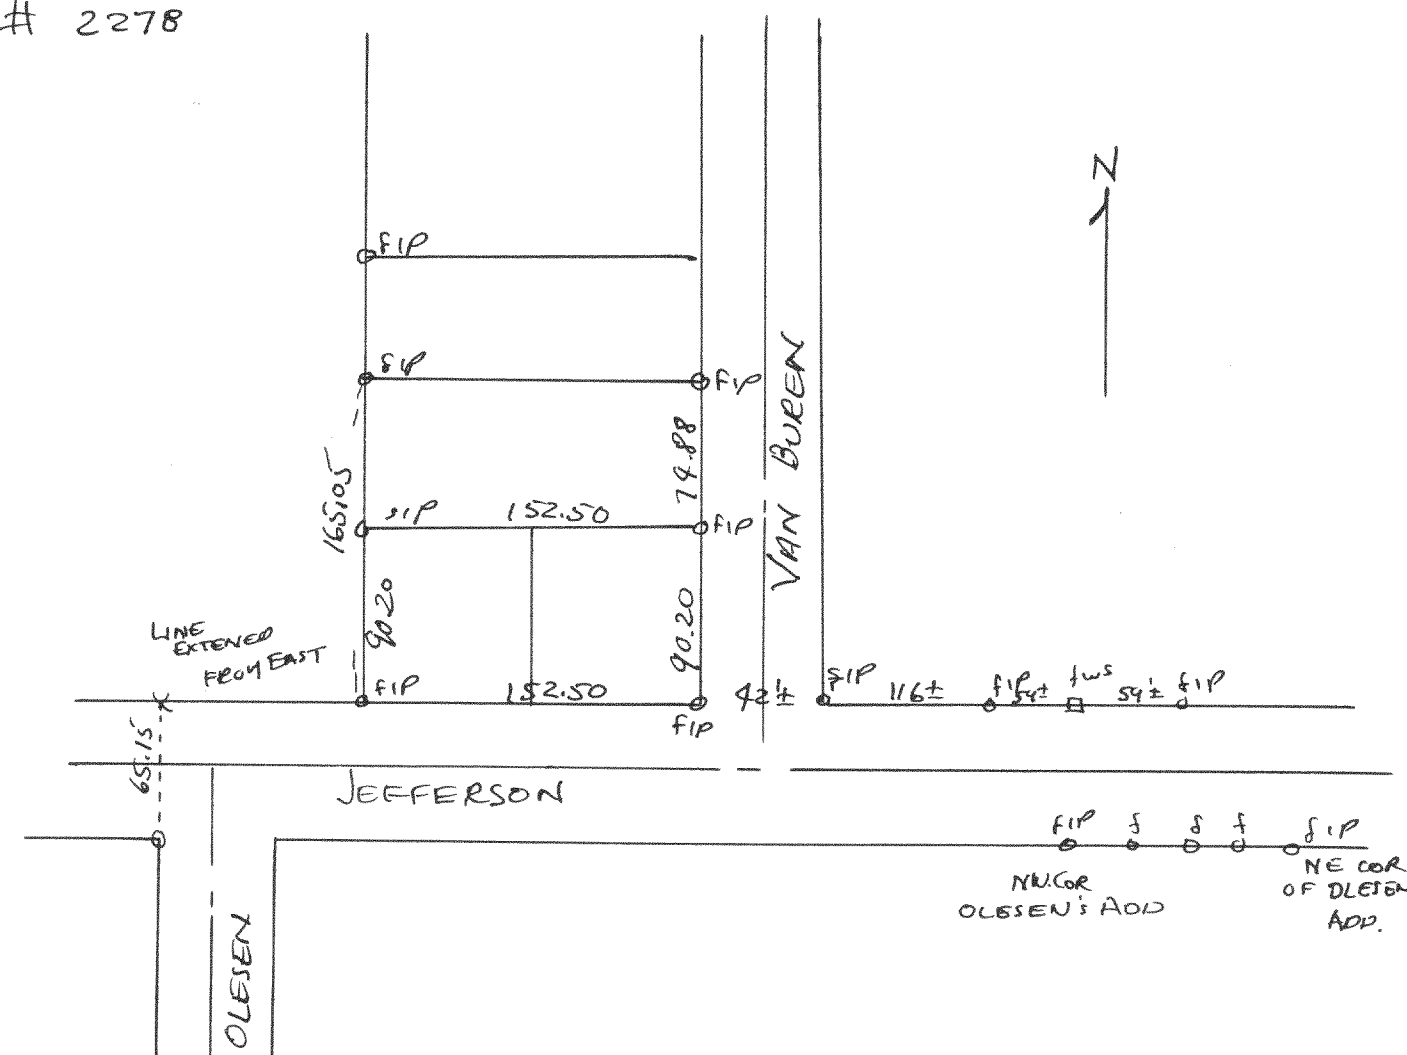

Plot of survey of Cooper land located in SE 1/4 Sec 36
T3N R16E City of Elkhorn, Walworth County, Wis.
July 25, 1950
Lloyd S. Jensen
County Surveyor