



#2281

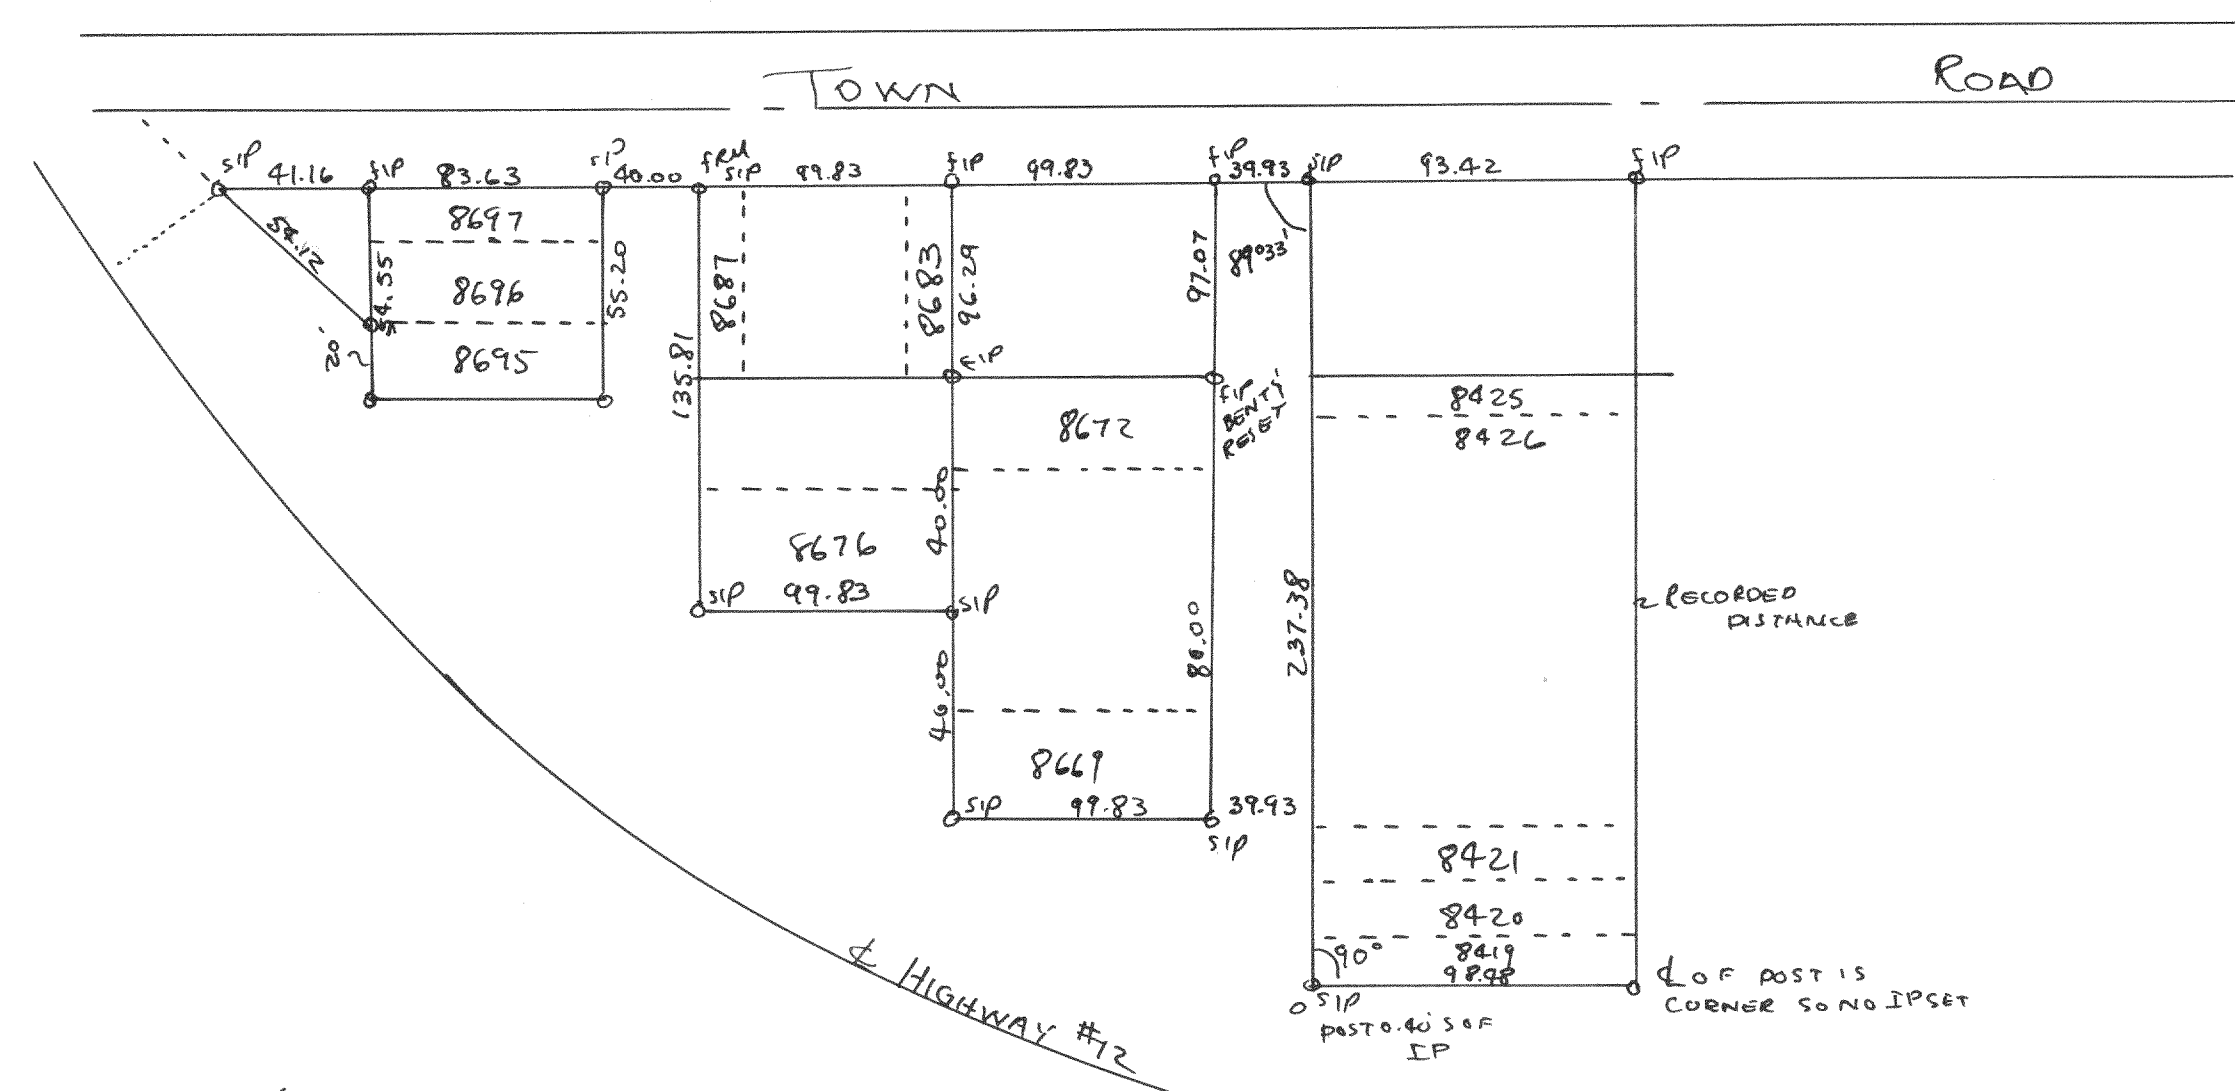

Plot of survey of lots 8695-7, 8676-7, 8683-7, 8669-72
 8419-8430 of Lake Como Beach Subd. located in Section 21-2-22
 T2N R17E of Walworth County, Wis. Lloyd S. Jensen
 Aug 28, 1950 County Surveyor

#2282

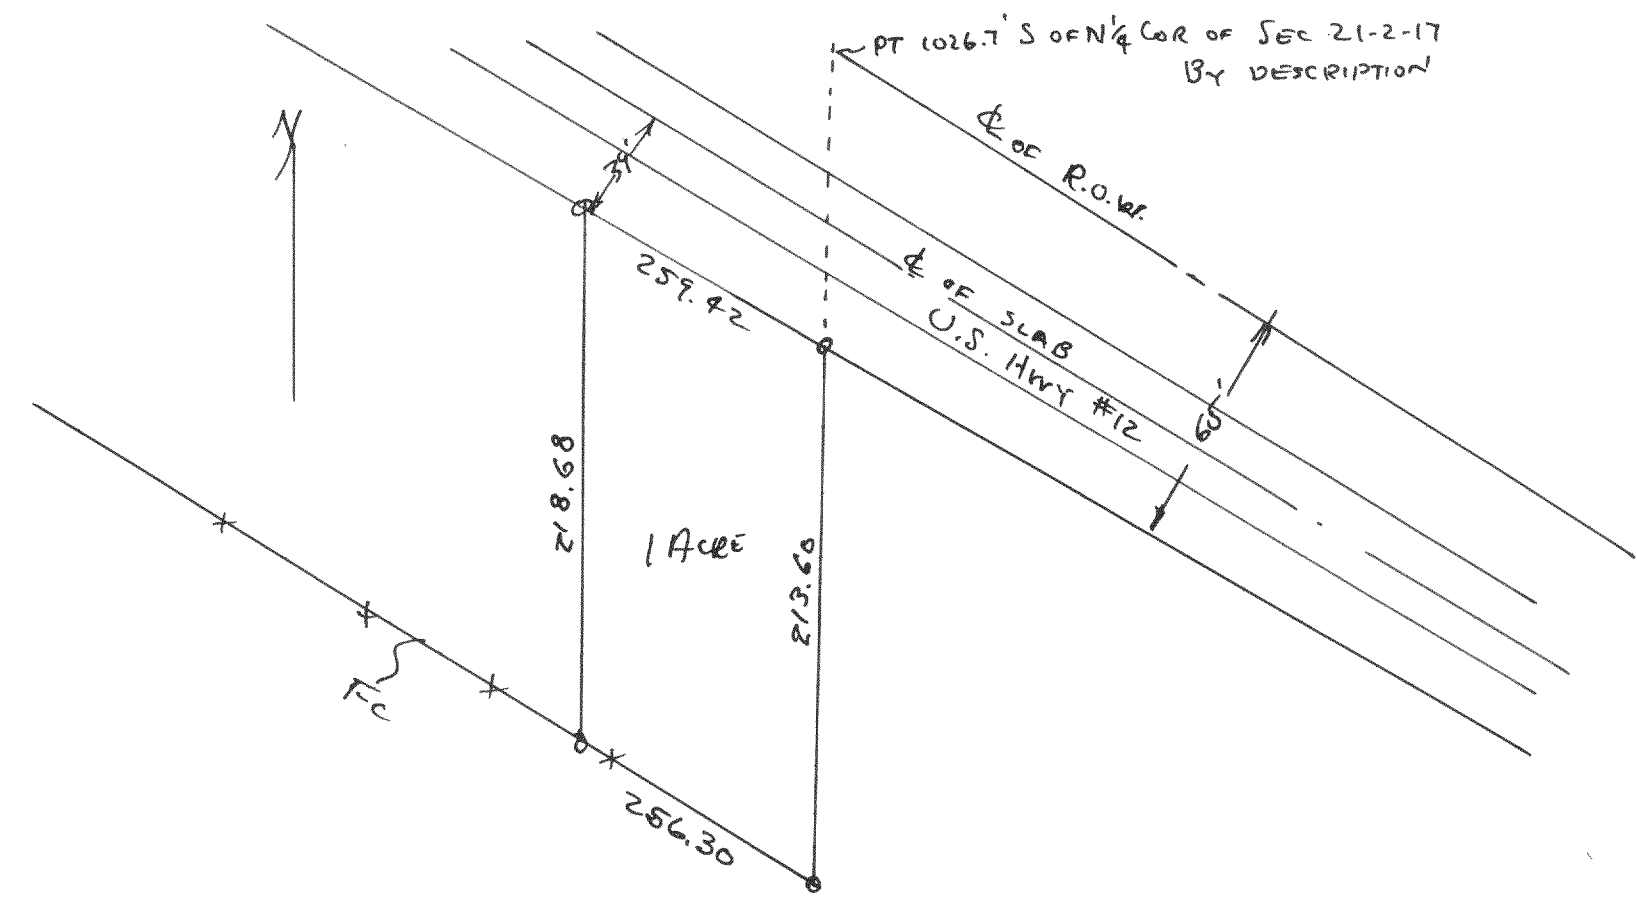

Plot of survey of a 1 acre parcel of land located in the NW 1/4 of
 Sec 21, T2N R17E, Walworth County, Wis.
 Aug 3, 1950 Lloyd S. Jensen
 County Surveyor