



#2287

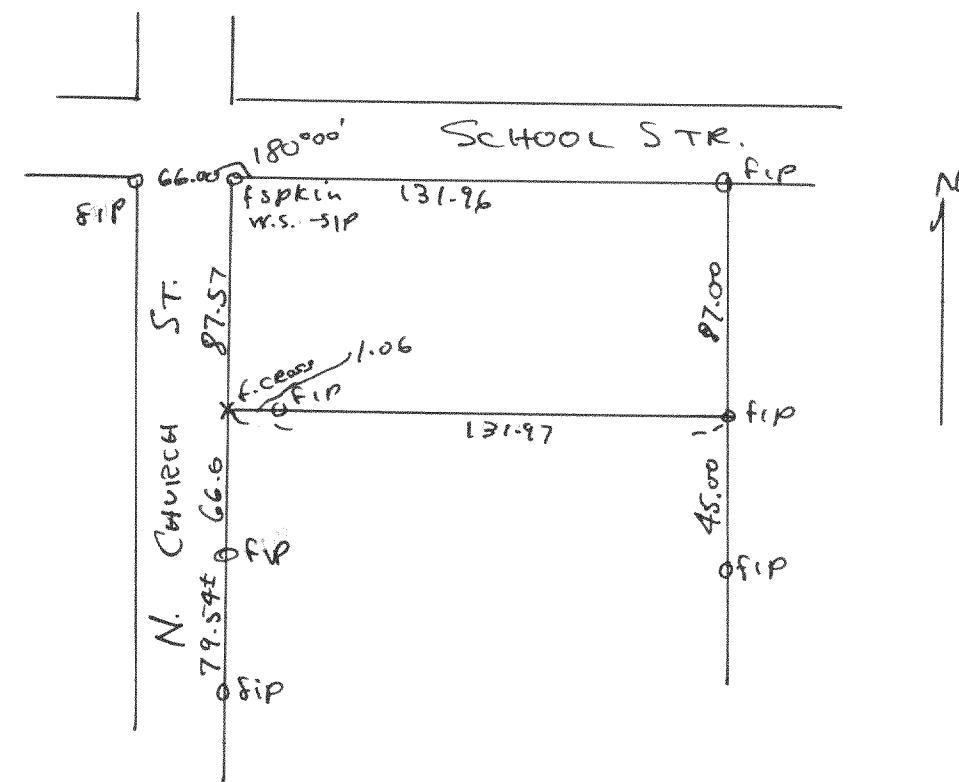

Plat of survey of part of Lot 2, Blk 5 of the
original town, Village of East Troy, Walworth Co., Wis.
Oct 10, 1950

Lloyd L. Jensen
County Surveyor


#2289

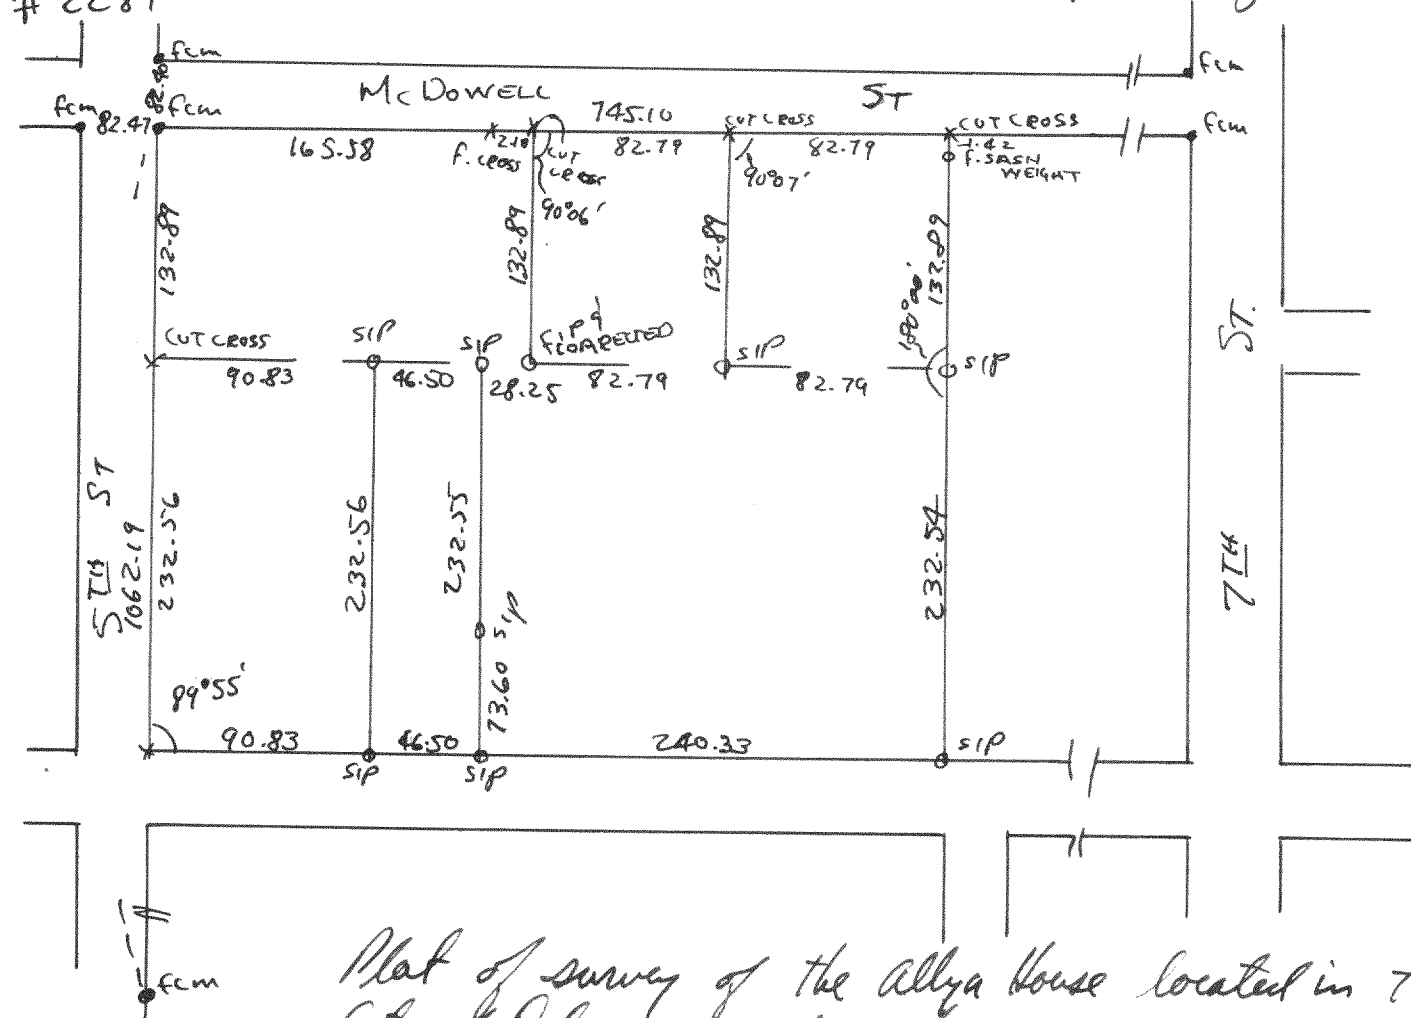

Plat of survey of the Allya House located in The
City of Delavan, Walworth Wisconsin.
July 14, 1950

Lloyd L. Jensen
County Surveyor

#2288

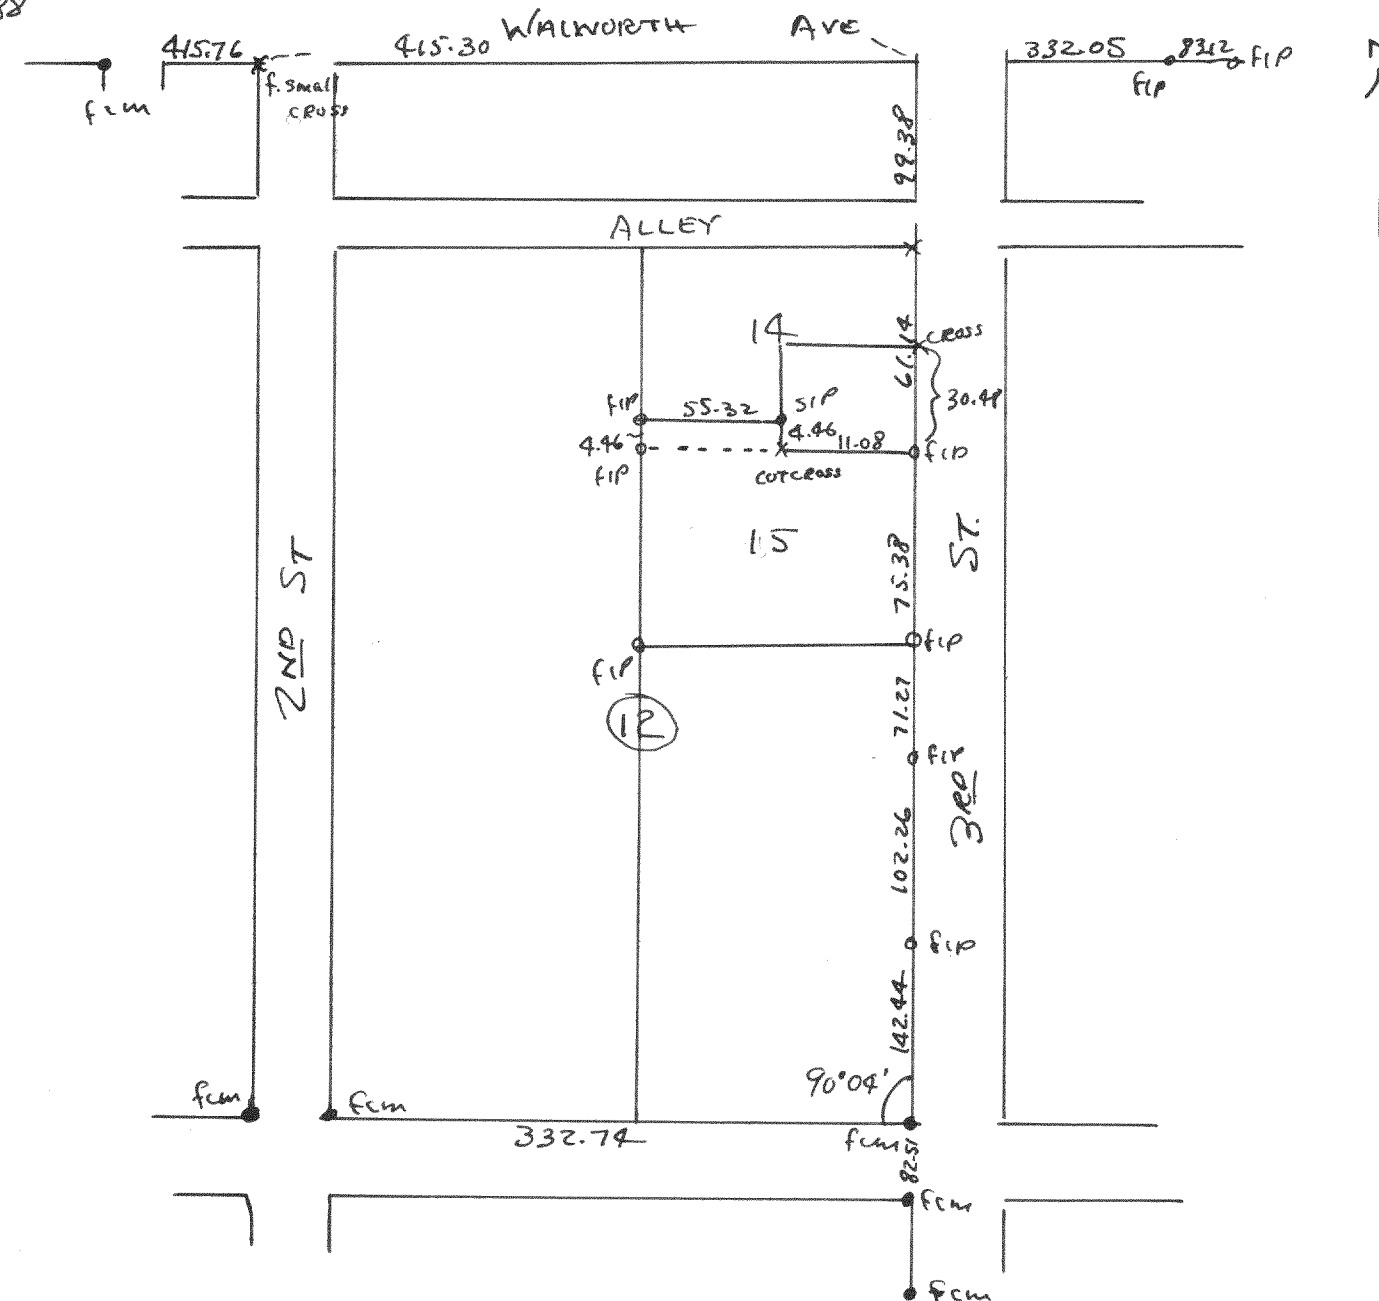

Plat of survey of parts of lots 14 & 15, Block 12 City of Delavan,
Walworth County, Wis.
1950

Lloyd L. Jensen
County Surveyor