



SURVEY 1279

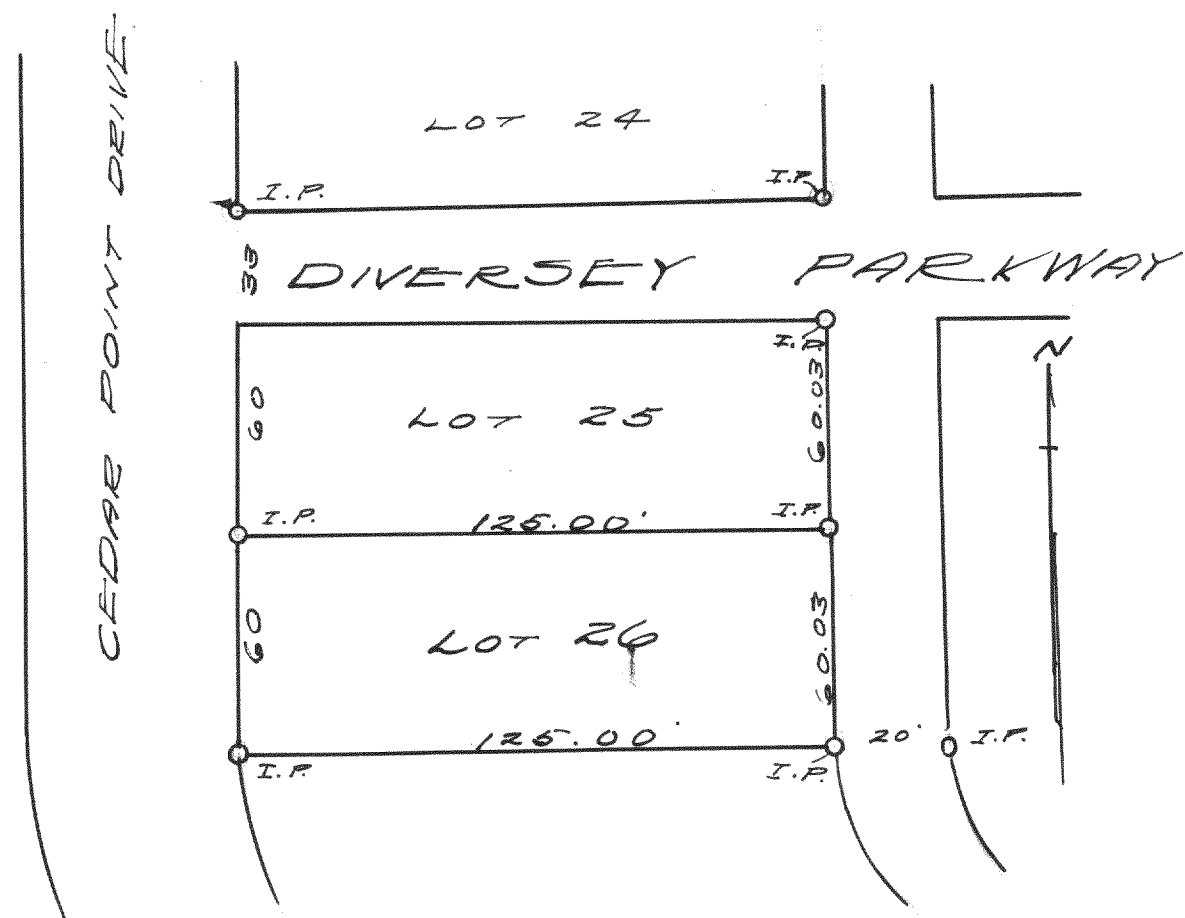

PLAT OF SURVEY OF LOT 26 OF  
CEDAR POINT PARK SUBDIVISION,  
IN THE VILLAGE OF WINS. BAY, WALWORTH  
COUNTY, WISCONSIN  
MARCH 8, 1941

Lloyd L. Jensen  
R.E.C.

SURVEY NO. 1280

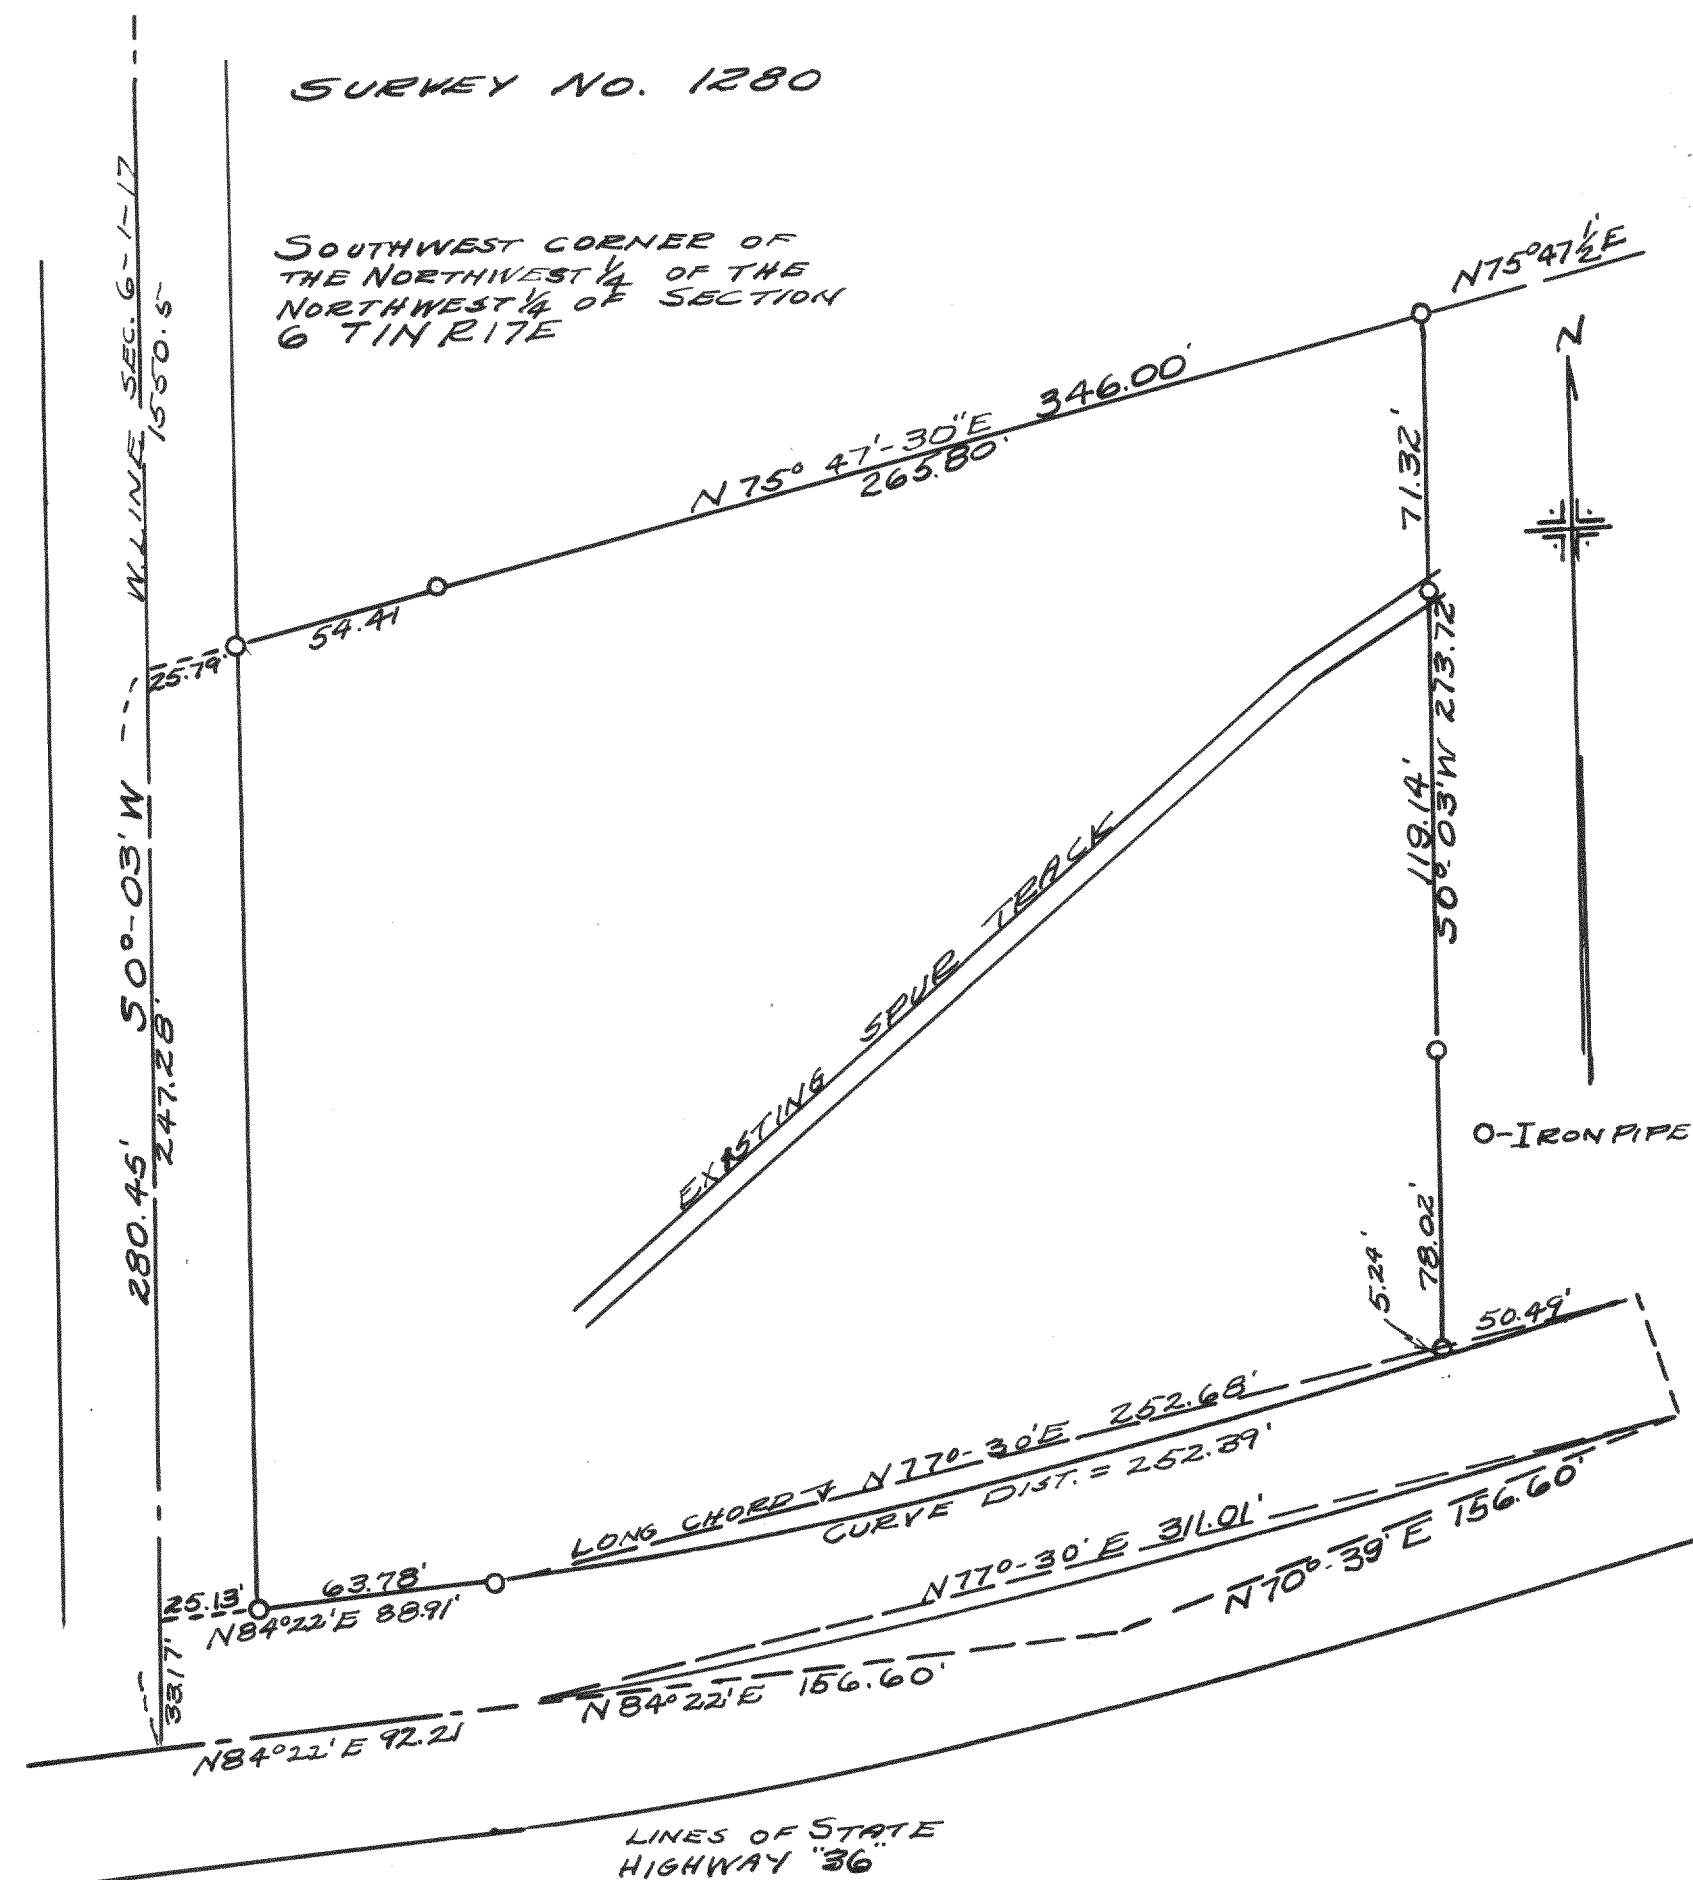

PLAT OF SURVEY OF LAND LOCATED IN THE  
NORTHWEST 1/4 OF SECTION 6 T1N R17E OF  
WALWORTH COUNTY, WISCONSIN  
MARCH 24, 1941

Lloyd L. Jensen  
R.E.C.