



#2292

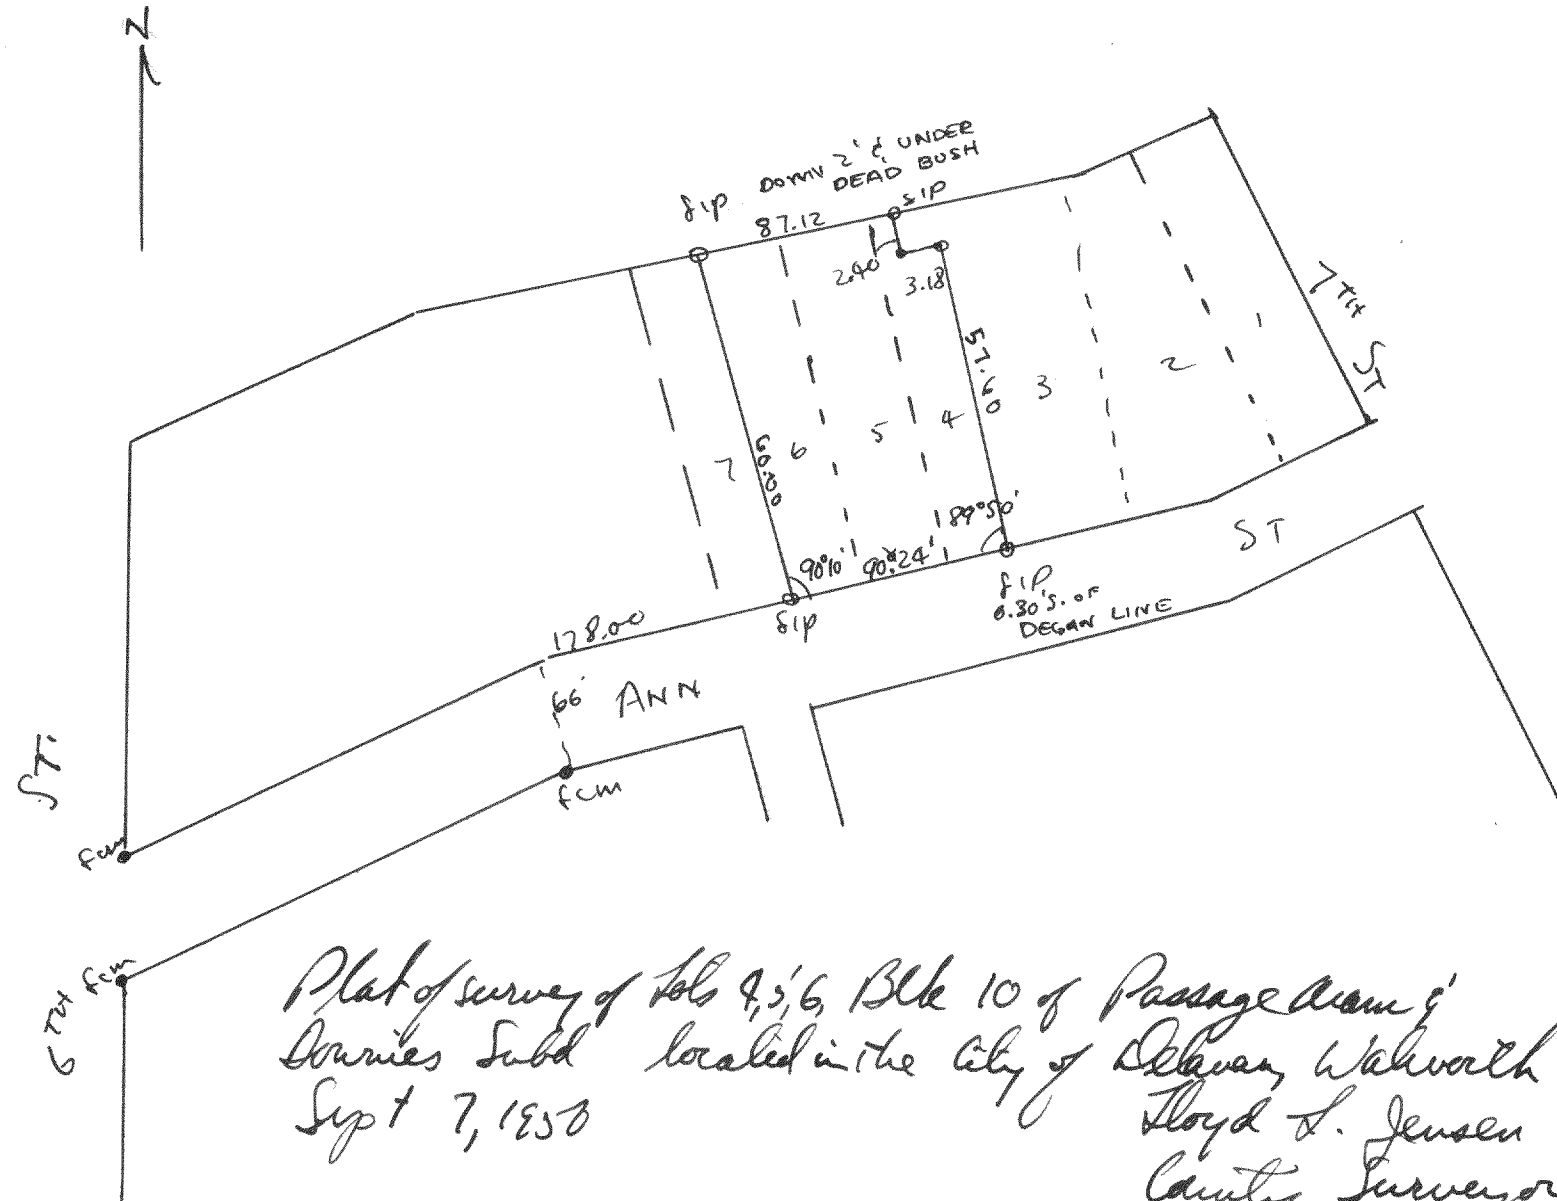


Plat of survey of lots 4, 5, 6, Blk 10 of Passage Acre & Downies Subd. located in the City of Delavan, Walworth Co., Wis.
Sept 7, 1950
Lloyd L. Jensen
County Surveyor

#2294

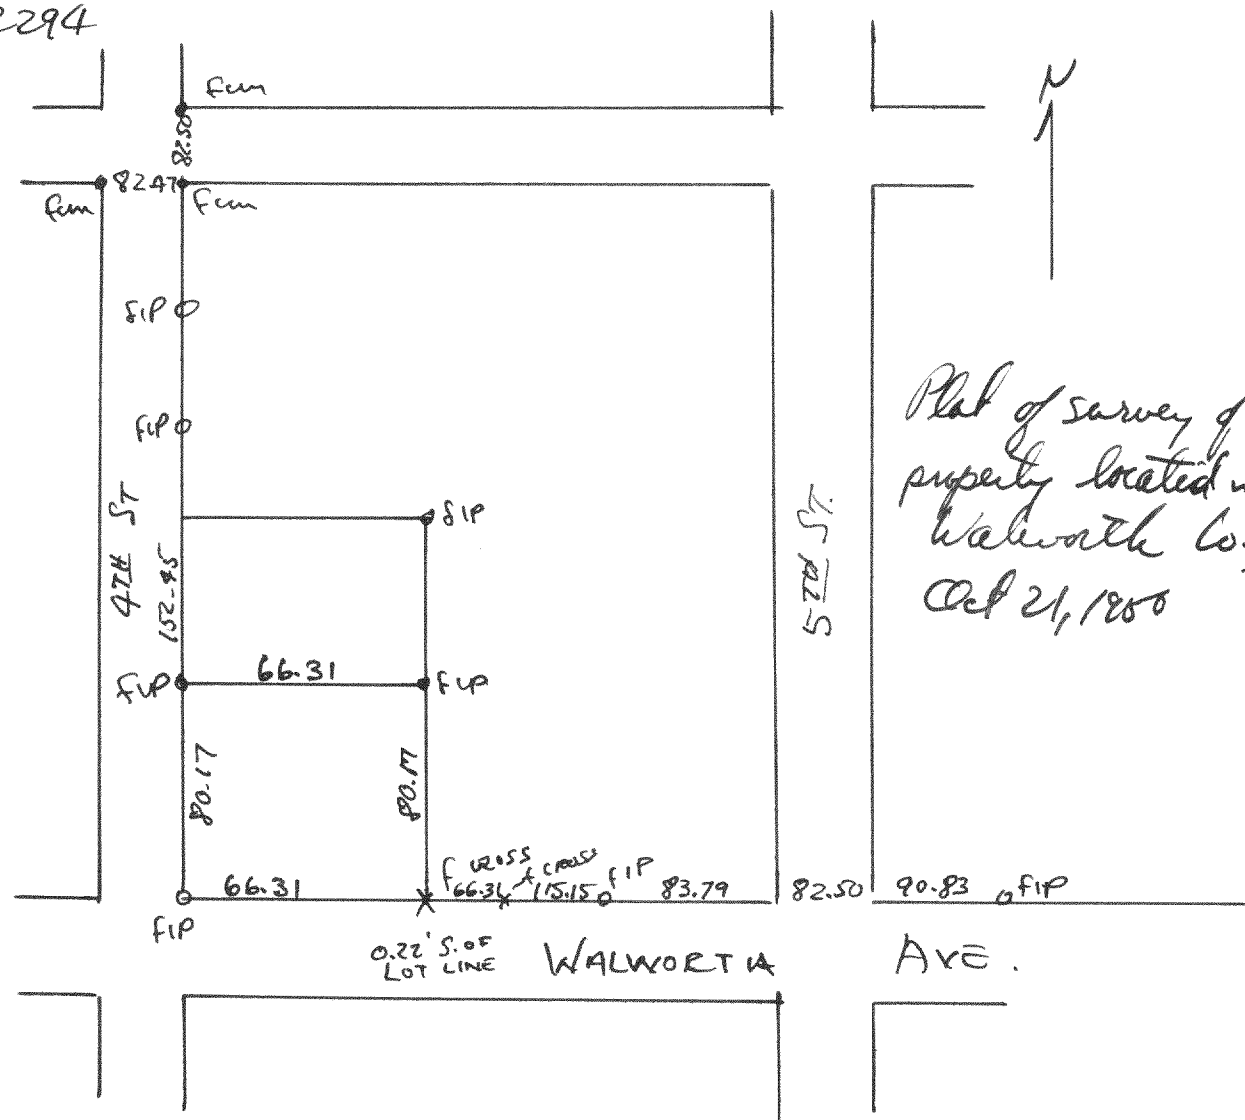

Plat of survey of the Service Oil Station property located in the City of Delavan, Walworth Co., Wis.
Oct 21, 1950
Lloyd L. Jensen
County Surveyor

#2293

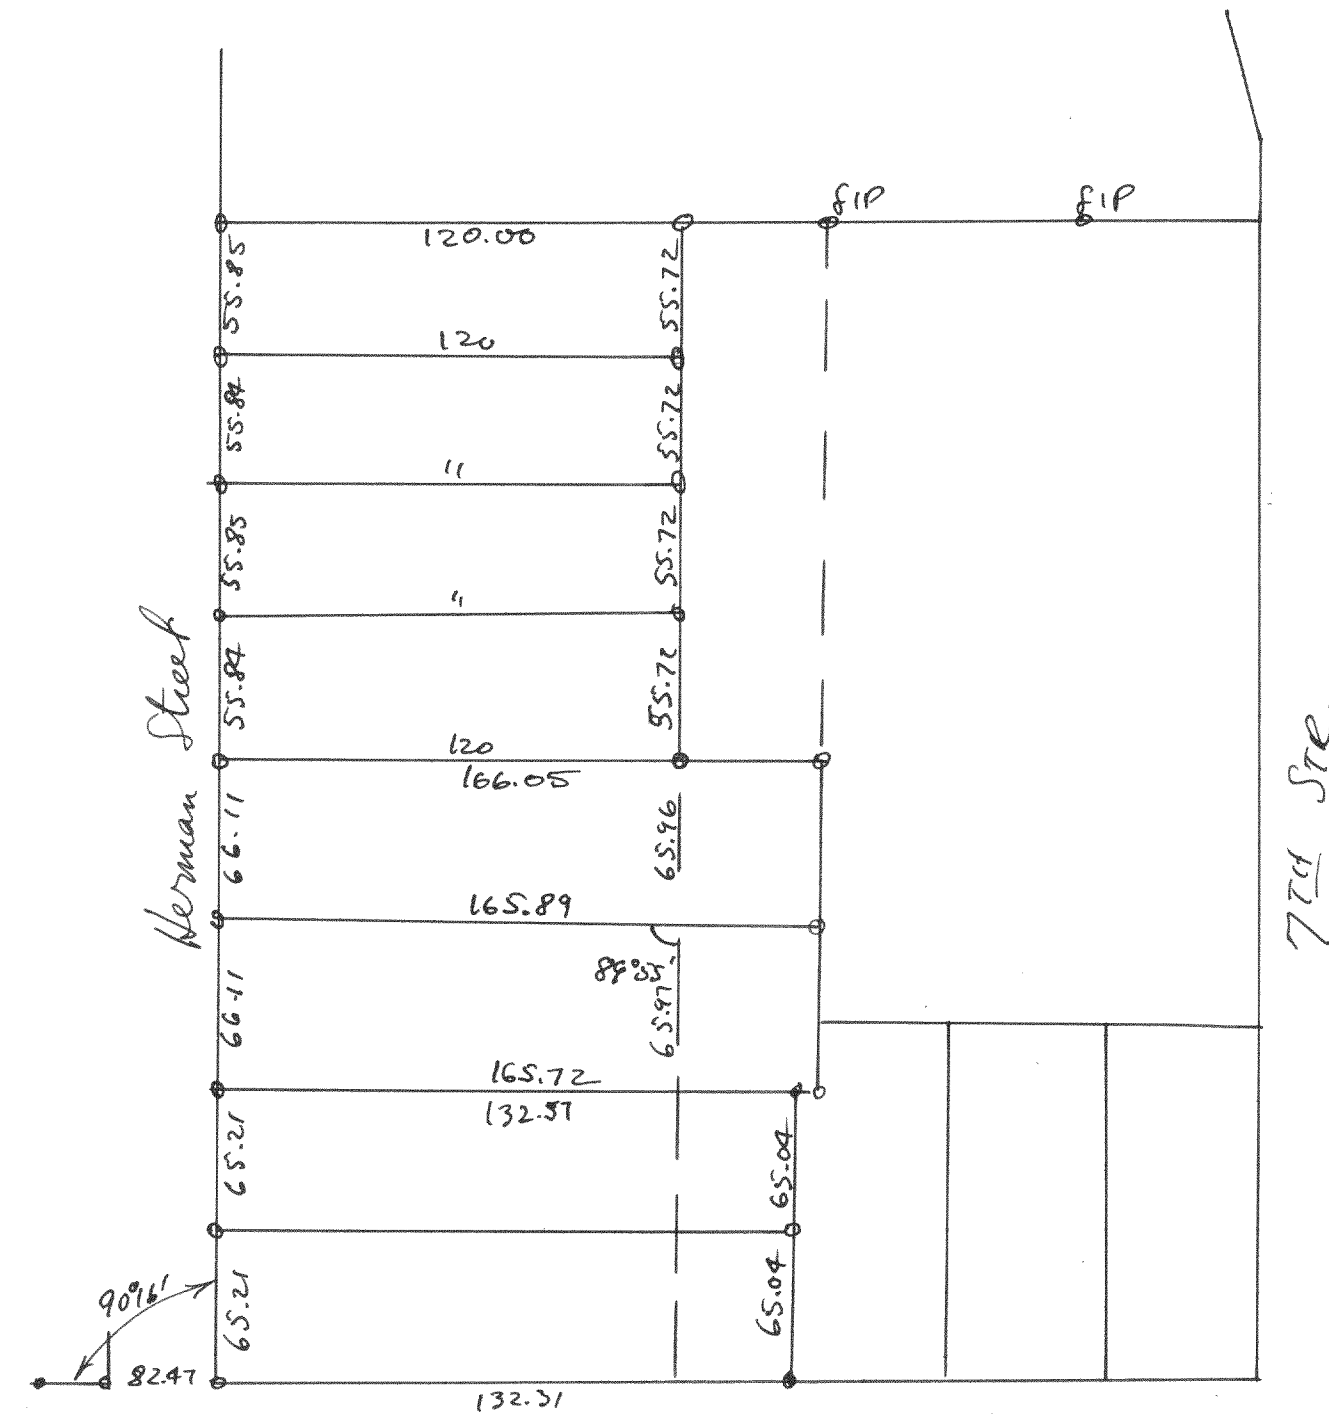

Replat of part of Blk 12 of Passage Acre & Downies Subd. located in the City of Delavan, Walworth Co., Wis.
Sept 20, 1950
Lloyd L. Jensen
County Surveyor