

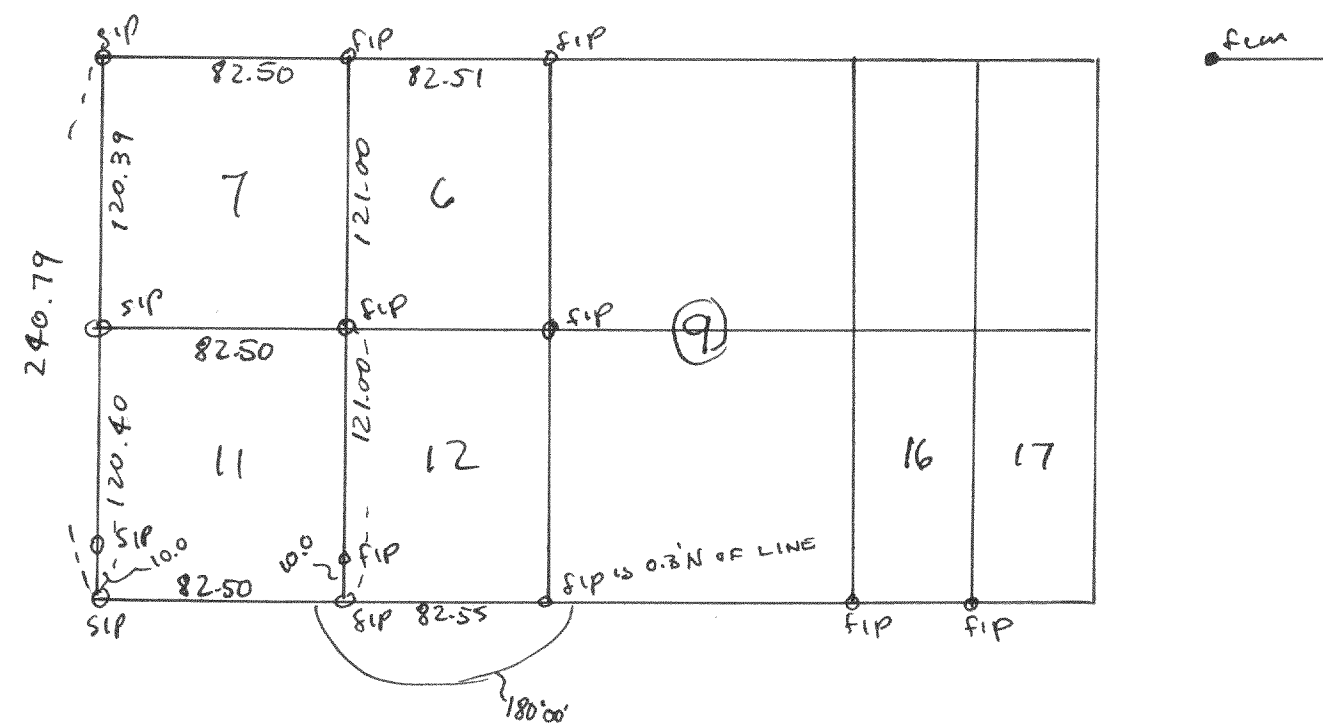


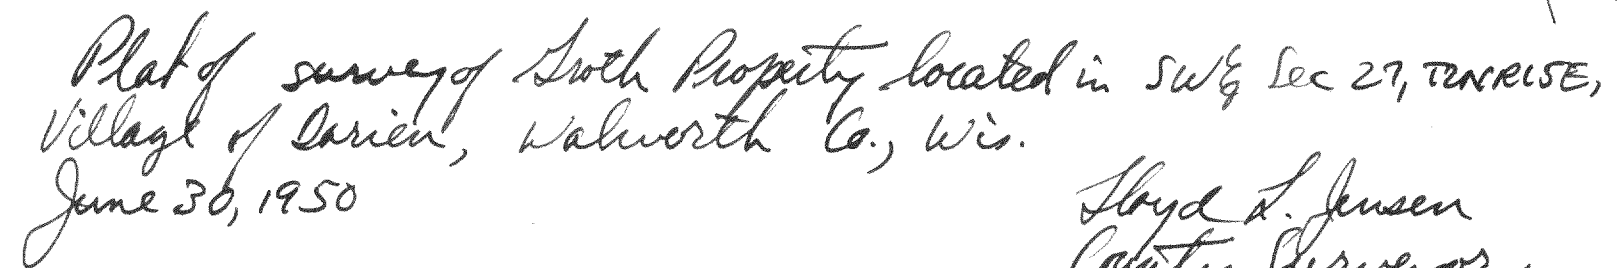

Plat of survey of Lot 2 & 11, Blk 9 of a regional Village of
Finland located in SE $\frac{1}{4}$ of Sec 14, T16N R16E, Walworth Co., Wisc.
March 25, 1950
Floyd L. Jensen
County Surveyor

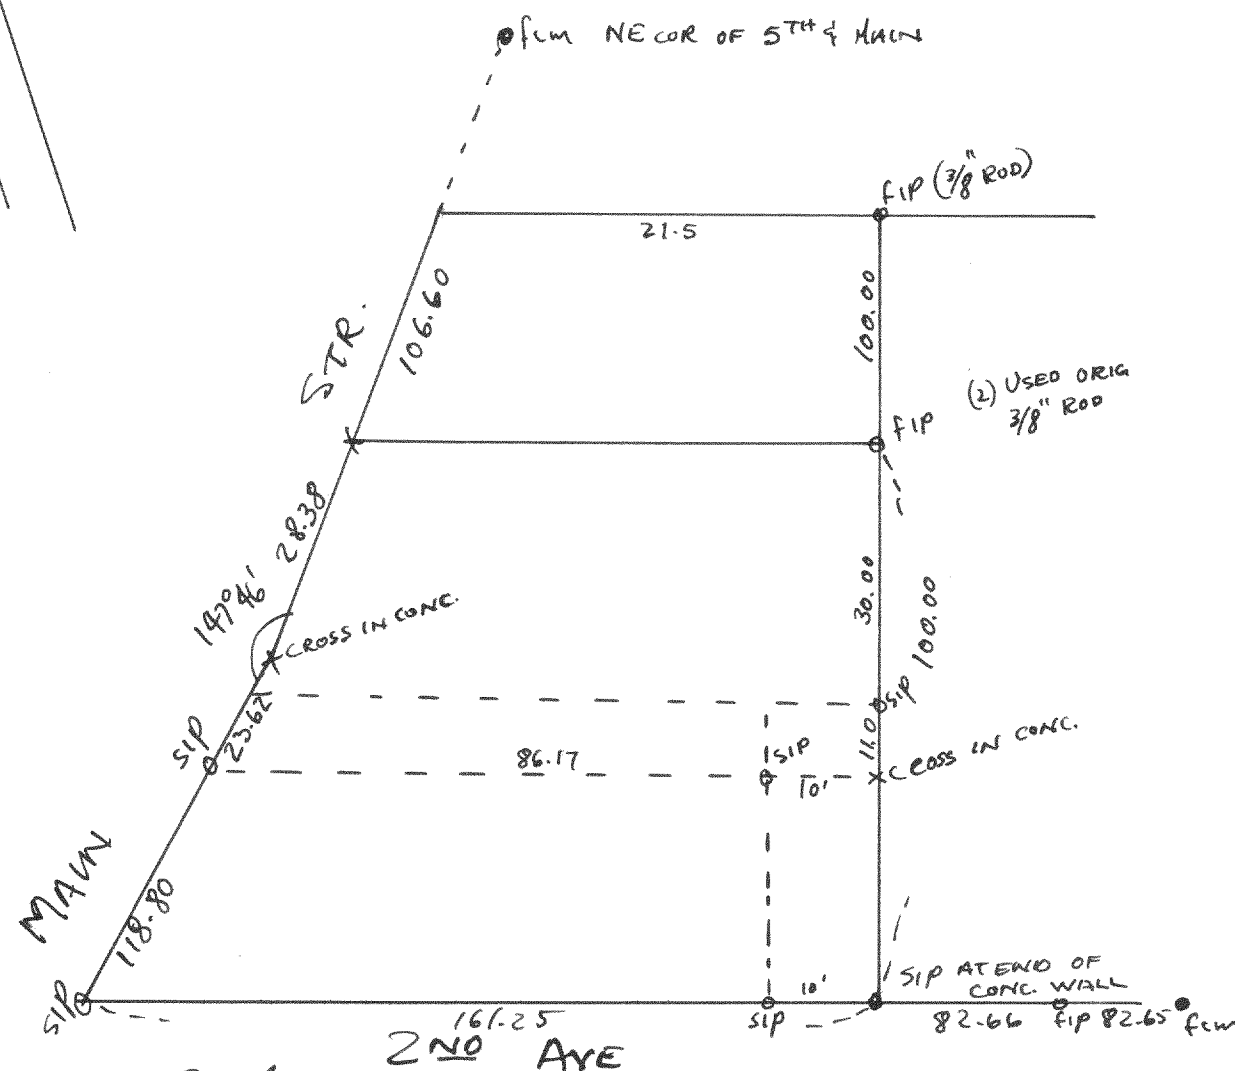

Plot of survey of Lot 4, Blk 3 of the Original Village of Fontana located in
SE 1/4 of Sec 19, T18N R16E of Walworth Co., Wis.
April 7, 1950
Hoye L. Jensen
County Surveyor