



Lloyd L. Jensen
County Surveyor

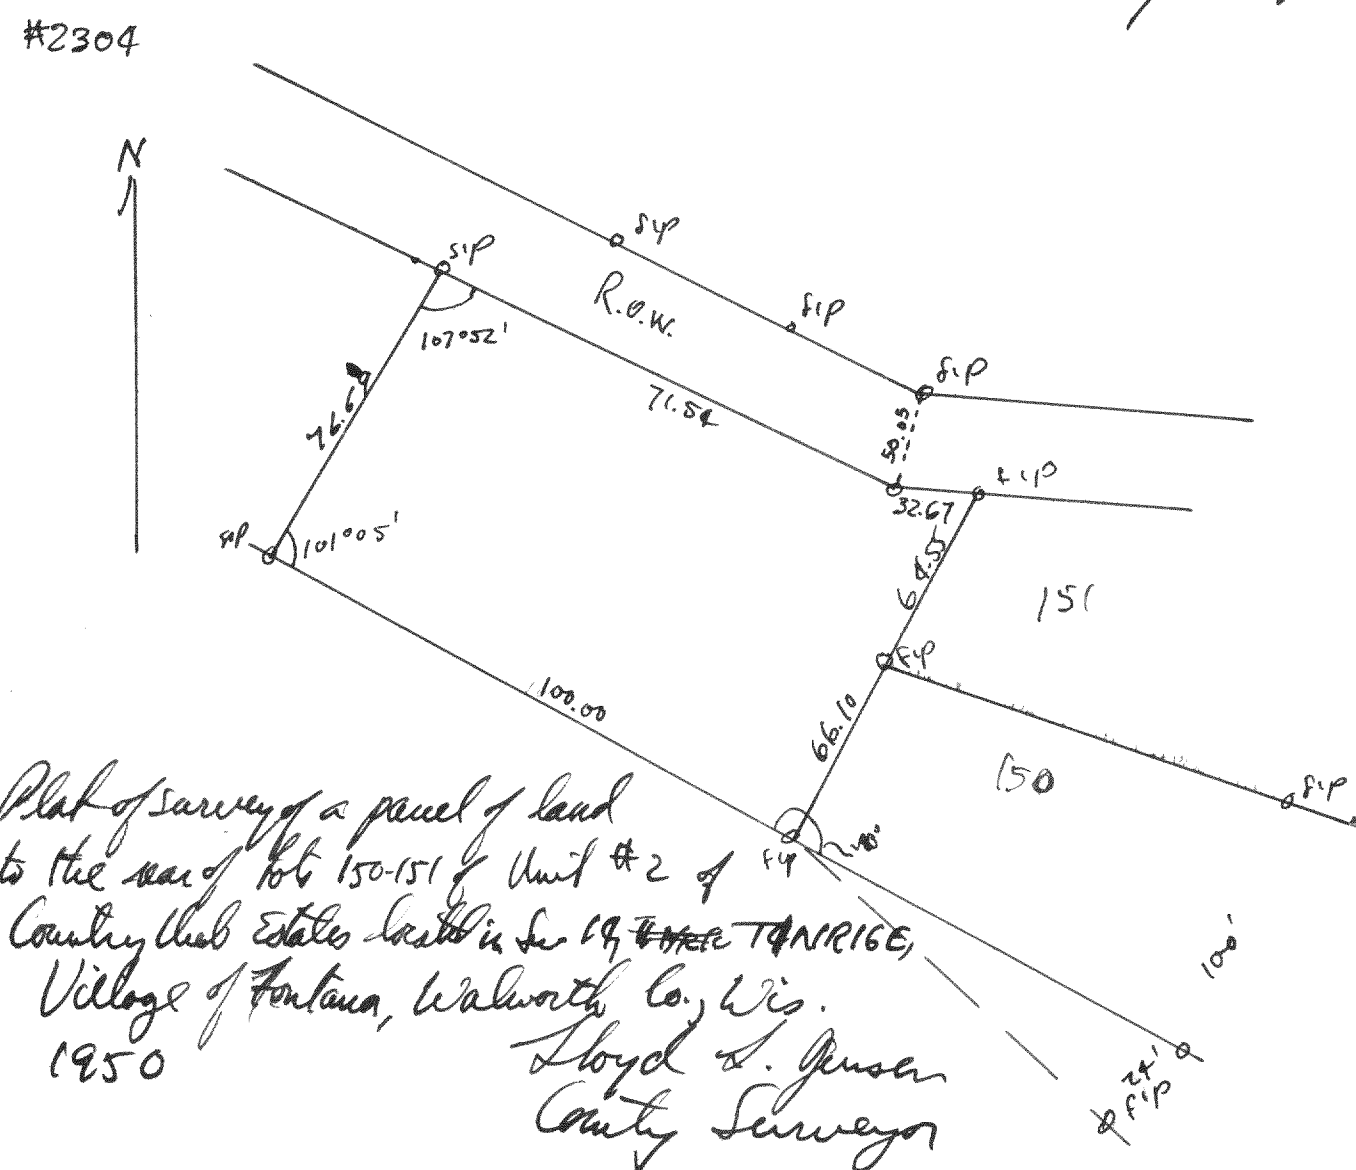

Plat of survey of a parcel of land
to the rear of lots 150-151 of Unit #2 of ^{the} ~~the~~ ^{new}
Country Club Estates located in Sec 19 ~~the~~ TOWNSHIP 16E,
Village of Fontana, Walworth Co., Wis.
1950 Lloyd L. Jensen
County Surveyor

Plot of survey of the W. Road line & pelt in the upper gardens
Subdivisions located in Sec 11, T14N16E, Walworth County, Wis.
July 18, 1950
Lloyd L. Jensen
Rt. 8 - Wisc.

Thos L. Green
County Clerk

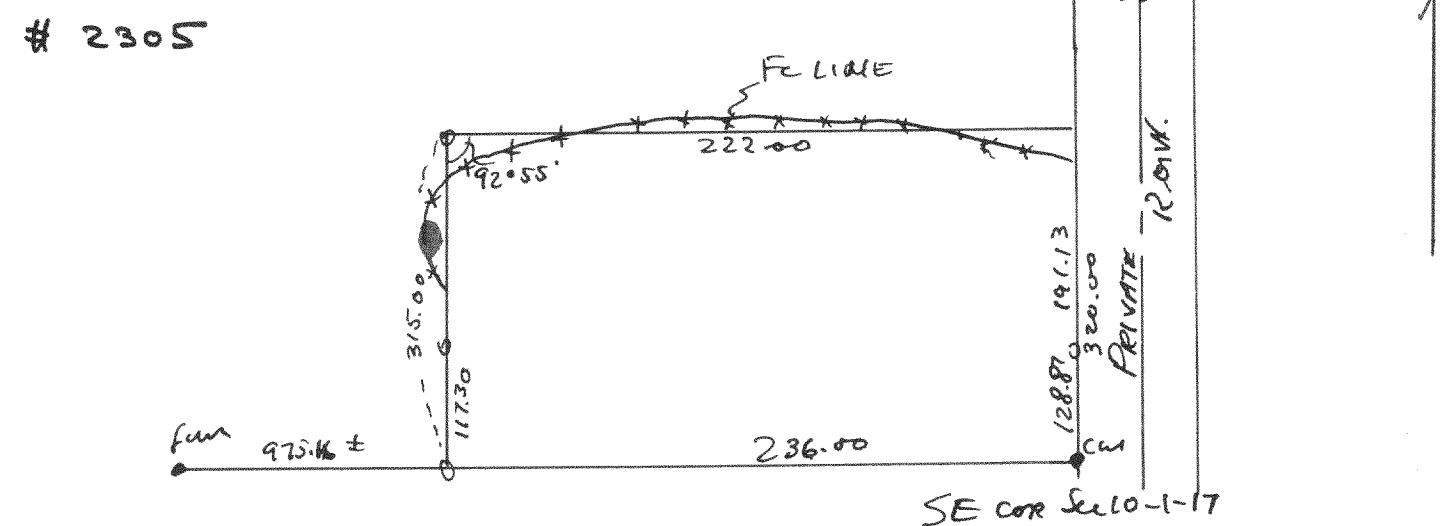

Relat of survey for parcel of land sold by Fontana to Bridges
located in the SE cor of Sec. 10, T12N, R10E, Coconino County, Ariz.
Aug 26, 1958
Hoyd L. Jensen

Lloyd L. Jensen
County Surveyor