



2313

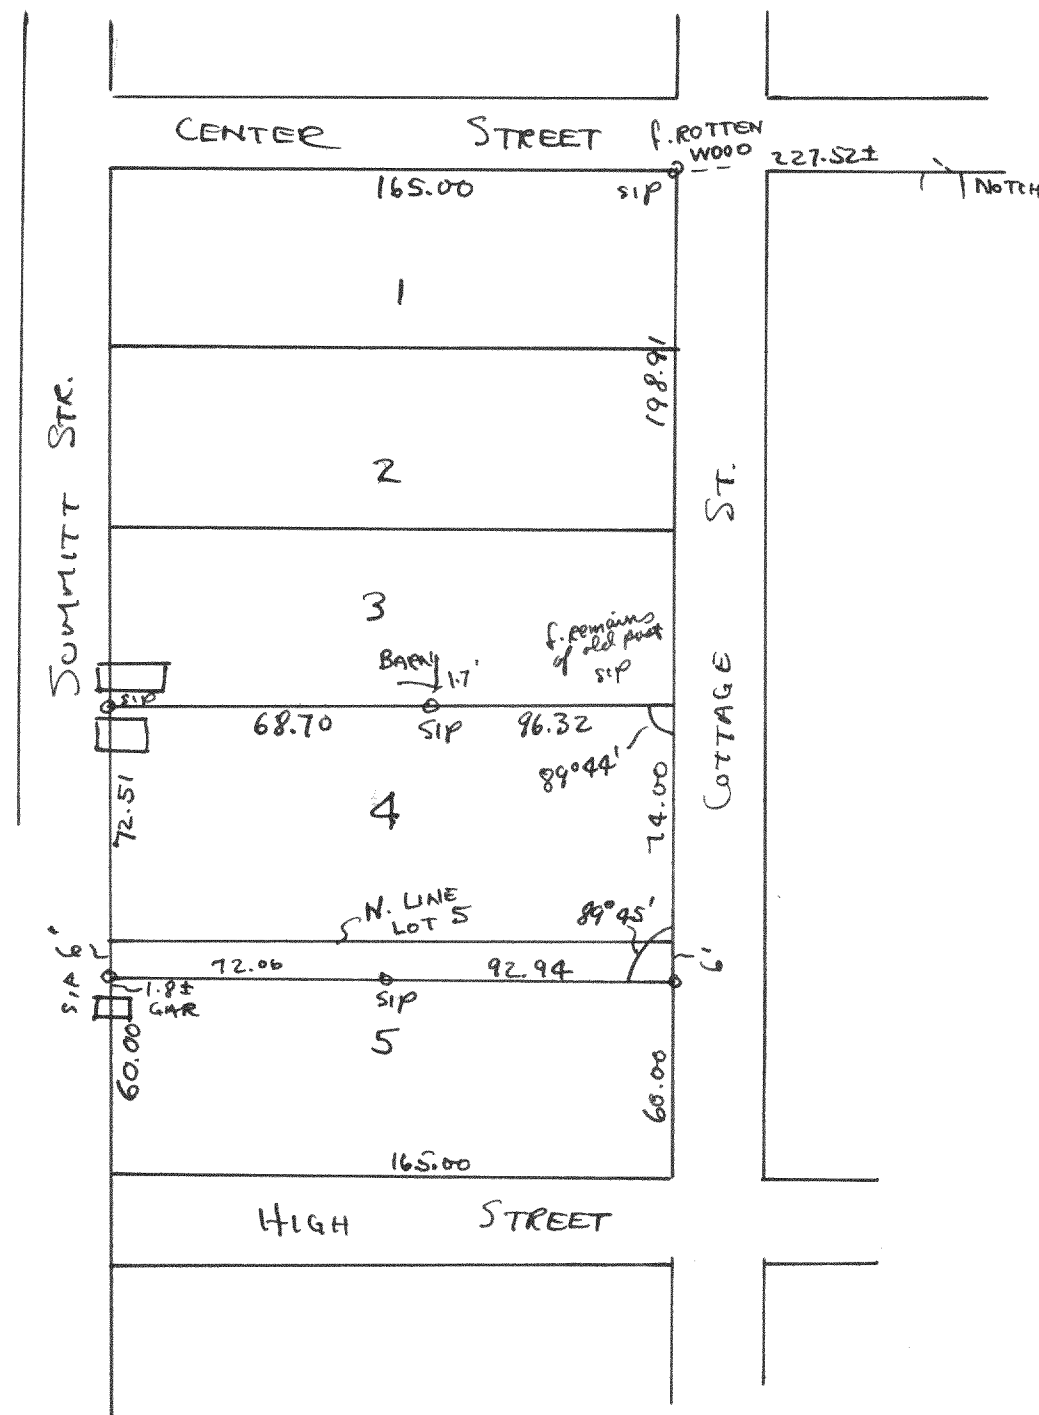

Plat of survey of Lot 4 and the N 6' of Lot 5 of
Blk 19 of Chapman's Leading tin's Addl in the City of Whitewater
in the SE 1/4 of Sec 5, T4N R15E, of Walworth Co., Wis.
Sept 22, 1950
Floyd L. Jensen
County Surveyor

2314

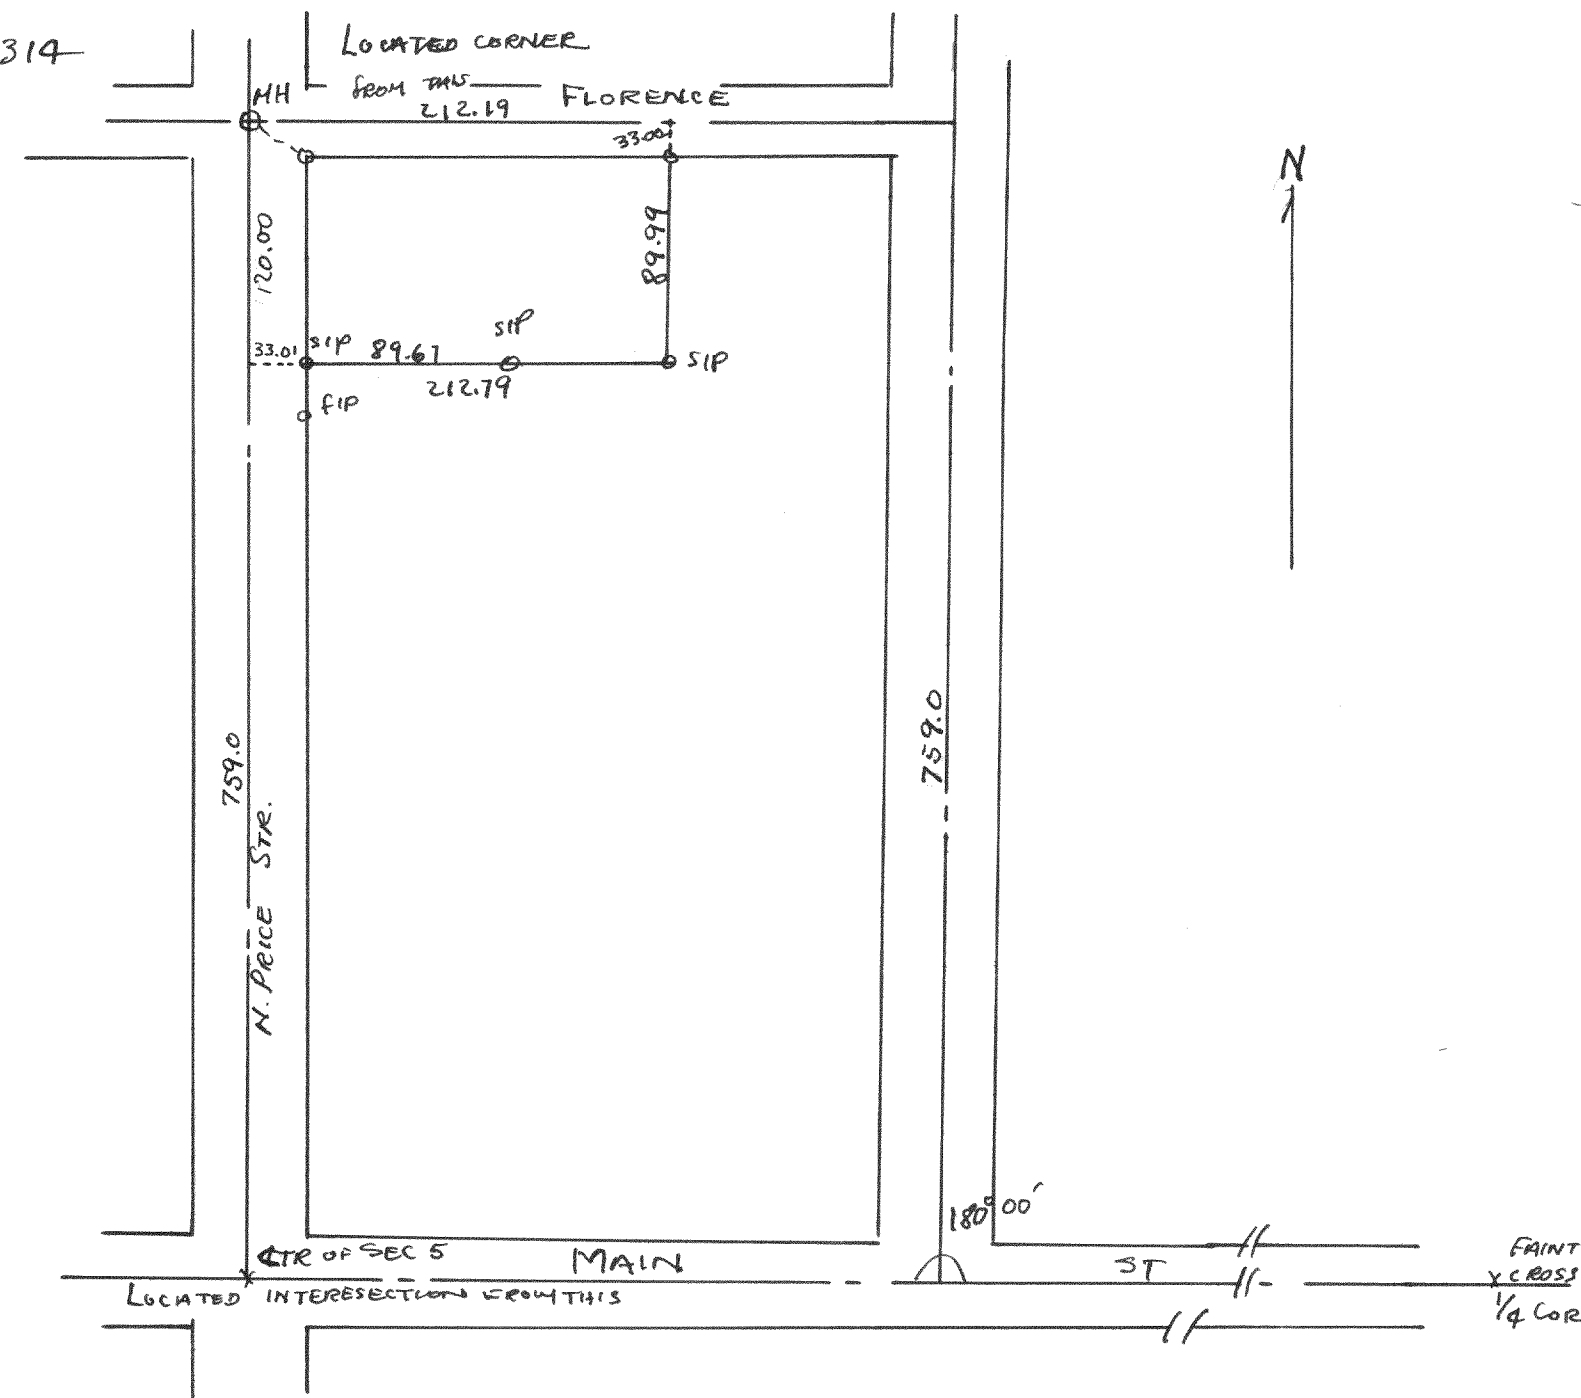

Plat of survey of a parcel of land located at the corner of Florence and
N. Price Sts. located in the City of Whitewater, Walworth Co., Wis.
Oct 27, 1950
Floyd L. Jensen
County Surveyor