



2317

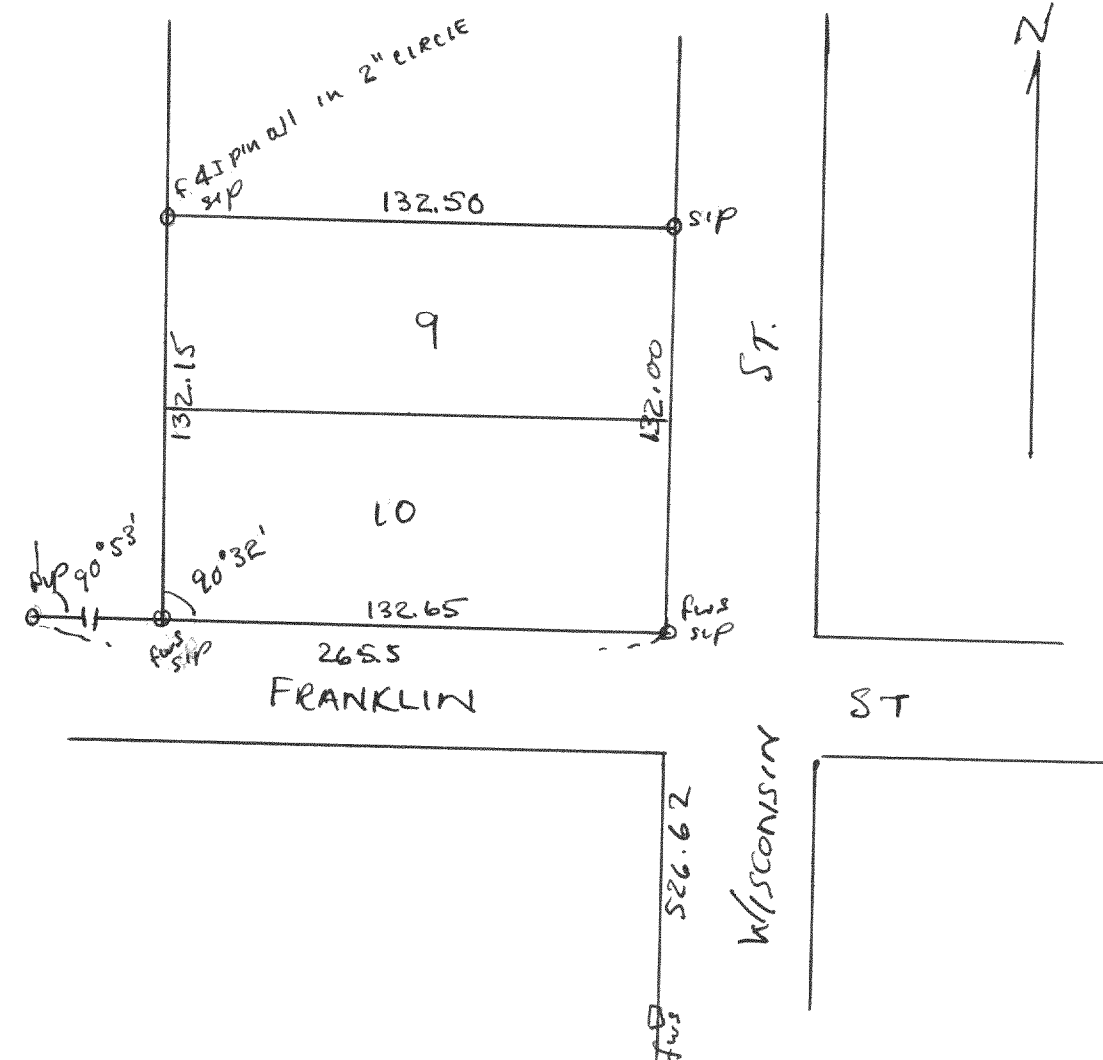

Plat of survey of lots 9 & 10 of Jeffords Add located in the
NE 1/4 Section 3S, T14N18E Menominee City, Walworth County, Wis.
Lloyd L. Jensen City Surveyor


2319

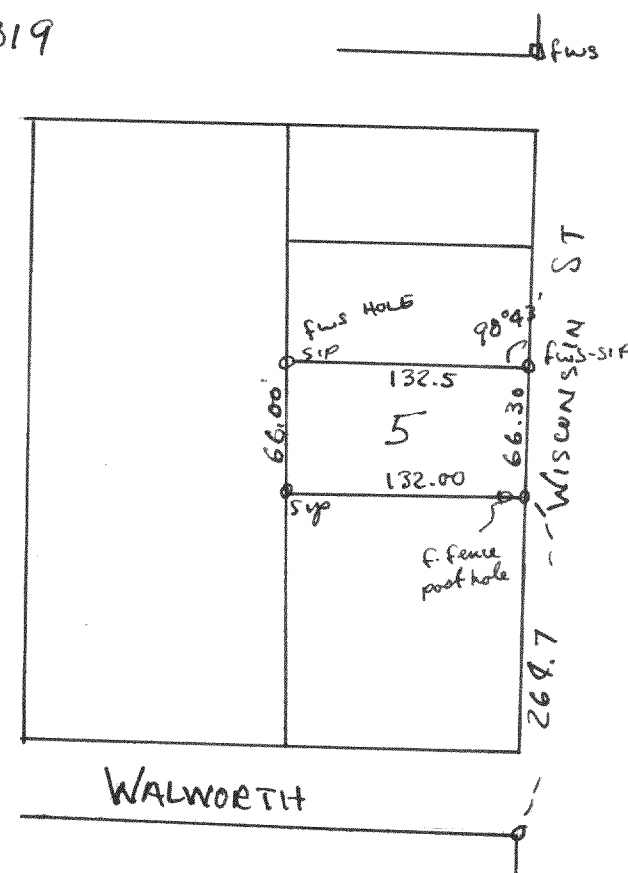

Plat of survey of part of lot 5, Framan's 2nd Add located
in Menominee City, Walworth Co. Wis.
1950

Lloyd L. Jensen
County Surveyor


2318

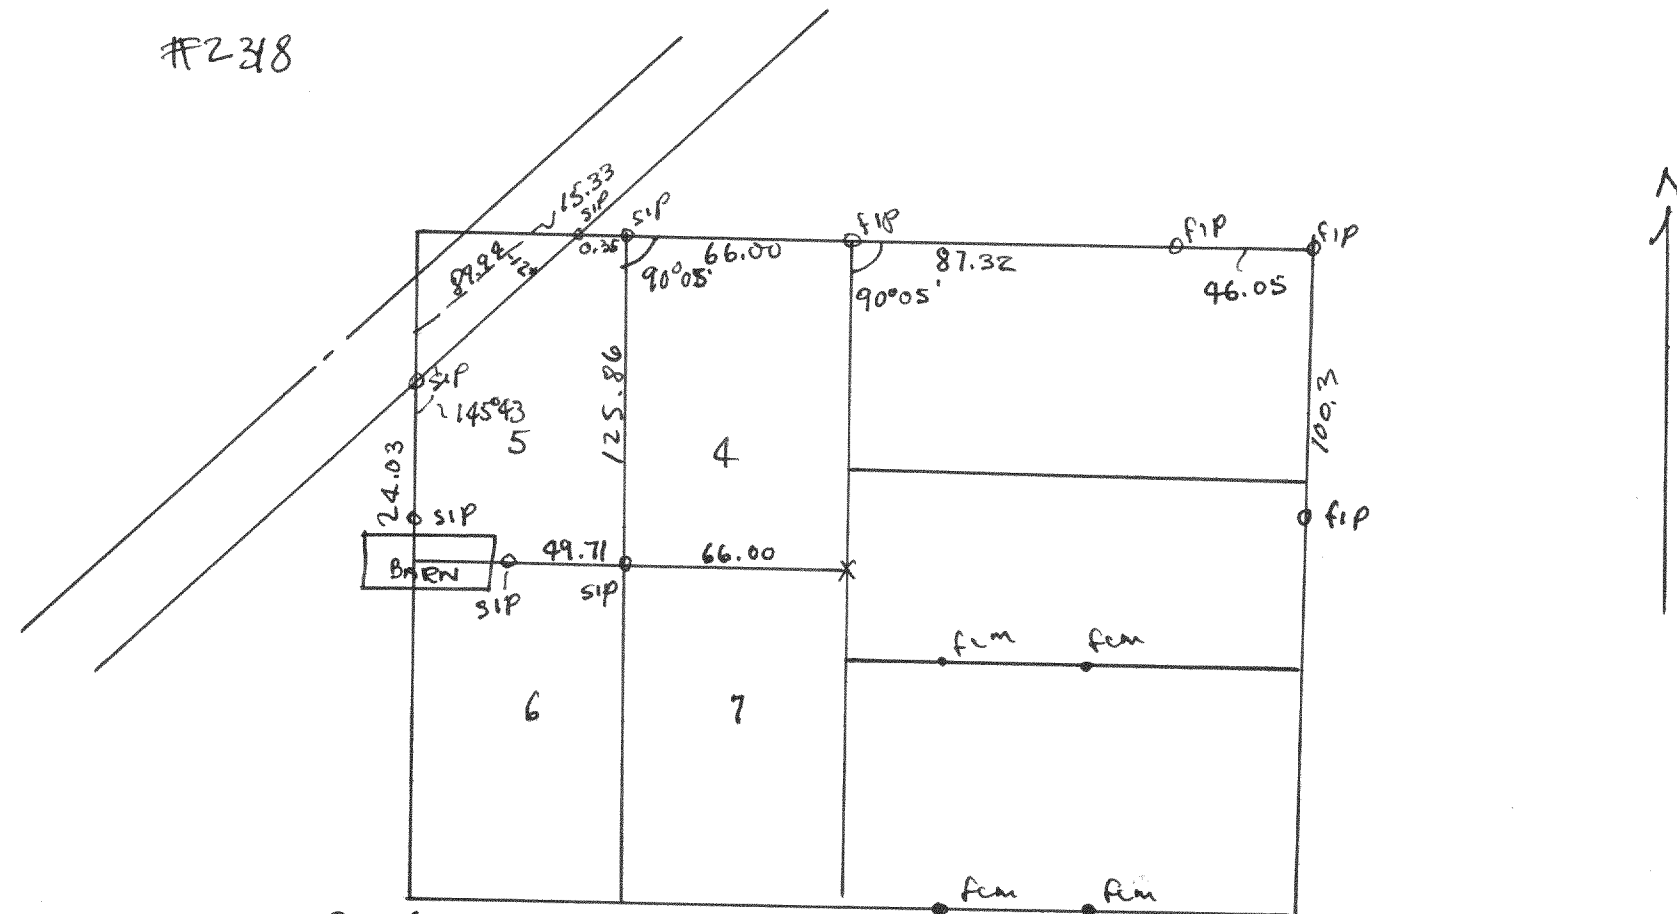

Plat of survey of part of lot 5 of the Original Town located in
Menominee City Walworth County, Wis.
1950

Lloyd L. Jensen
County Surveyor

2320

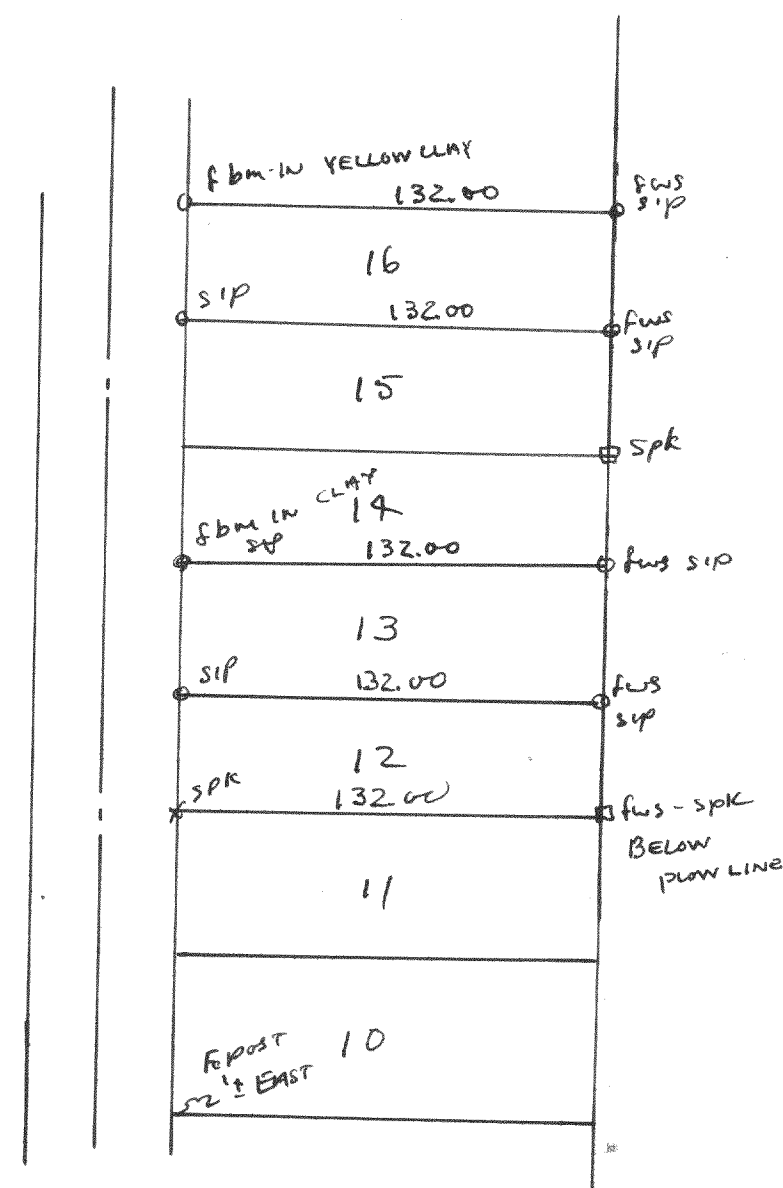

Plat of survey of lots 13-16 incl.,
Miller Addition Menominee City, Walworth
County, Wis.
Oct 28, 1950

Lloyd L. Jensen
County Surveyor