



2321

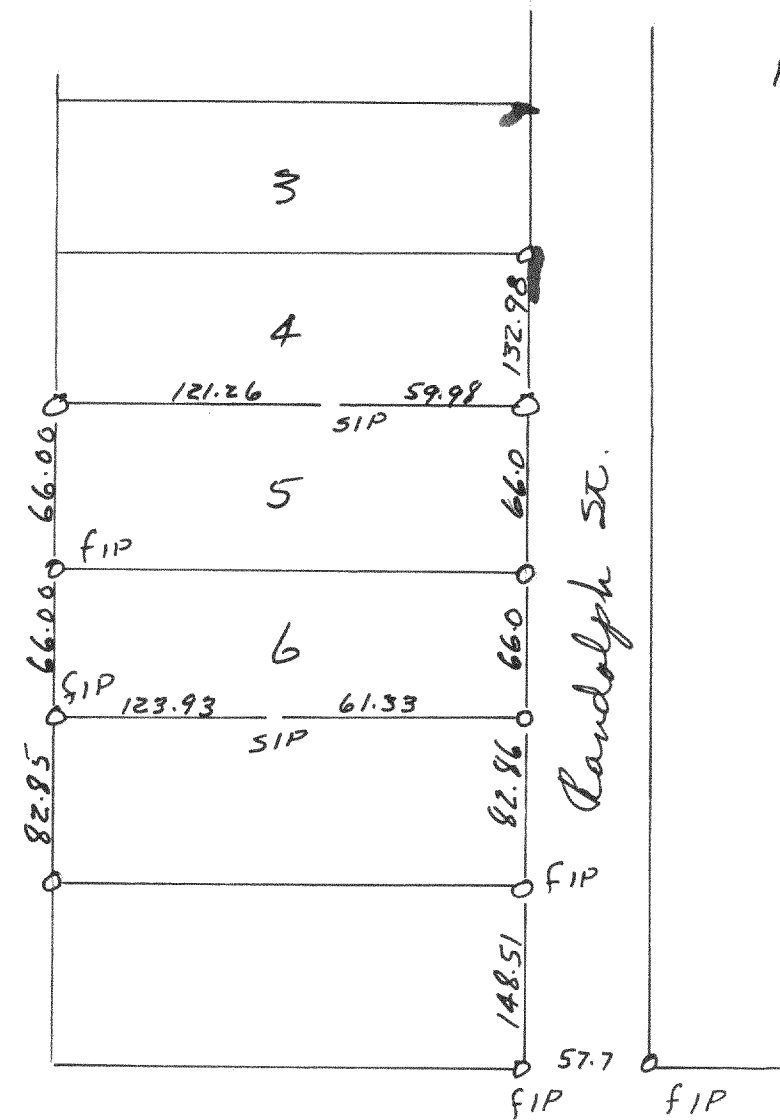


Plat of survey of lot 6 of Clarke 2nd Addition to Village of Walworth, Walworth County, Wis.
Aug 5, 1950
Lloyd L. Jensen (CWS)
County Surveyor

2322

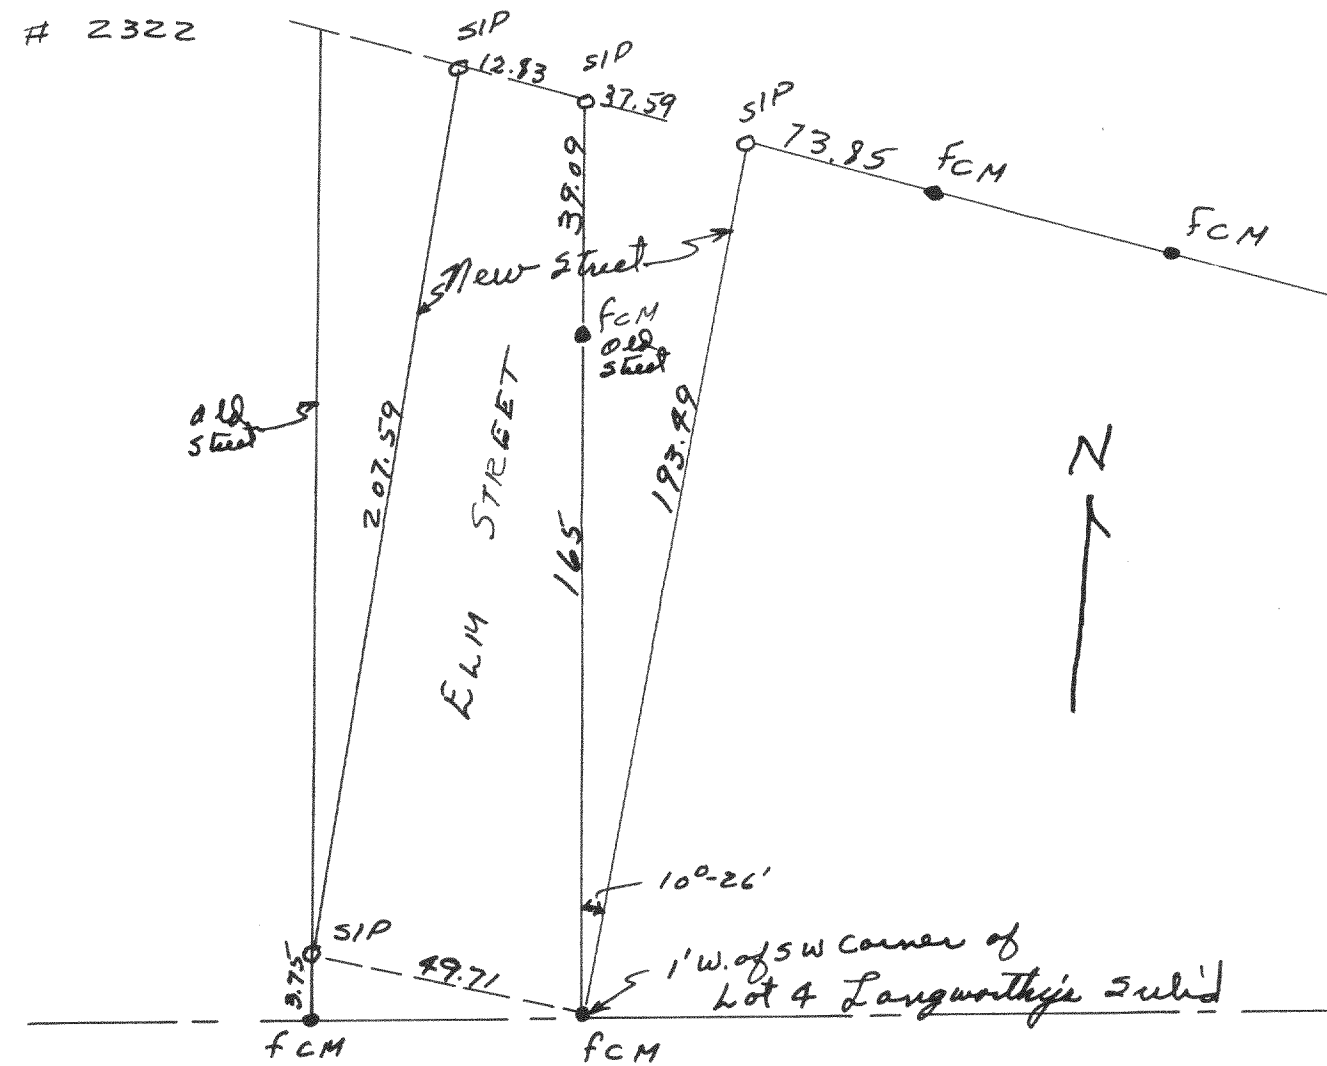


Plat of survey of the change of location of Elm Street at the Rock Wash Plant. Village of Walworth, Walworth County, Wis.
1950
Lloyd L. Jensen (CWS)
County Surveyor

2323

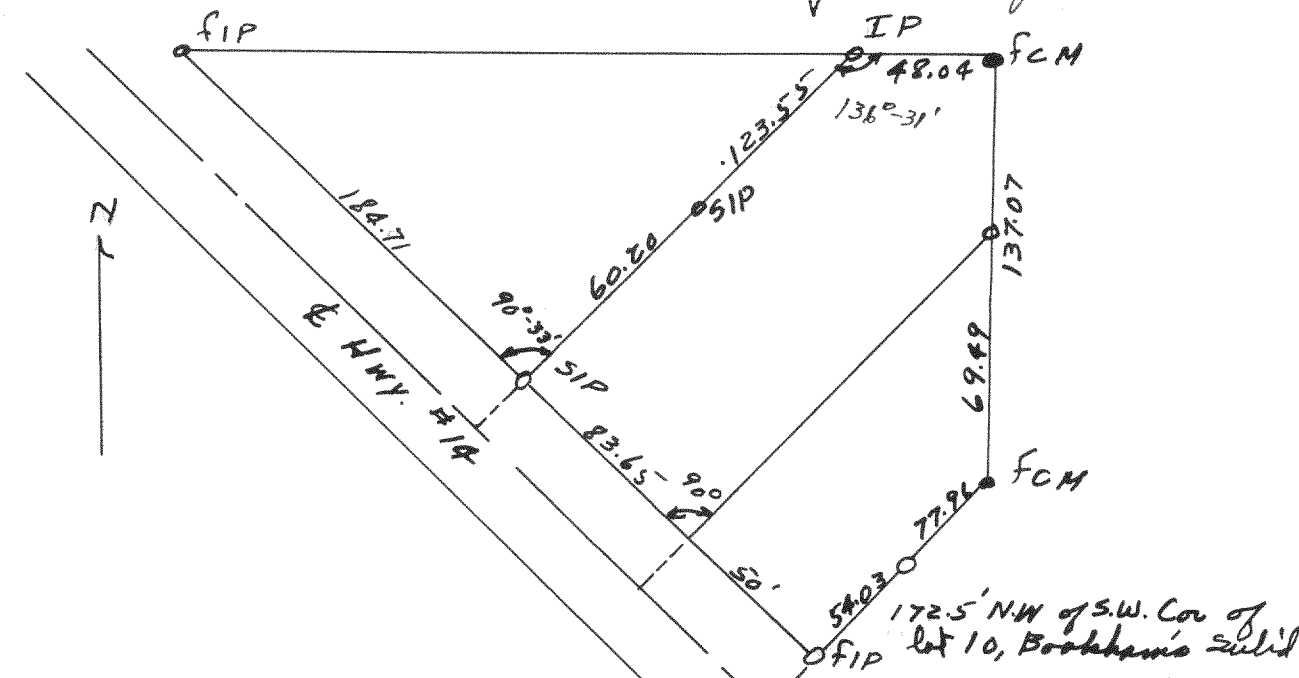

Plat of survey of the division of N.T. Nelson Property located in the Village of Walworth, Walworth County, Wis.
May 27, 1950
Lloyd L. Jensen (CWS)
County Surveyor

2324

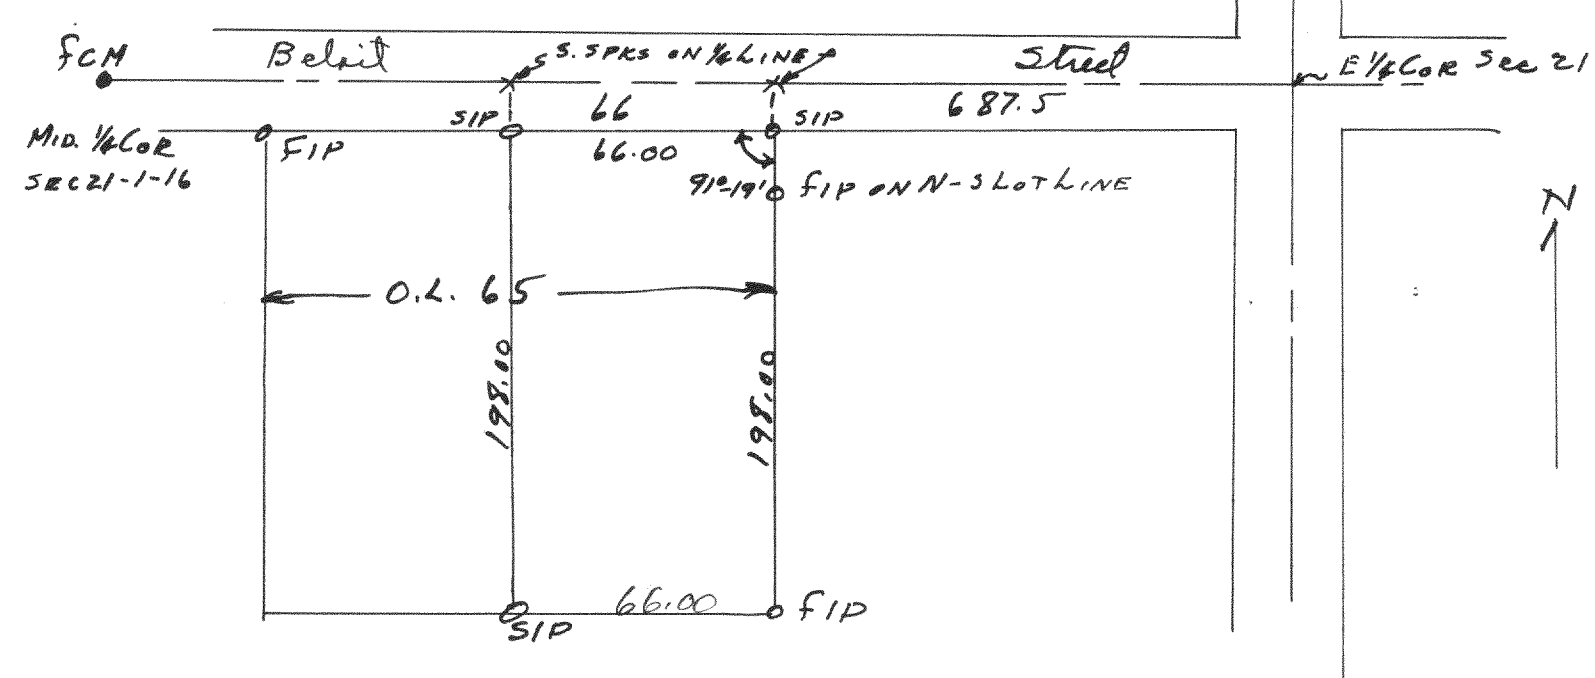

Plat of survey of the East 66 feet of O.L. 65 in the village of Walworth, Walworth County, Wis.
Aug 11, 1950
Lloyd L. Jensen (CWS)
County Surveyor