


542


#2325

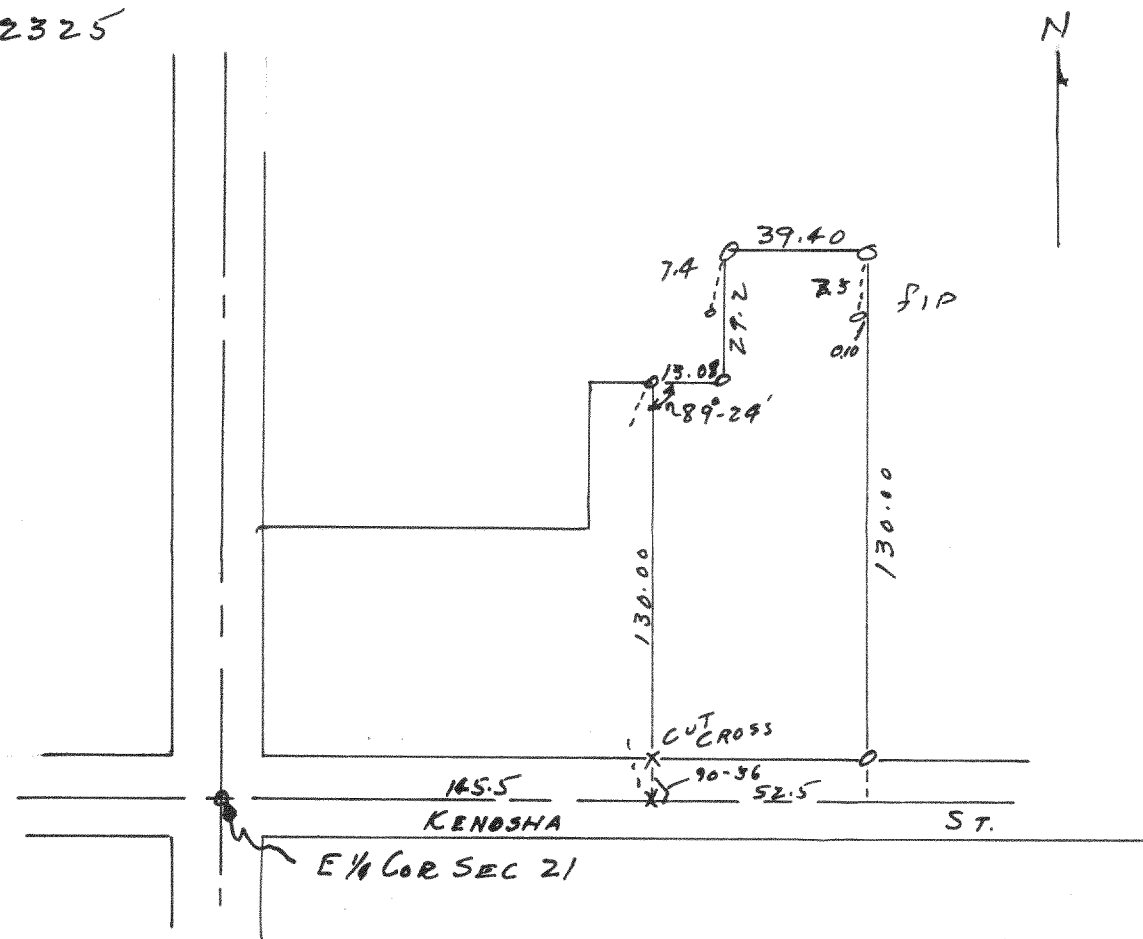

Plot of survey of the Brinstock Property located on Kenosha Ave
145.5 East of E 1/4 cor of section 21 T1N16E Village of Walworth
Walworth County Wis
1950

Floyd S. Jensen (CWS)
County Surveyor


#2327

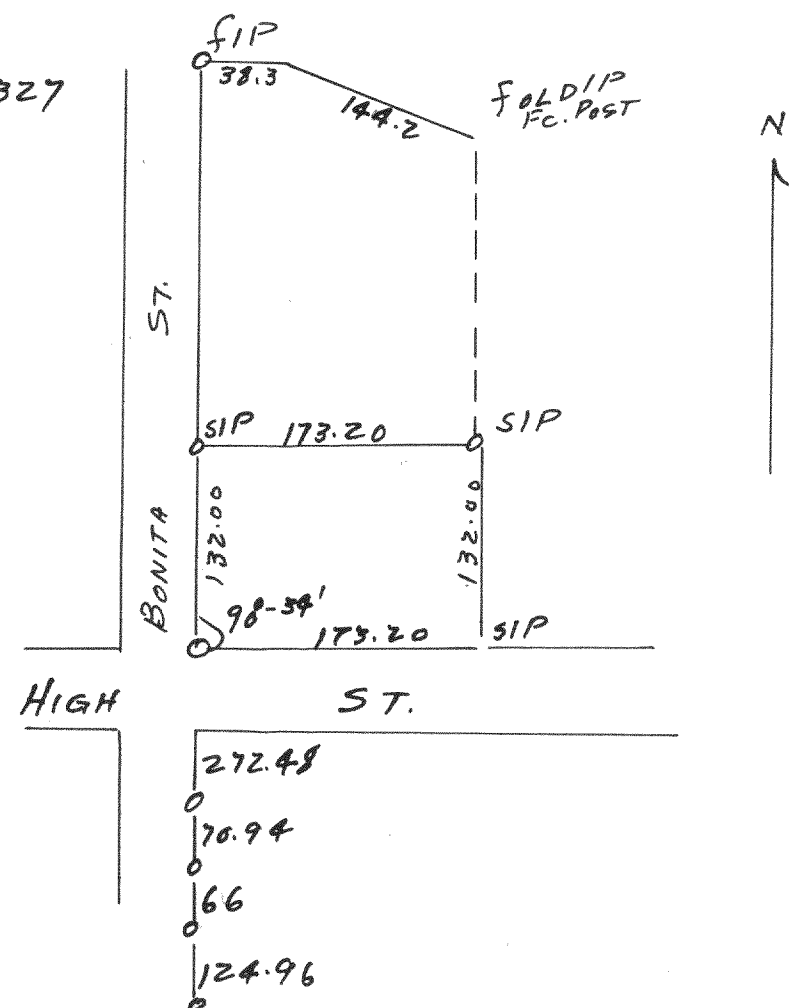

Plot of survey of part of O.L. 196 Village of Walworth
Walworth County, Wis
Oct. 25, 1950


Floyd S. Jensen (CWS)
County Surveyor

#2326

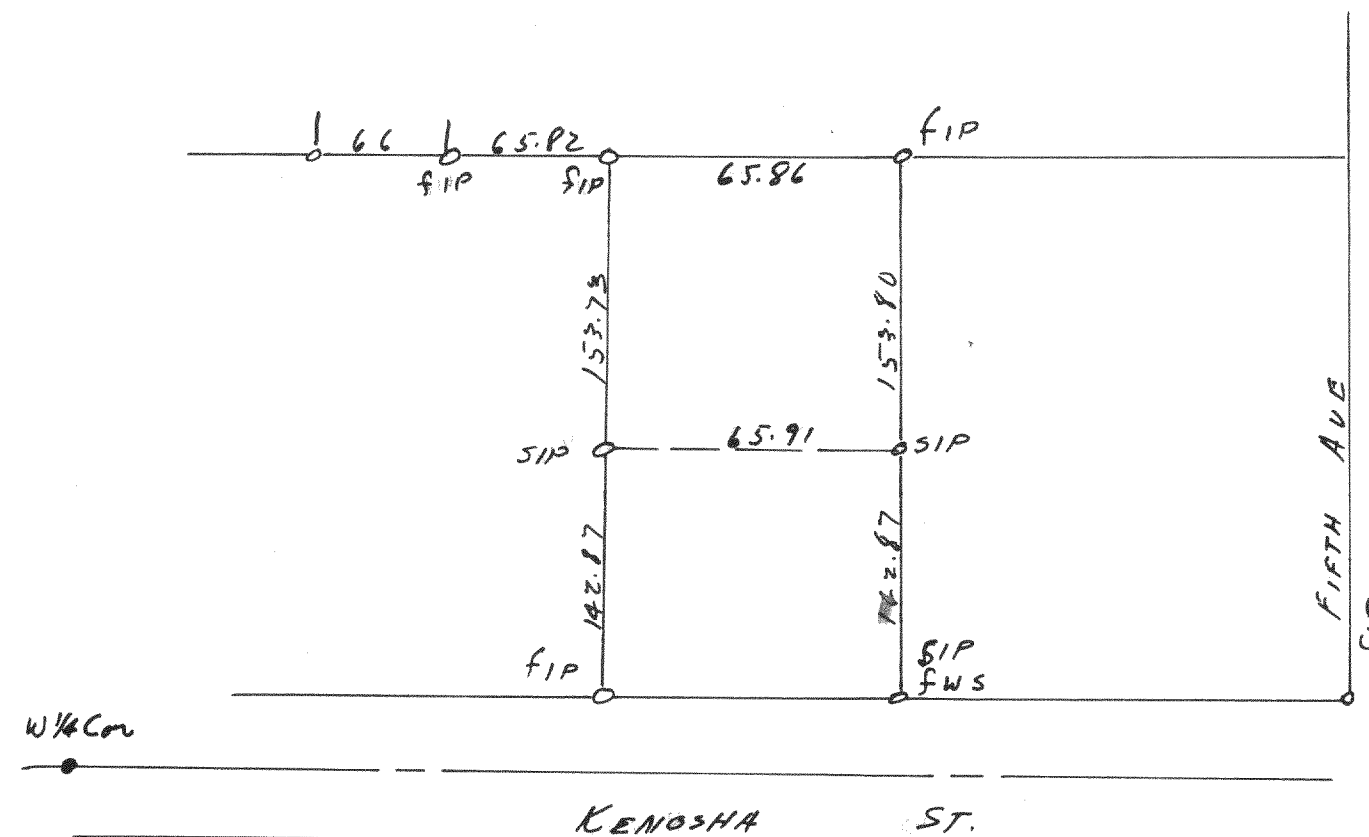

Plot of survey of O.L. 182 Village of Walworth, Walworth County, Wis.
Aug 19, 1950
Floyd S. Jensen (CWS)
County Surveyor

#2328

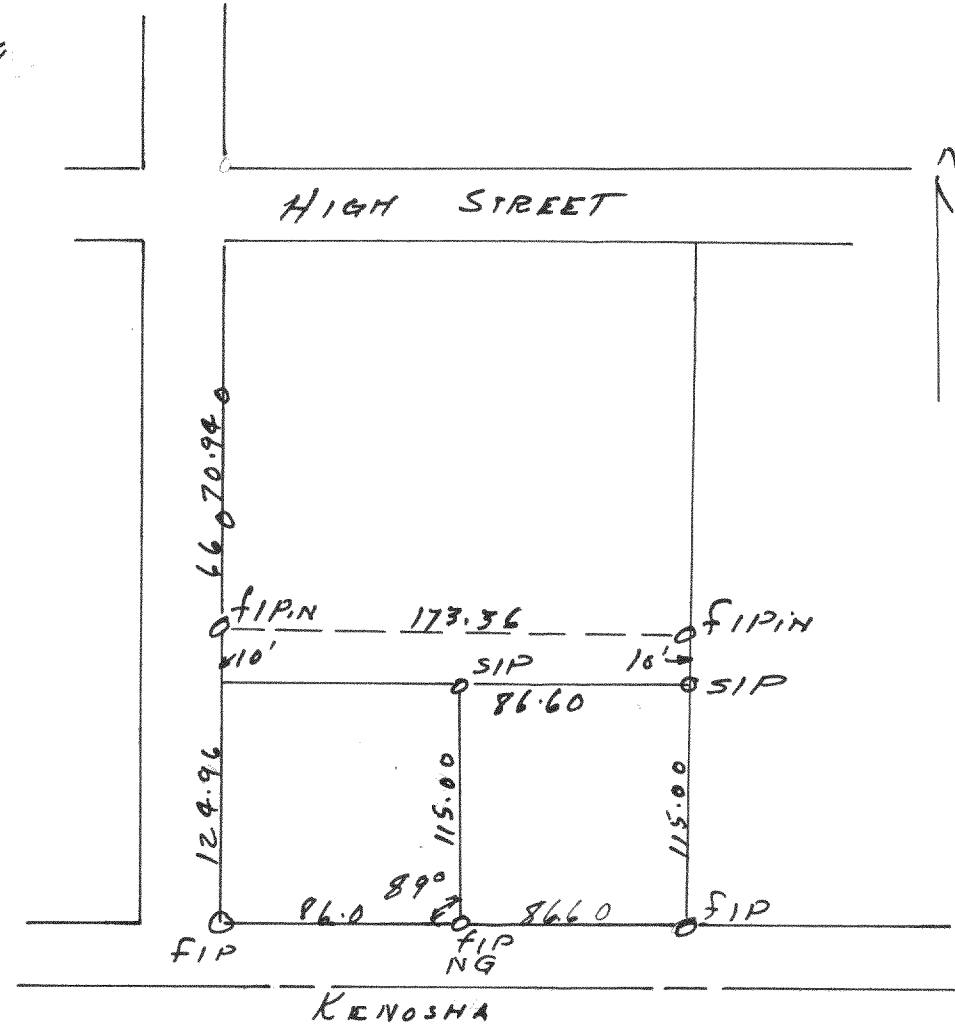

Plot of survey of part of O.L. 196 Village of Walworth
Walworth County, Wis.
Nov. 1950
Floyd S. Jensen (CWS)
County Surveyor