


2337

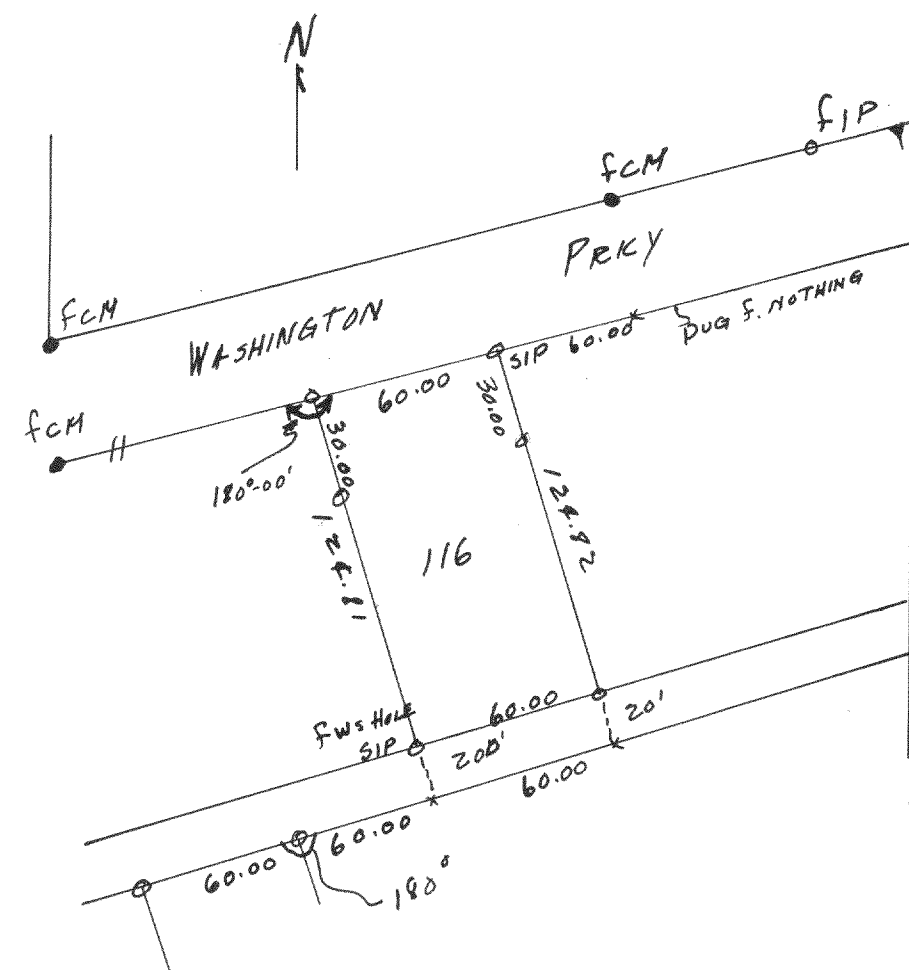


Plot of survey of lot 116 of Cedar Point Park original Subd.
located in the S.E. 1/4 of Sec. 6 T14N R17E, Walworth County, Wis.

Aug 2, 1950


Floyd I. Jensen (Cw G)⁸
County Surveyor

2339

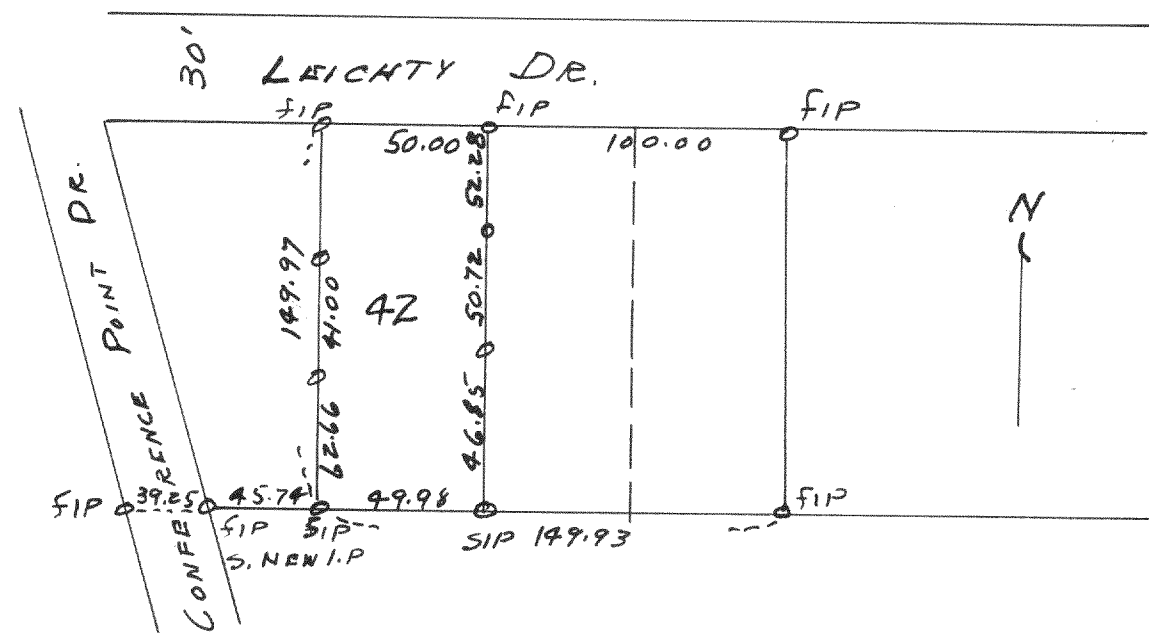


Plot of survey of lot 42 Summer Haven Subd.
located in SE 1/4 of Sec 17 T16N R16E Village of Wilkins Bay
Walworth County, Wis. Floyd T. Jensen (Clerk)
Sept 9, 1950 County Surveyor

2338

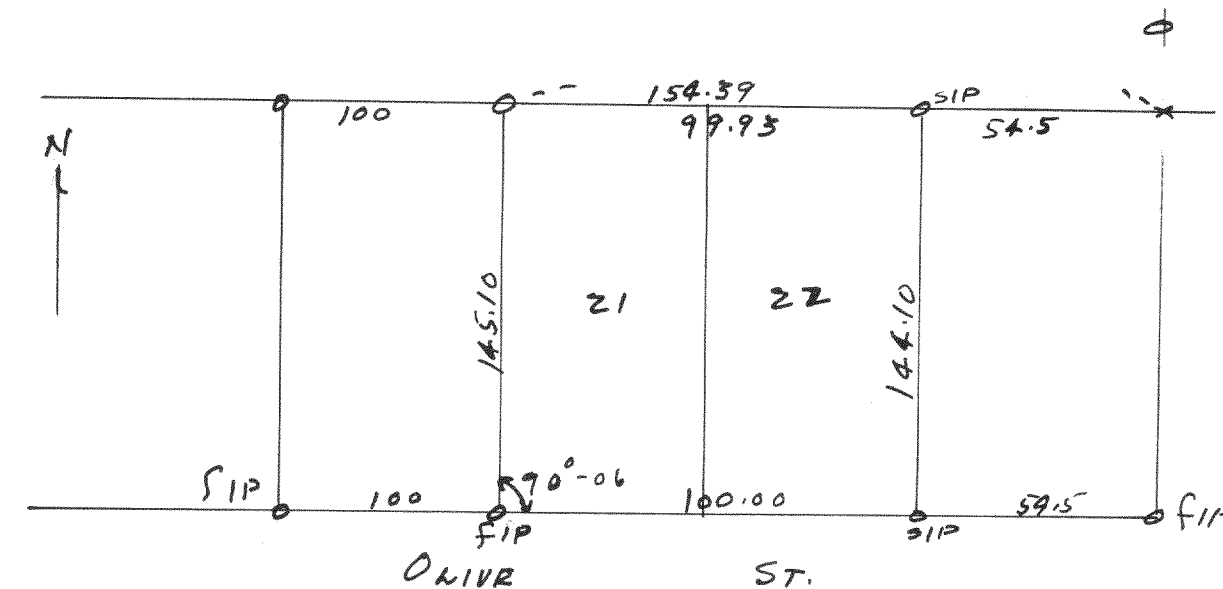

Plot of survey of lots 21 & 22 BLK 1 75th St. S. located in the
NE 1/4 of Sec. 1 T18R16E, Village of Williams Bay, Wauwatosa County, Wis.
Aug 10, 1950
Lloyd J. Jensen (CWS)
County Surveyor

2340

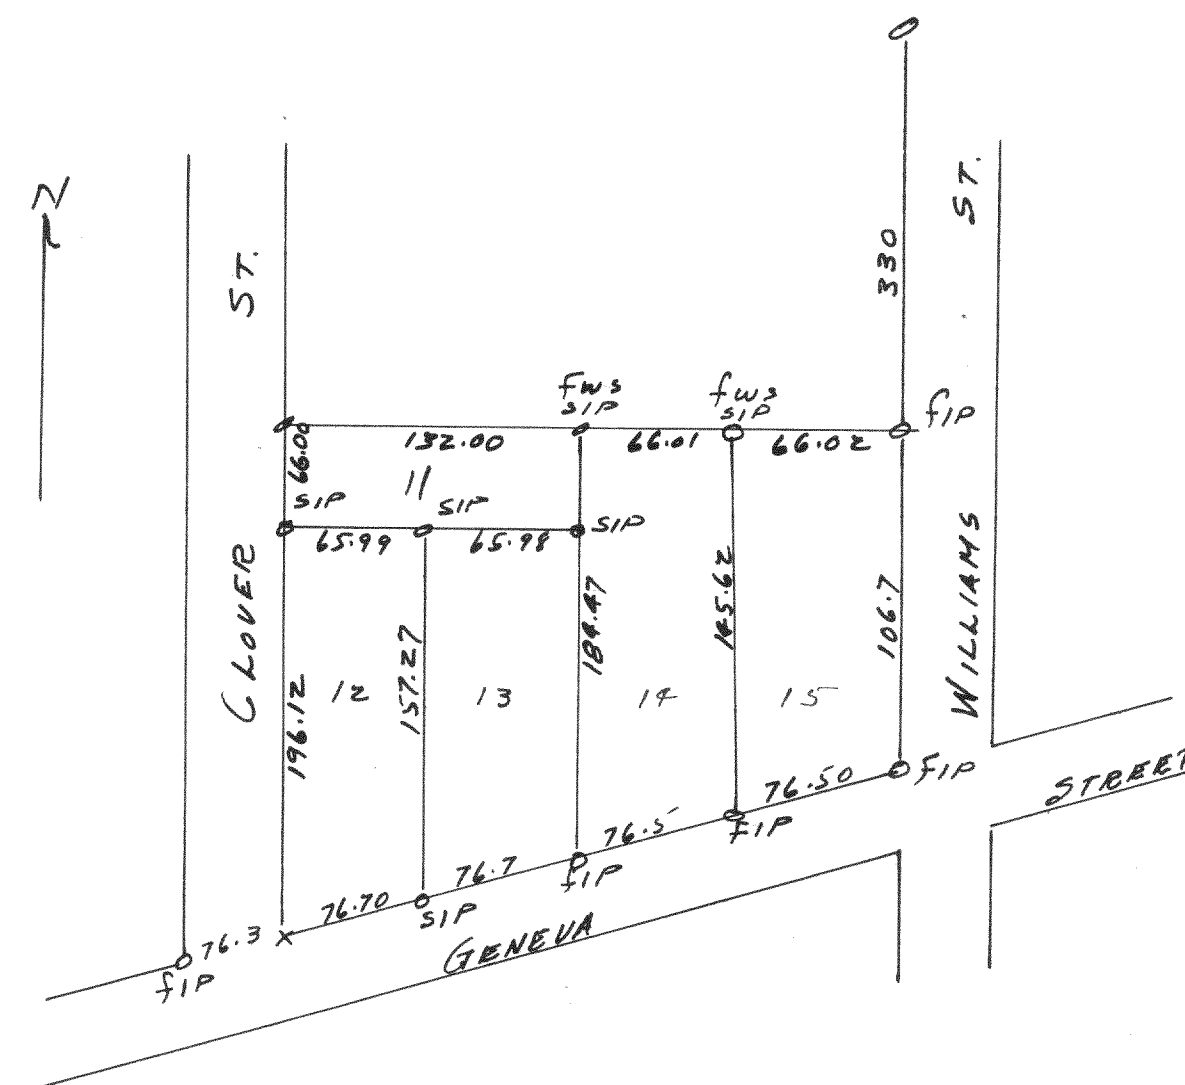

Plot of survey of lot 15 Block 9 of Williams 2nd Addition
located in the NE 1/4 of Sec 17 T14N R16E, Village of Williams Bay
Walworth County, Wis.
Sept 30, 1950
Floyd L. Jensen (CW4)