
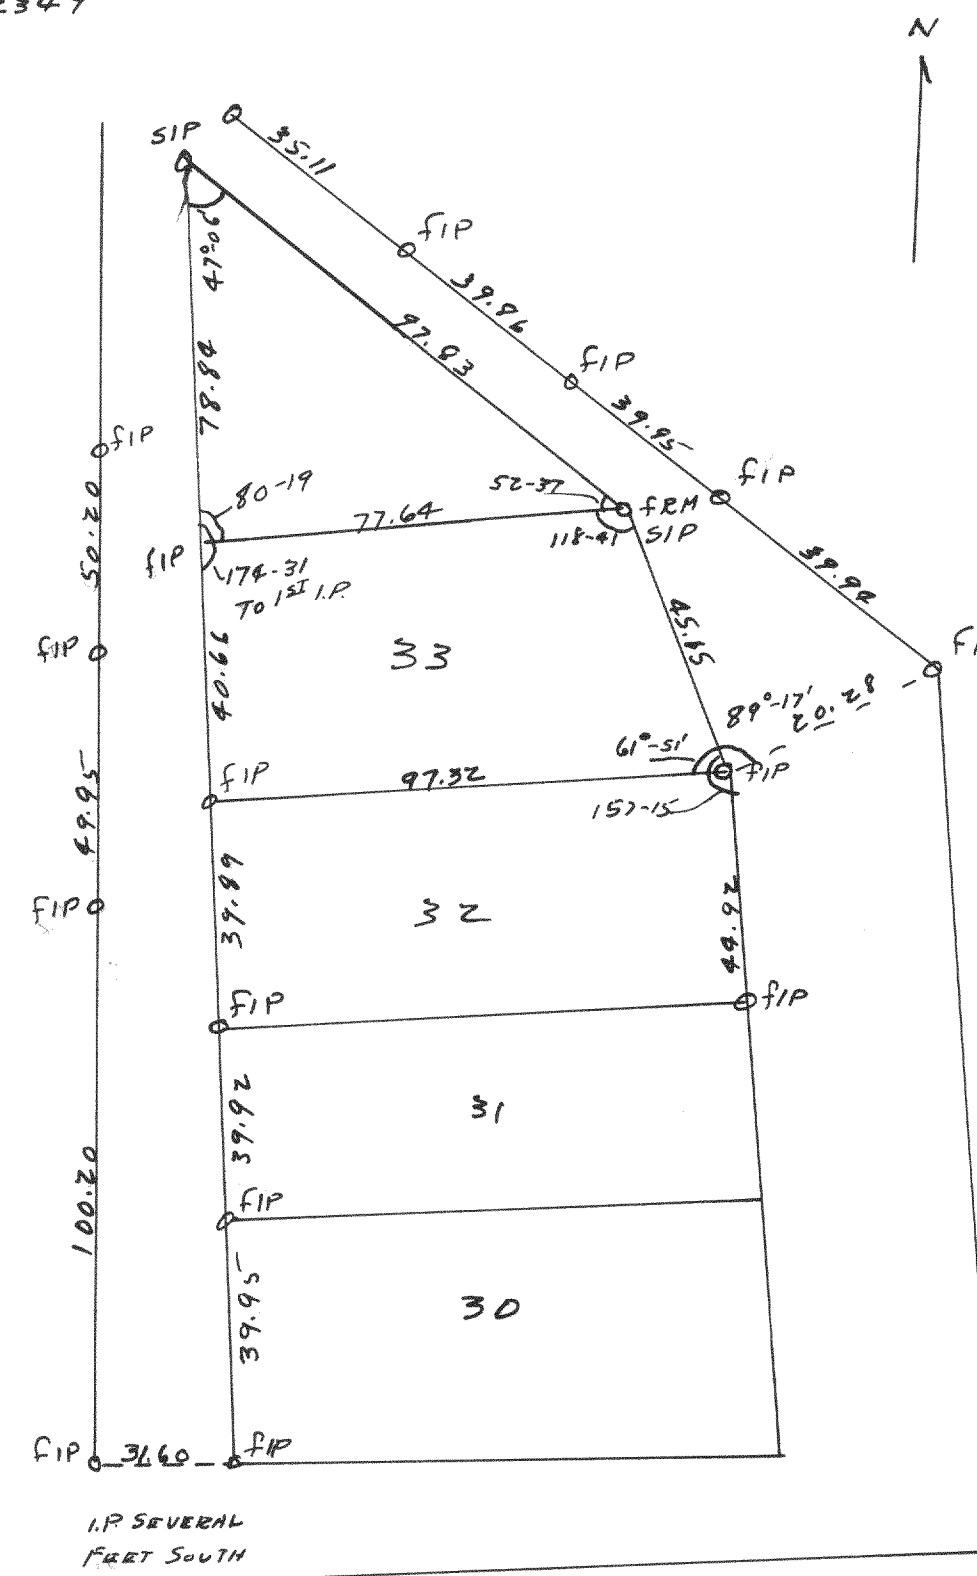


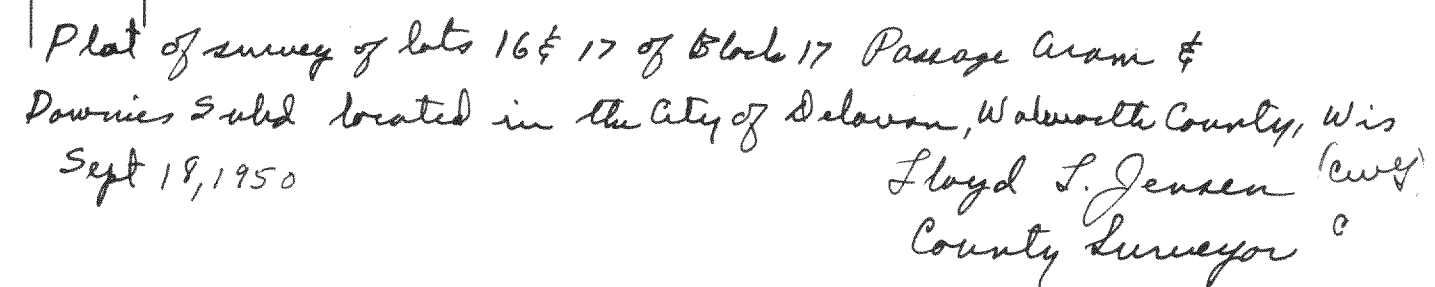

Plot of survey of lot 33 and parcel to the north located in East
Nation Park in Sec. 35 T4N R16E of Walworth County, Wis.
1950
Lloyd T. Jensen (owner)
County Surveyor