



#2357

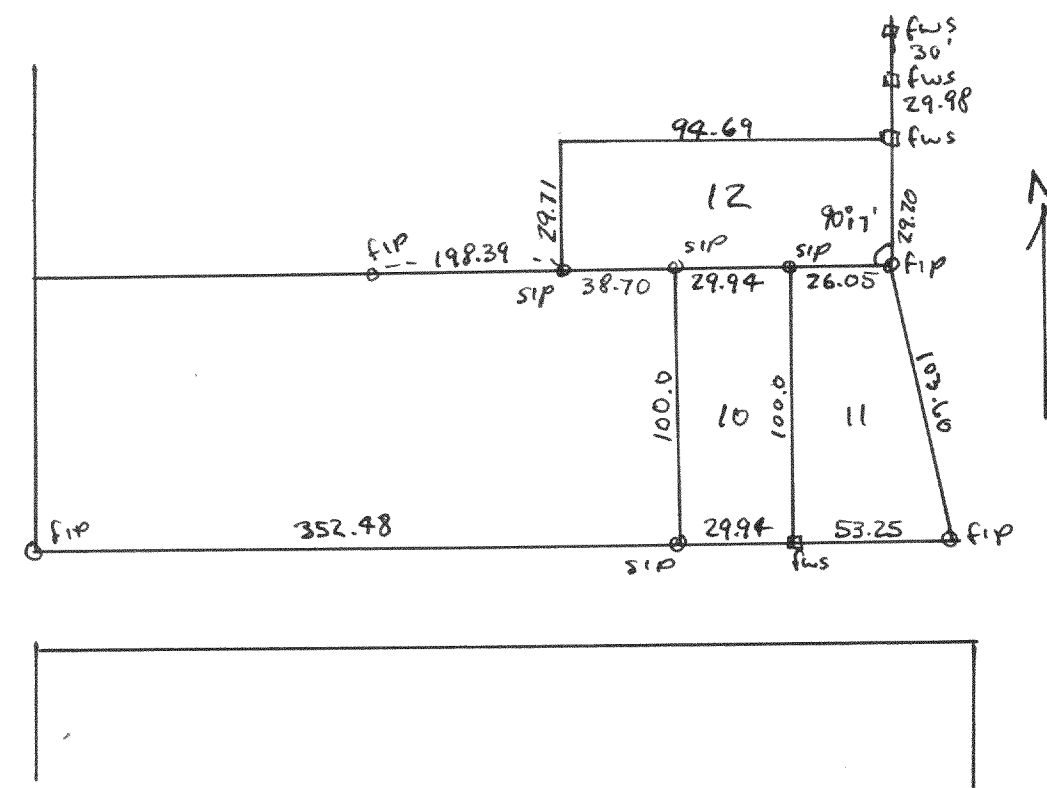


Plot of survey of Tels 10, 11, & 12 of Blk 9 of Skaneateles Swetish
Tribune News Subd located in Sec 9, T3N R15E of Walworth
County, Wisconsin
June 26, 1950
Lloyd L. Jensen
County Surveyor

2358

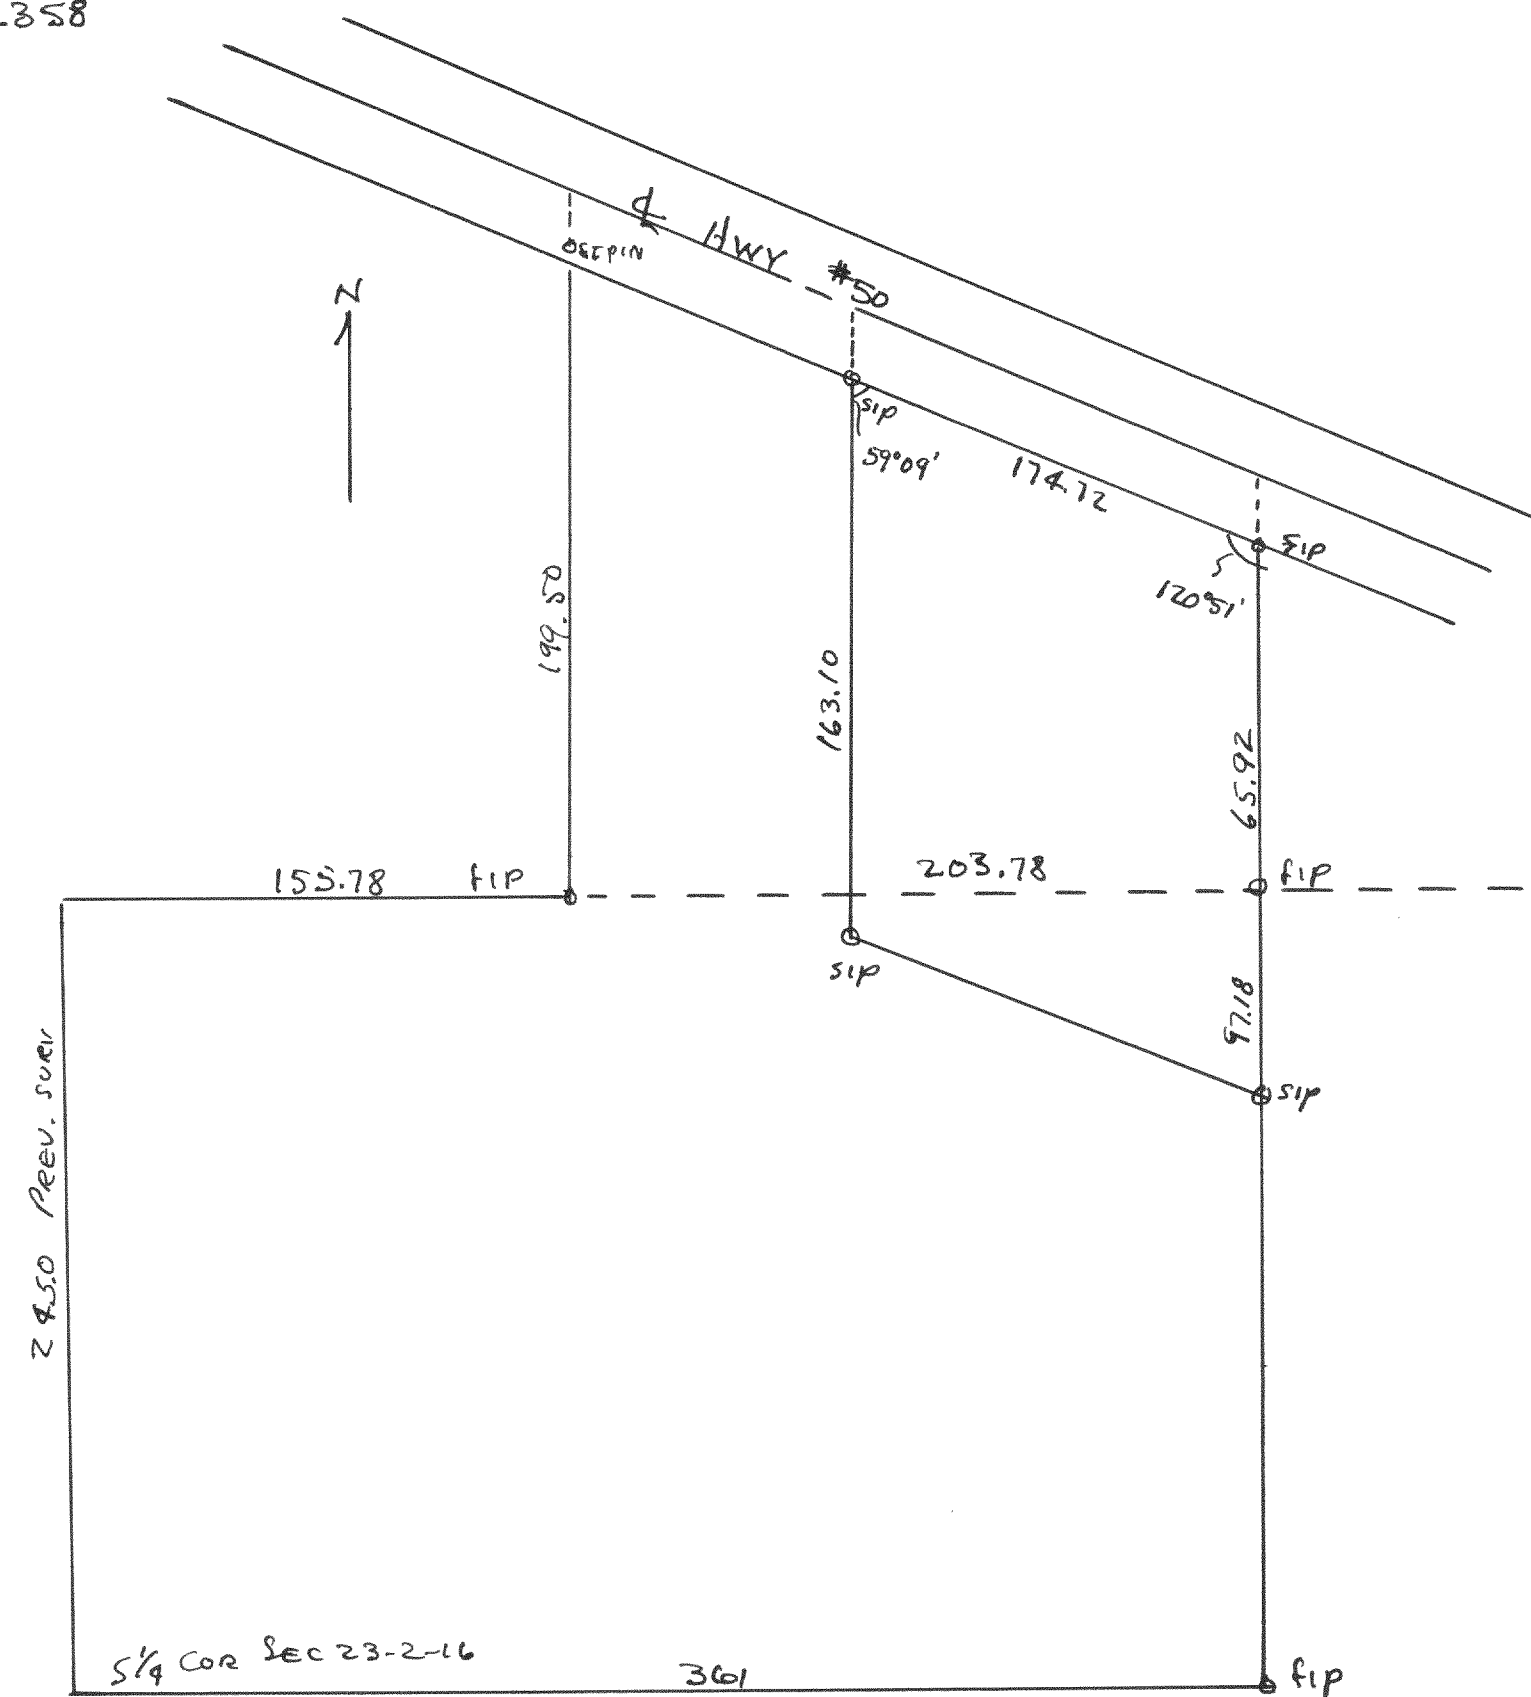

Plat of survey of property sold by Gordon Kent located in
Section 23, T2N R16E of Walworth County, Wisconsin.
1950
Floyd J. Jensen
County Surveyor

2359

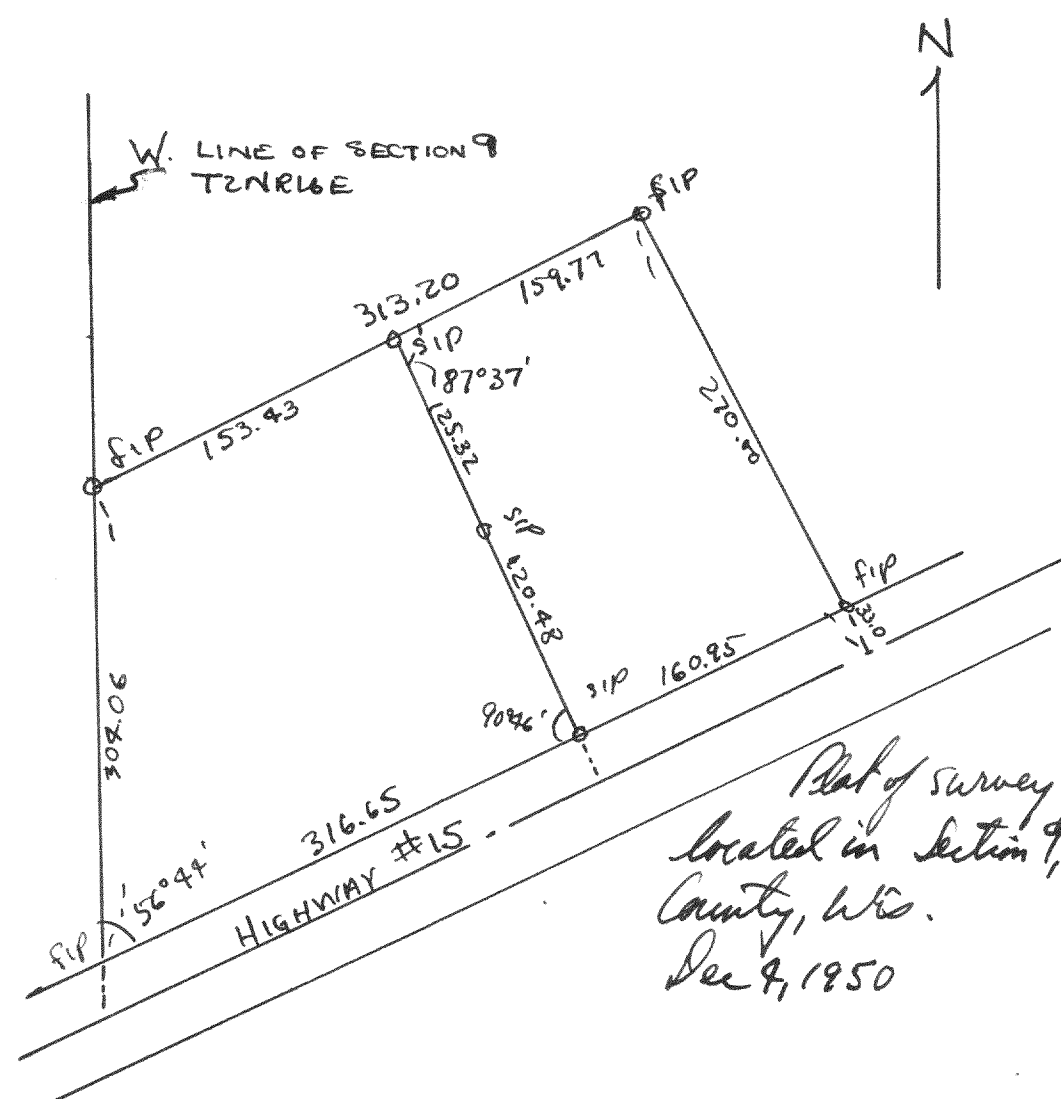

Plat of survey of Beul property
located in Section 9, T20N R36E of Walworth
County, Wis.
Dec 8, 1950

Hoyd L. Jensen
County Surveyor