




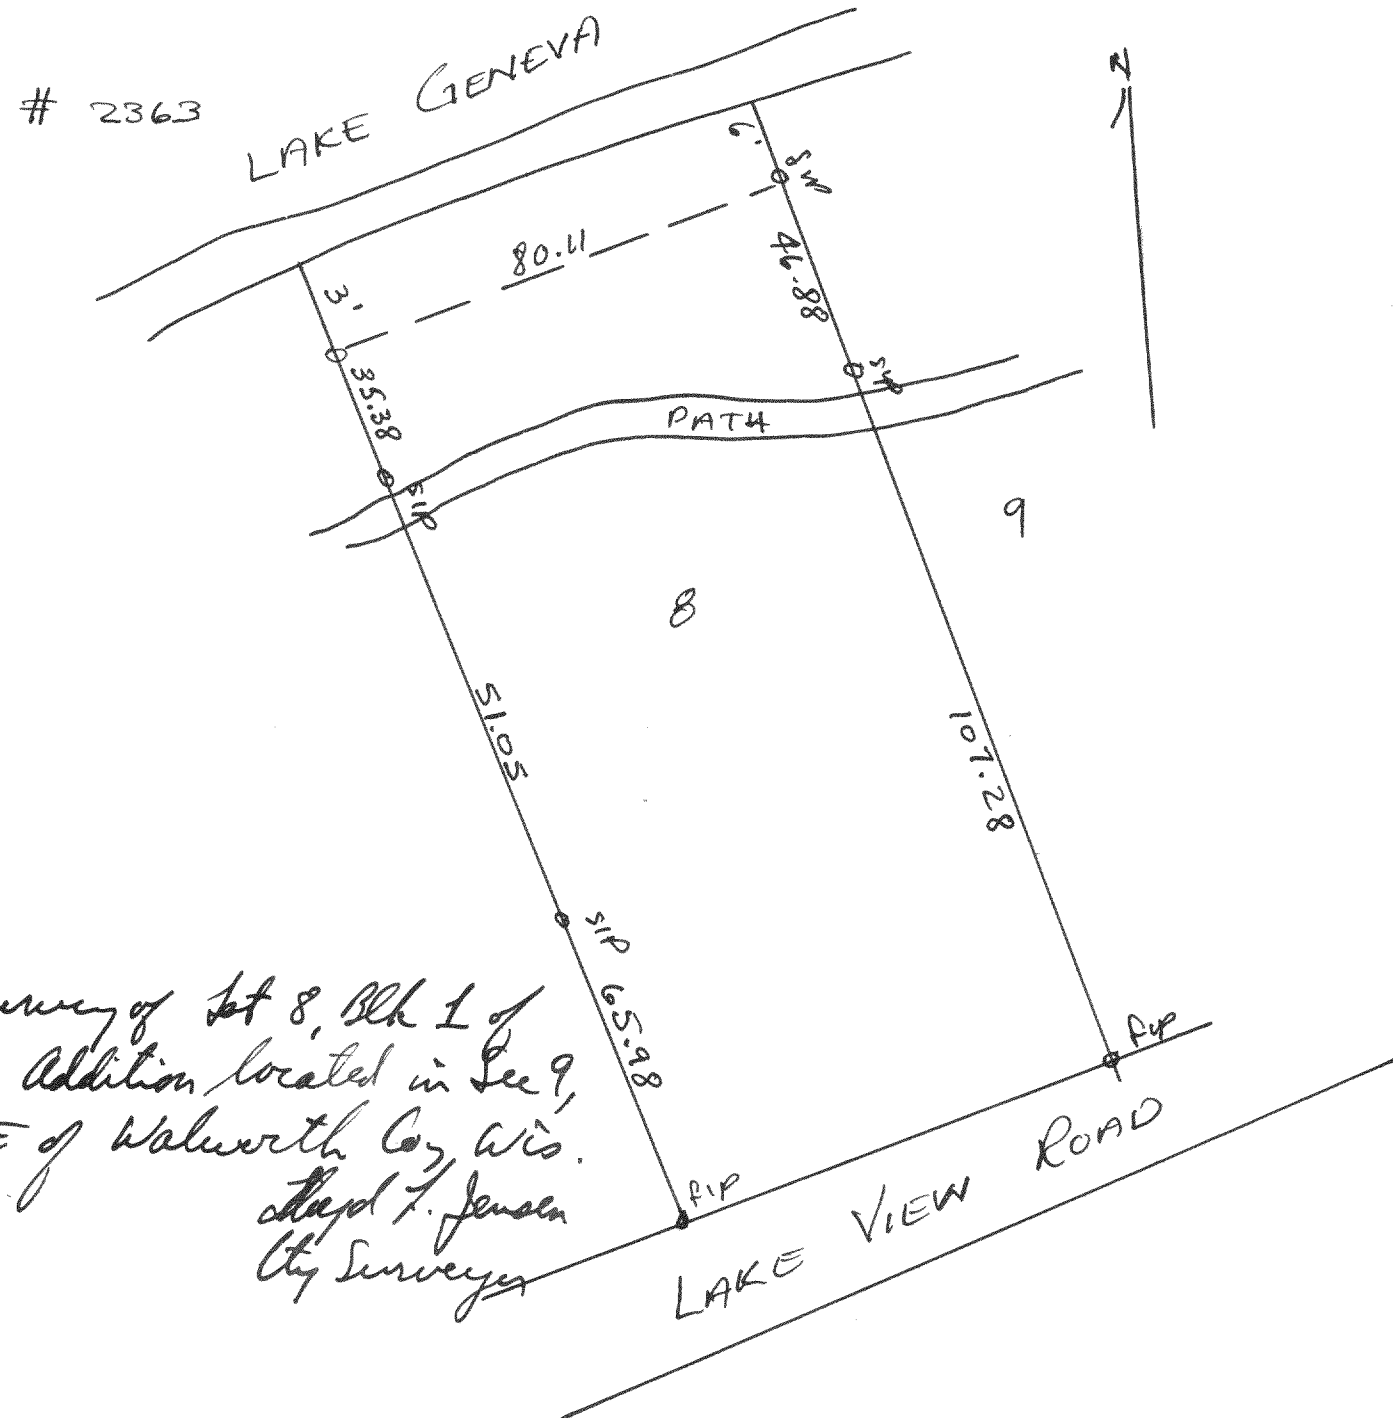

Plat of survey of Lot 8, Blk 1 of
Wooddale Addition located in Sec 9,
TINCITE of Walworth Co., Wis.
1950
Sloyd L. Jensen
City Surveyor

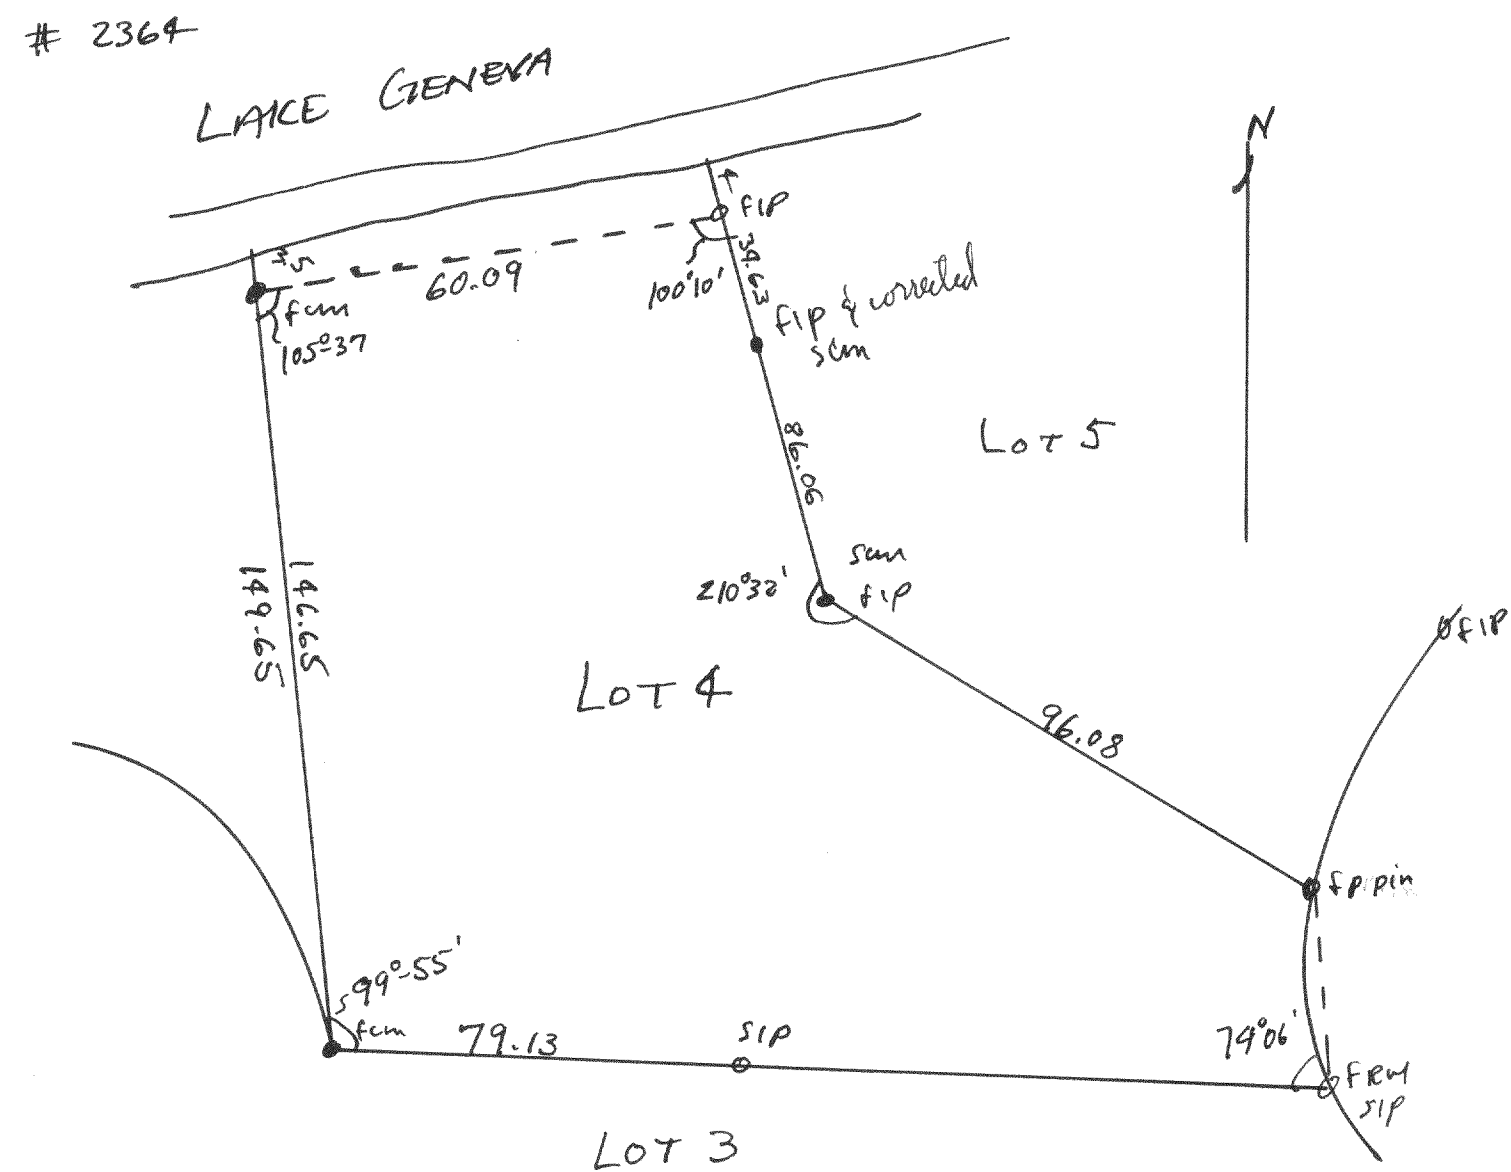

Plat of survey of Lot 4, Block 1 of Wooddale Addition located in Sec 9,
TINCITE, Walworth County, Wis.
Aug 1950
Sloyd L. Jensen
County Surveyor

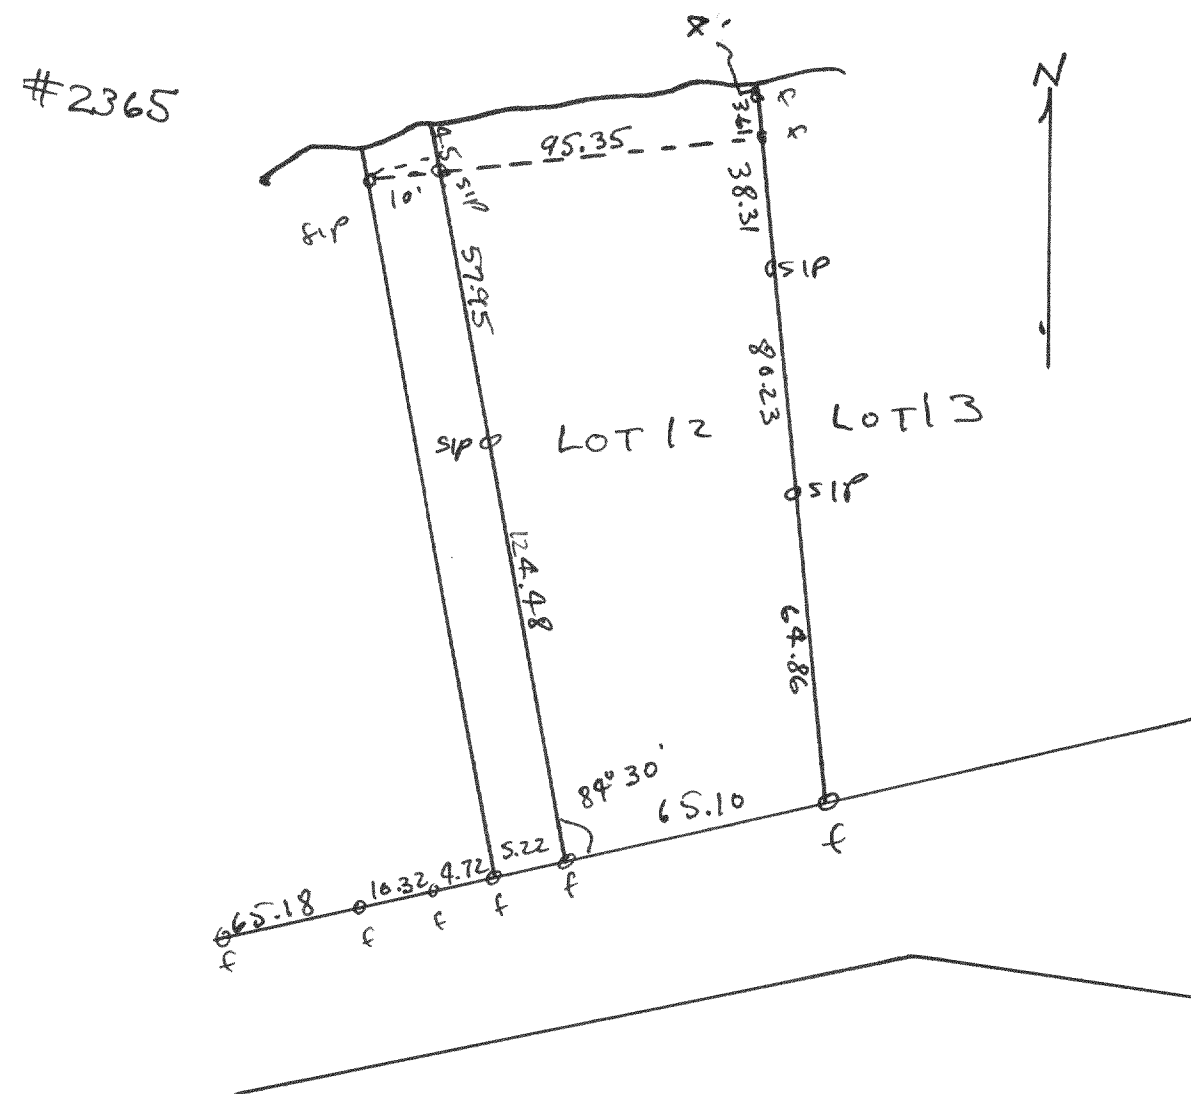

Plat of survey of part of Lot 12, Block 1
of Wooddale Addition located in Sec 9, TINCITE,
of Walworth County, Wis.
Aug 1950
Sloyd L. Jensen
County Surveyor