



2370

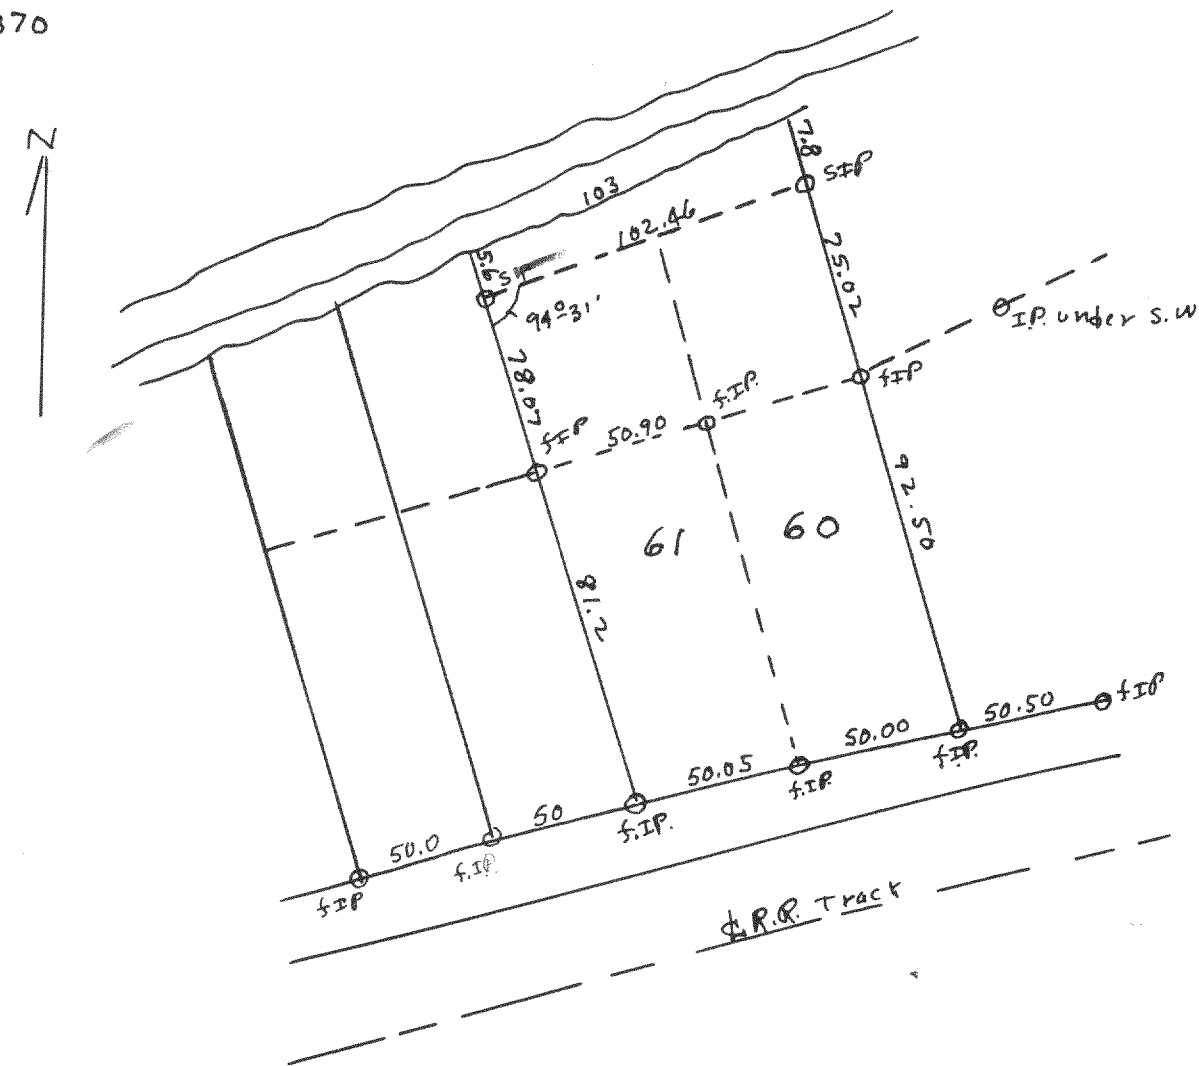


Plot of survey of lots 60 & 61 of Consumers Company
Subd. located in Section 32 T 2 N R 17 E of Halworth County, N.D.
Oct 4, 1950
Stacy S. Jensen Esq.
County Surveyor

#2371

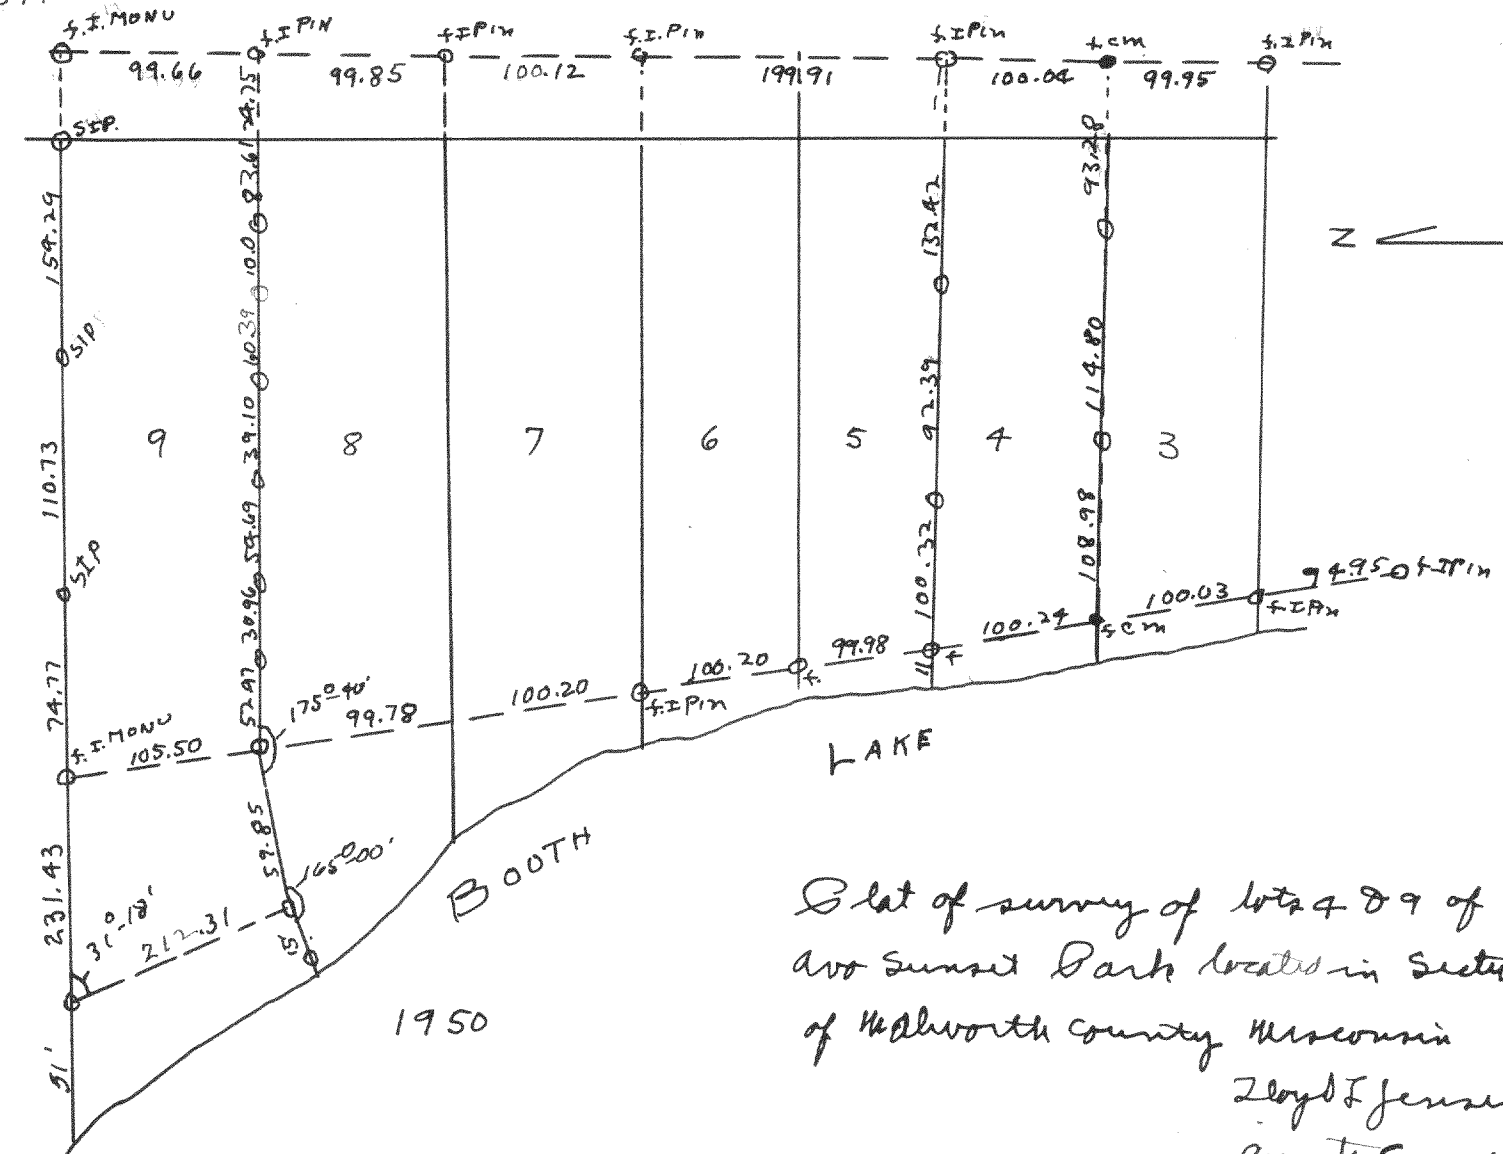

Plot of survey of lots 4 & 9 of
Two Sunset Park located in Section 13 T4N R12E
of Walworth County Wisconsin
Zloyd I Jensen ~~St~~
County Surveyor


#2373

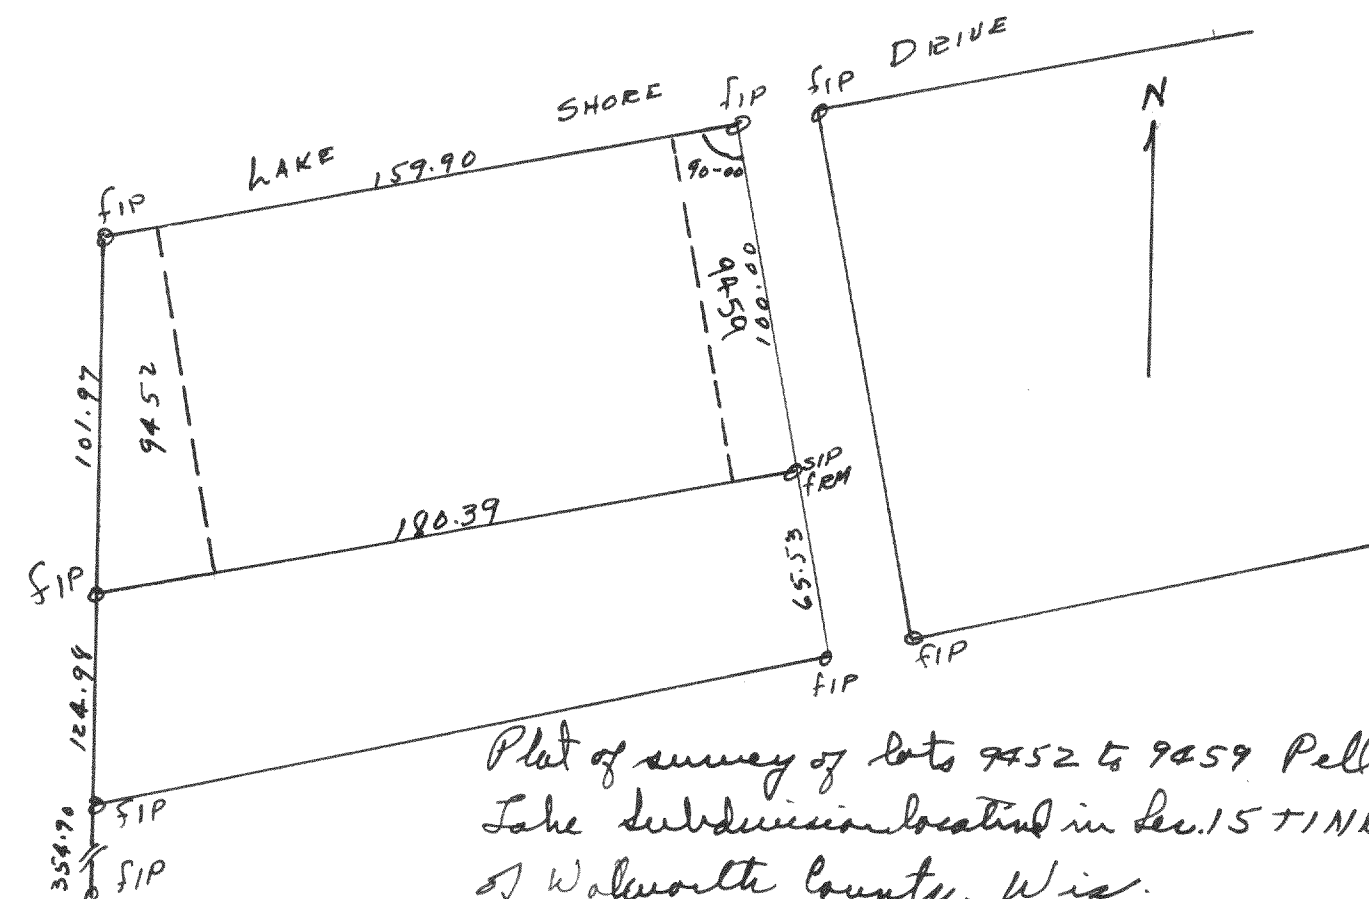

Plat of survey of lots 7452 to 7459 Pell
Lake subdivision located in Sec. 15 T19N R18E
of Walworth County, Wis.

Floyd L. Jensen
County Surveyor.
Cass

2372

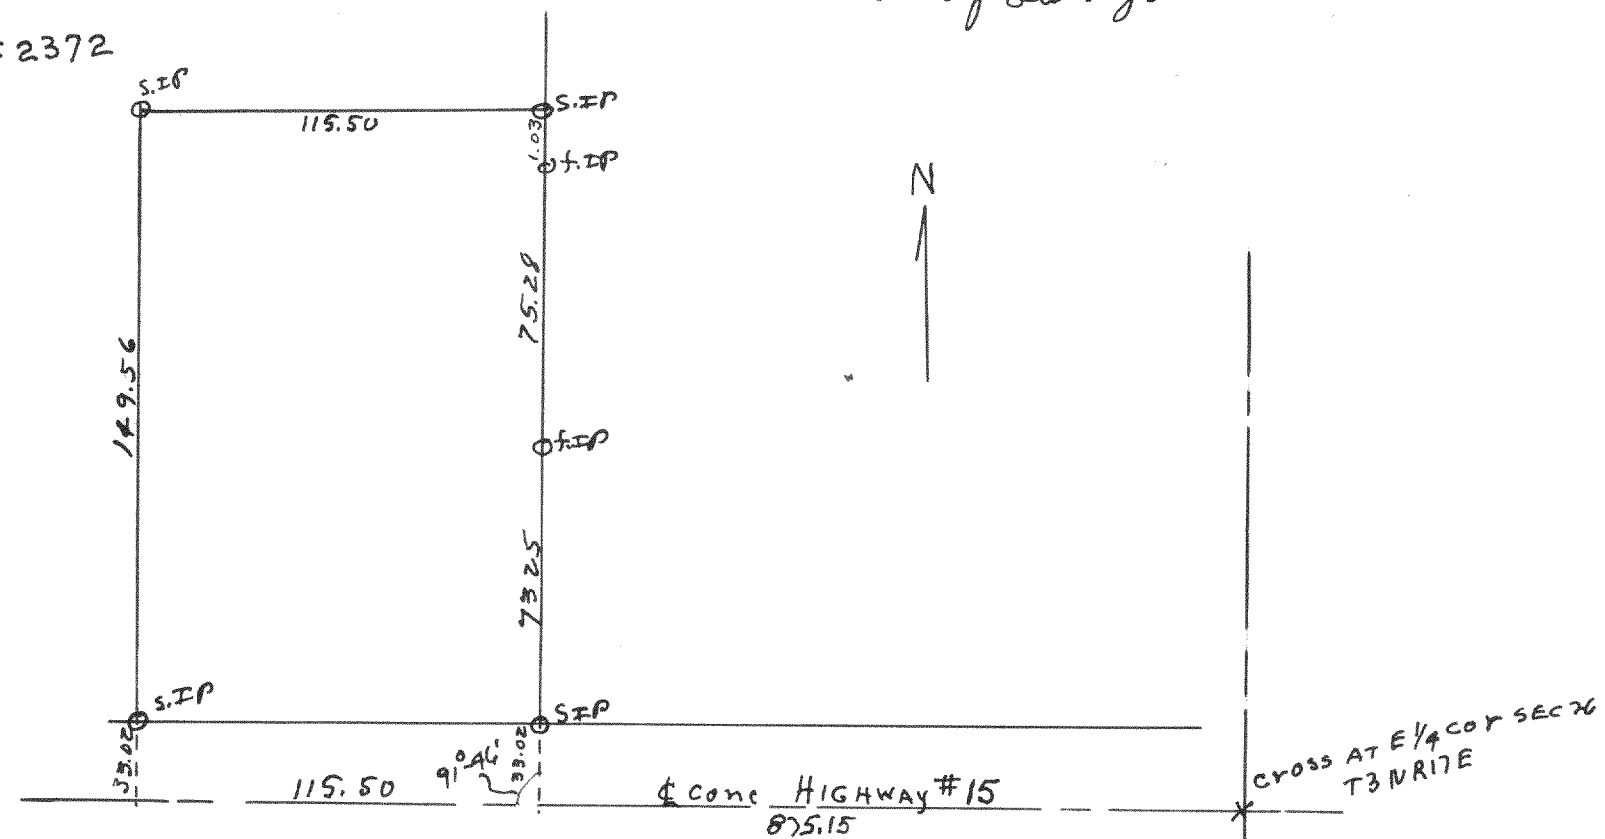

Plat of survey of a parcel of land located in the NE 1/4 of Sec 26
T3N R17E of Walworth County, Wis.
June 16, 1950
Floyd L. Jensen
County Surveyor