


## SURVEY NO. 1285

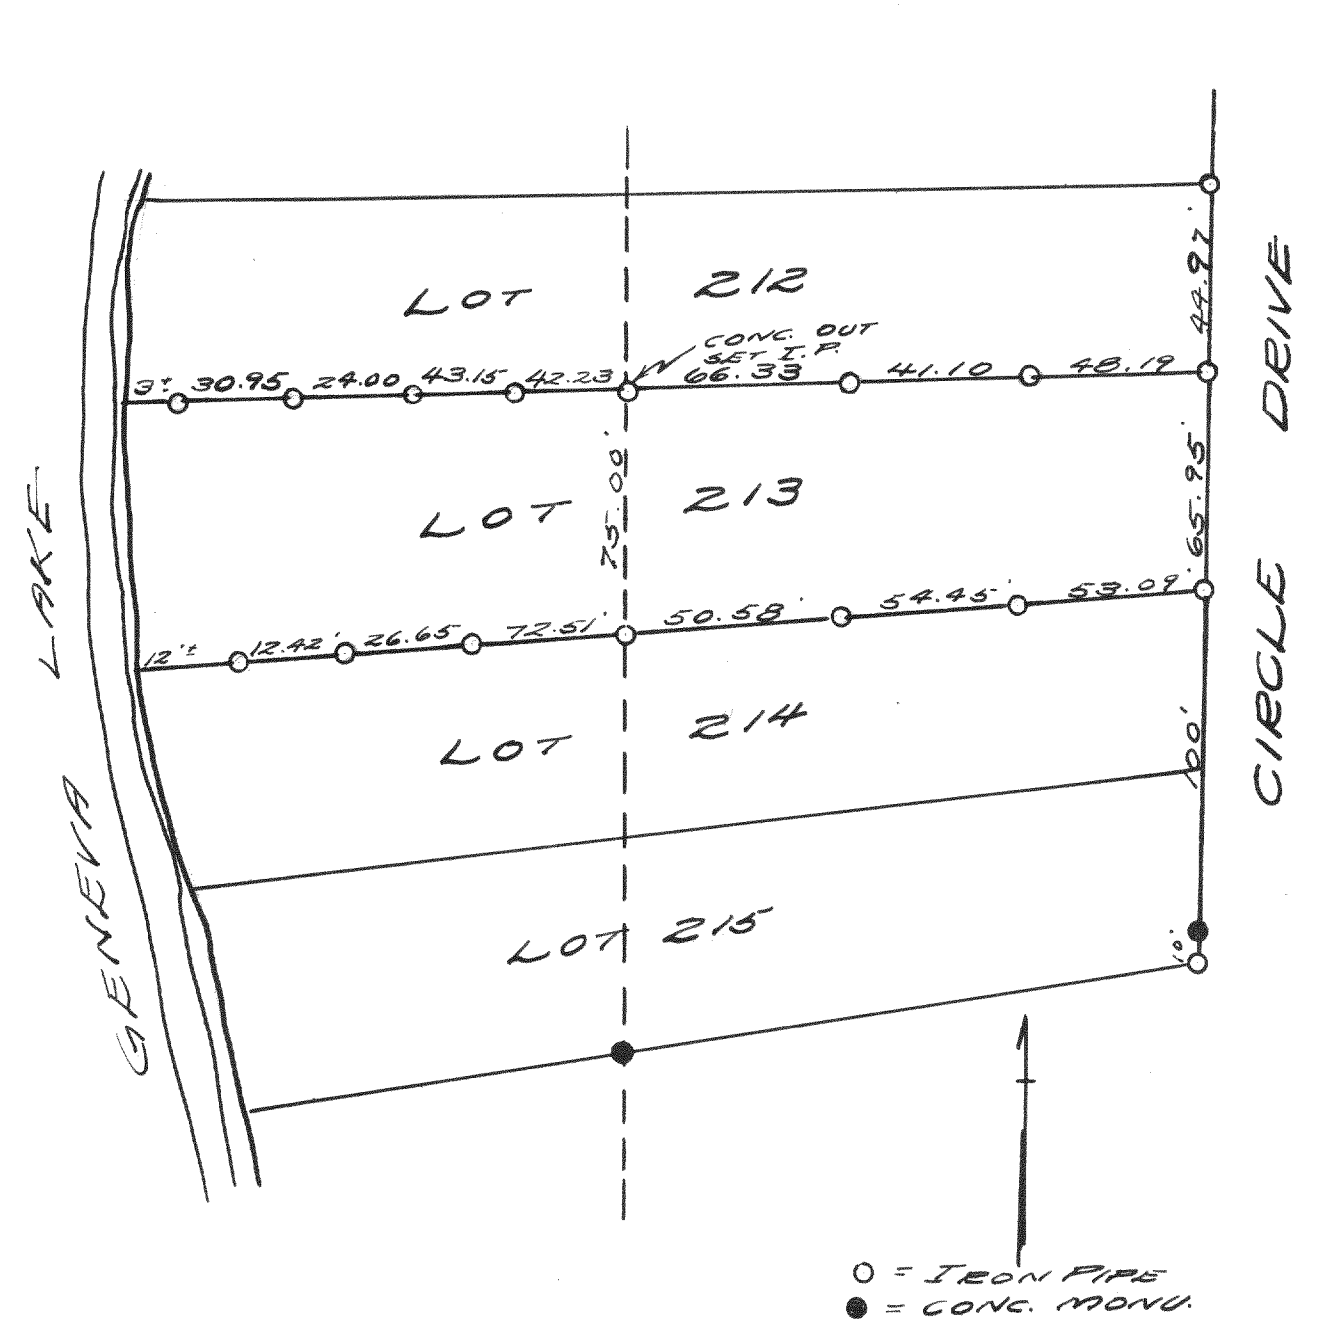


PLAT OF SURVEY OF LOT 213 OF THE  
THIRD ADDITION TO CEDAR POINT PARK,  
IN THE VILLAGE OF WITAS BAY, WALWORTH CO.,  
WISCONSIN.

JUNE, 1941

Lloyd L. Jensen  
S.E.J.

## SURVEY NO. 1286

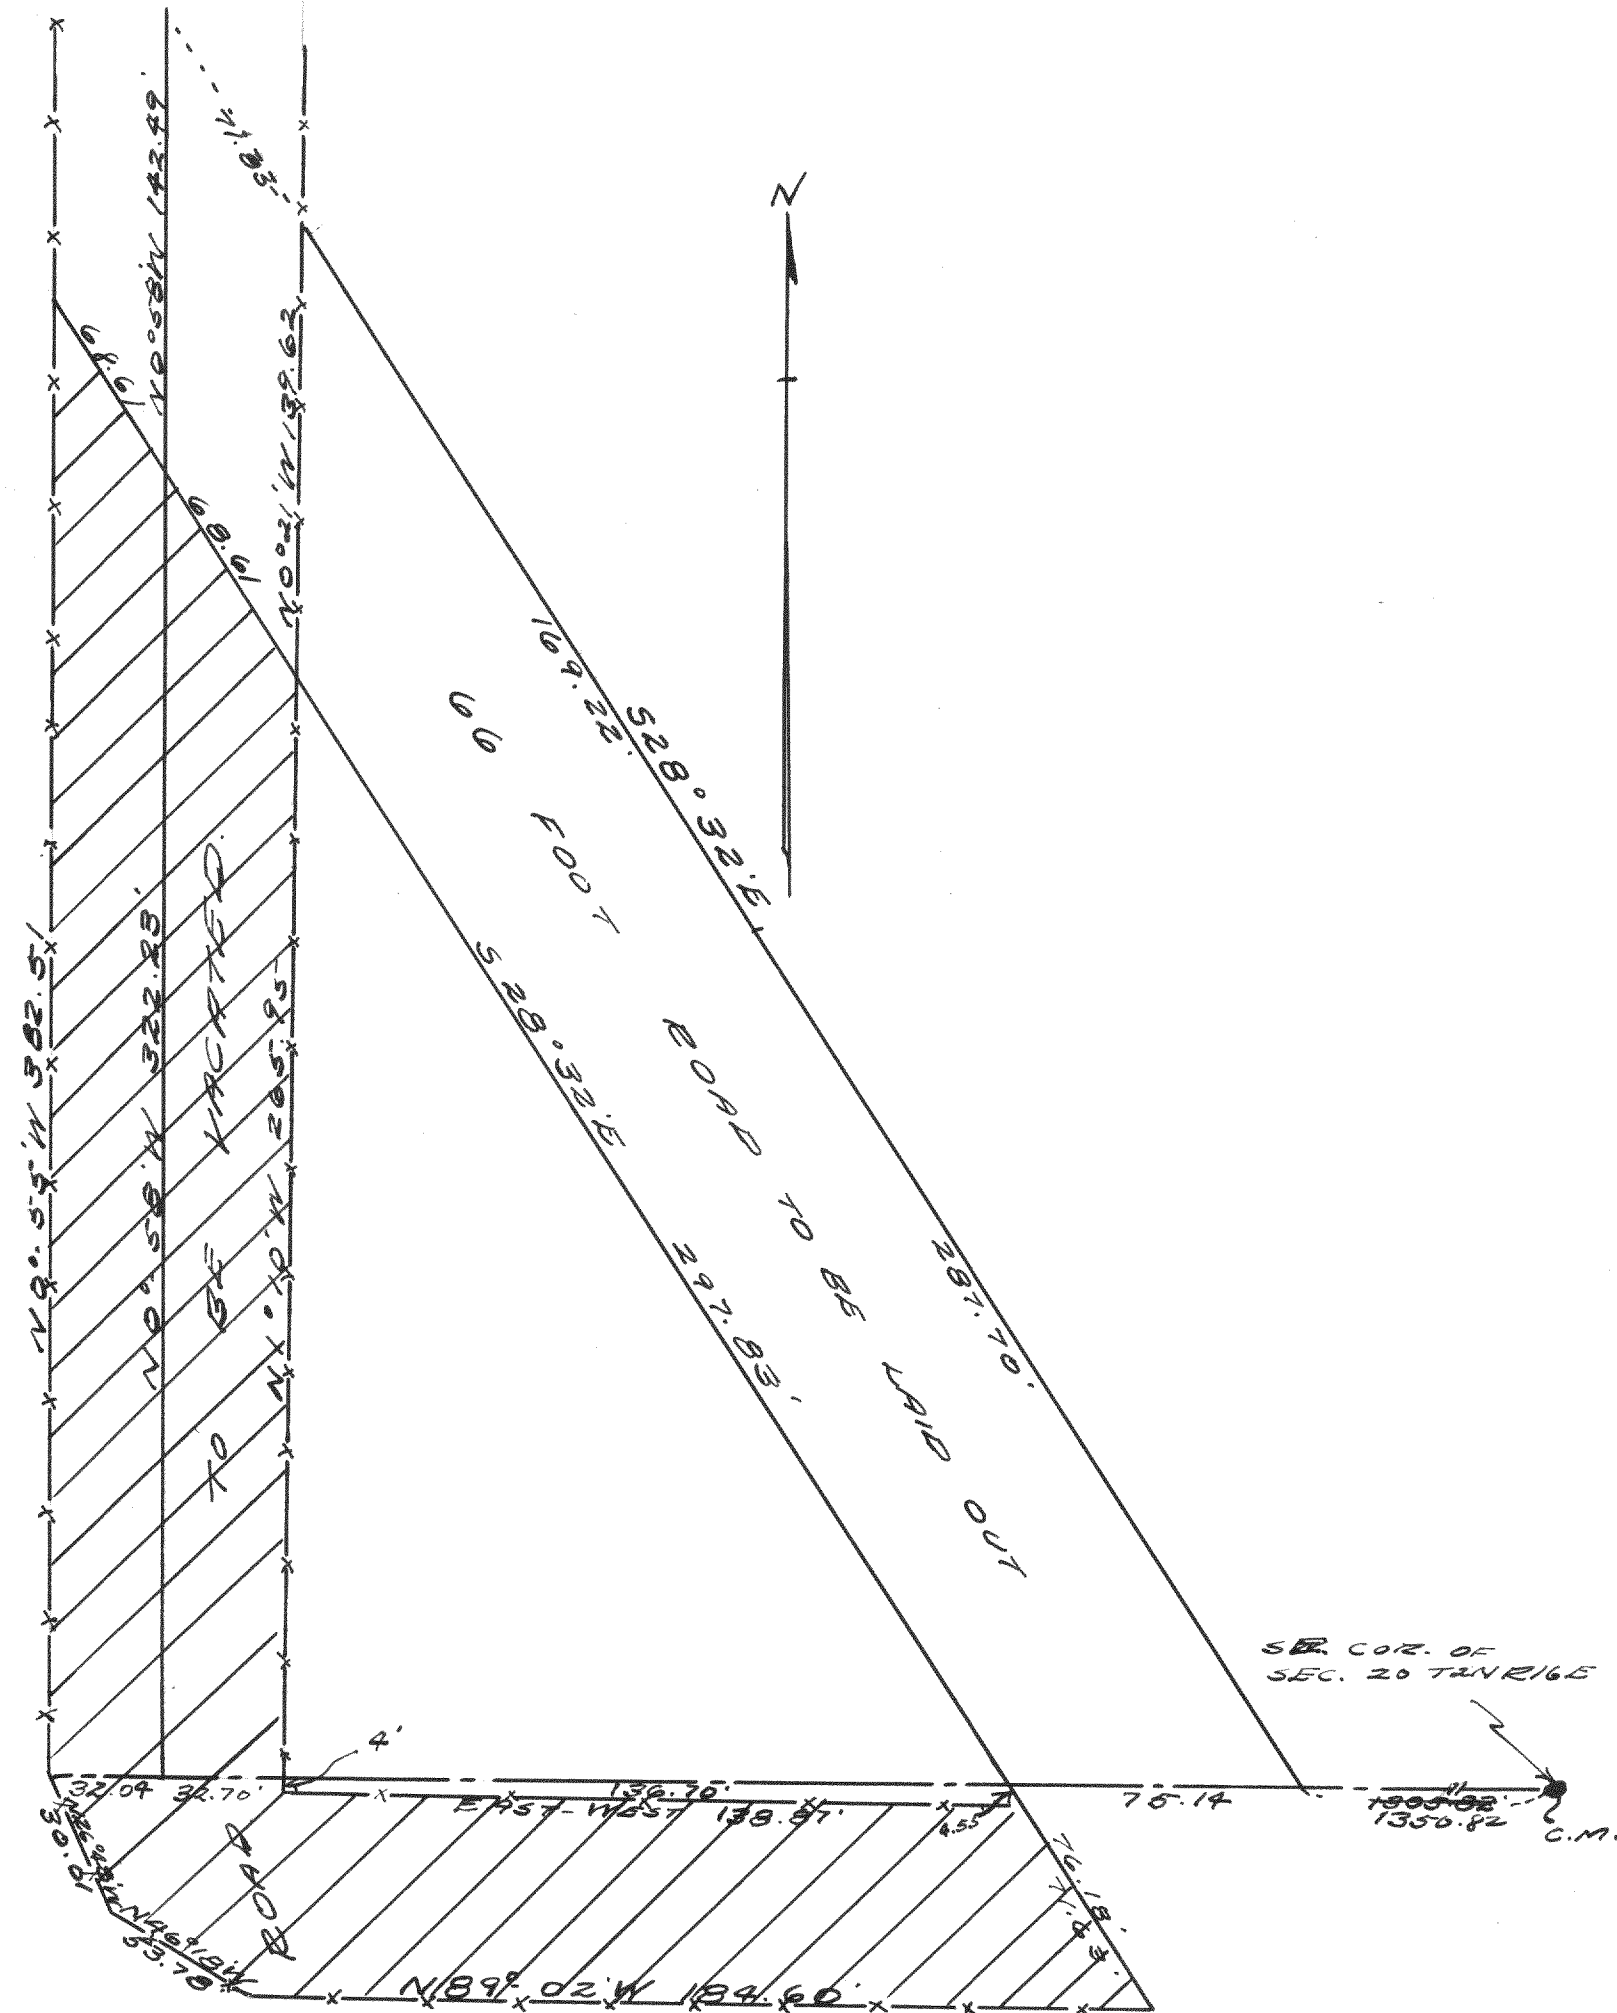

PLAT OF SURVEY OF A ROAD TO BE Laid OUT  
AND A ROAD TO BE VACATED IN THE SE 1/4 OF  
SECTION 20 T2N R16E, WALWORTH CO., WISC.

FEB., 1942

Lloyd L. Jensen  
S.E.J.