



2374

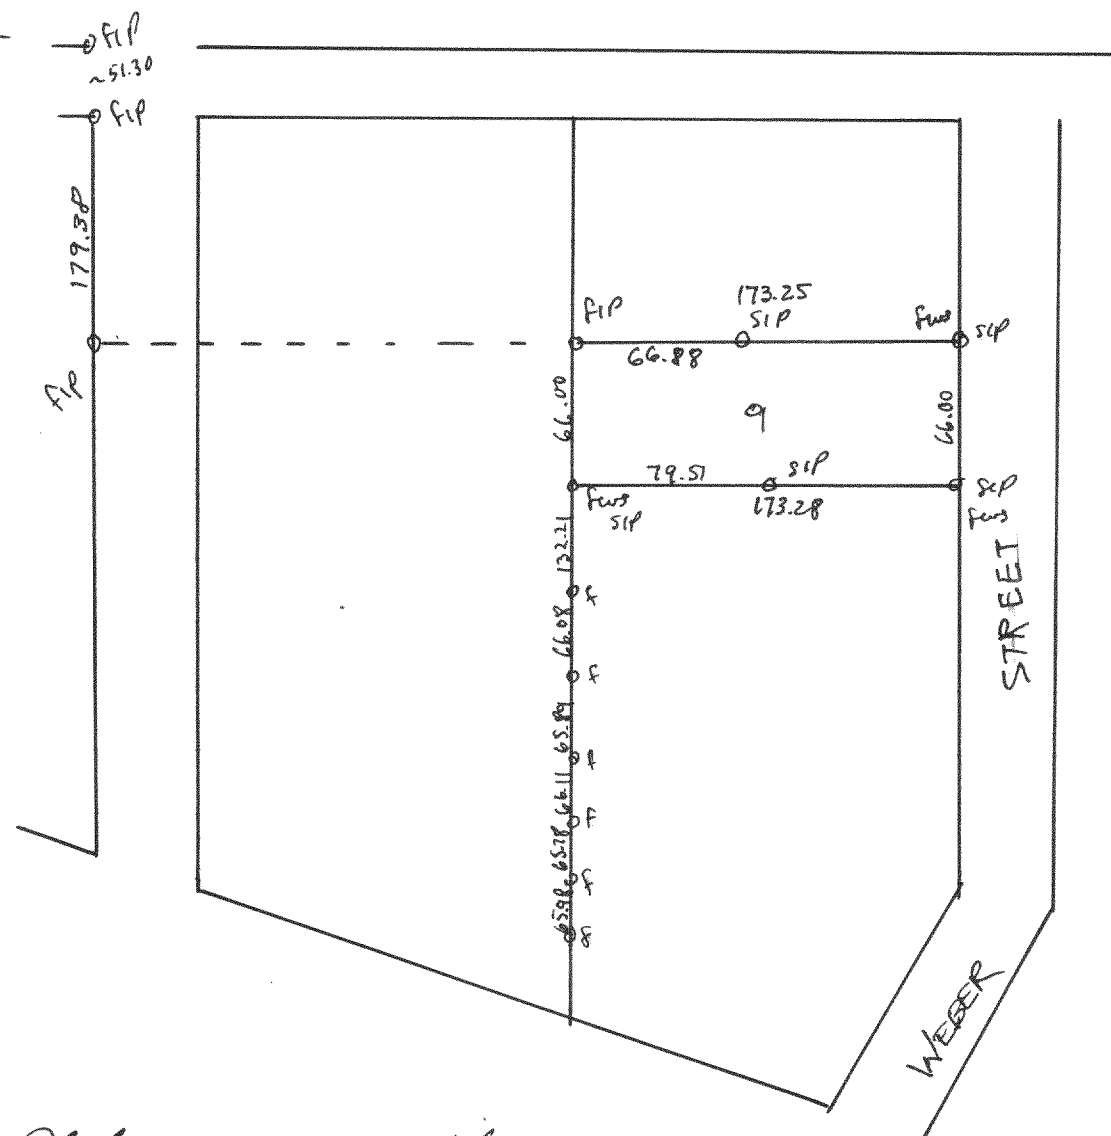

Plat of survey of Lot 9, Block 1, Grandells & Swinnys Subd. located in the Village of Walworth, Walworth Co., Wis.
Sept 16, 1950
Floyd S. Jensen
County Surveyor

2375

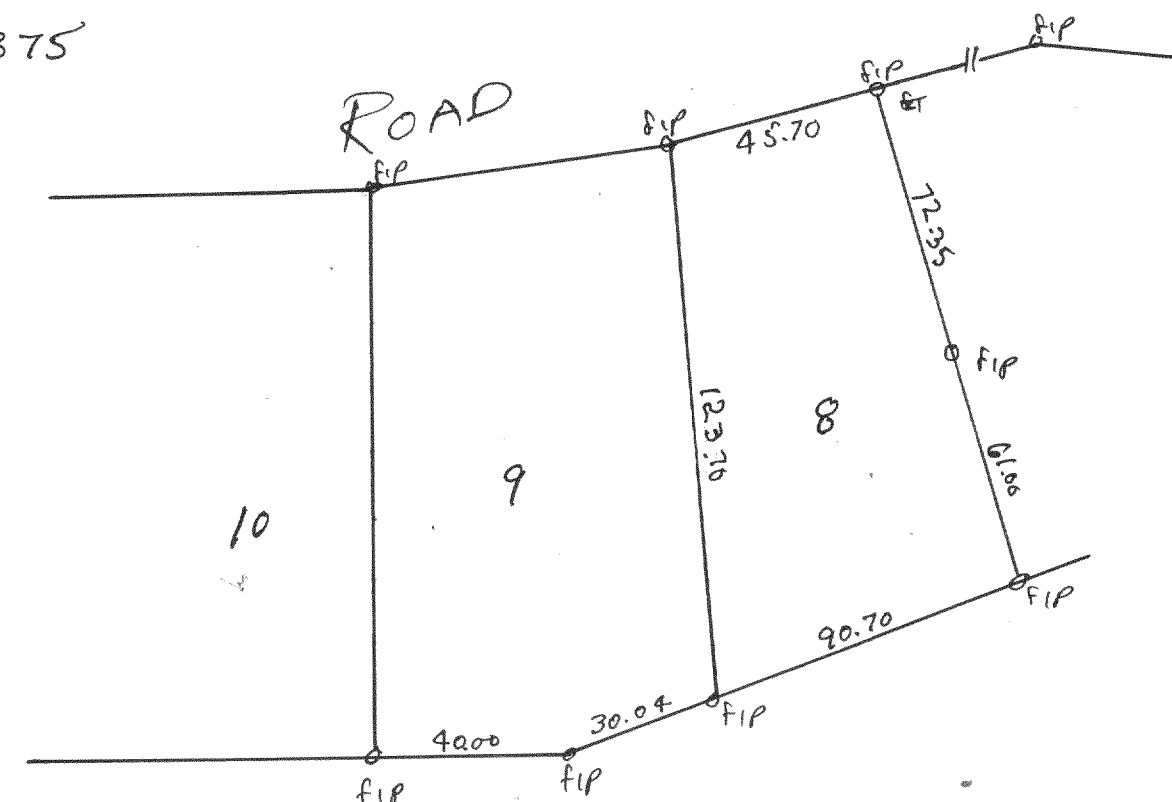

Plat of survey of Lot 8, Block 21, Lake Geneva Manor located in the City of Lake Geneva, Walworth Co., Wis.
1950

Floyd S. Jensen
County Surveyor

2376

Survey of Oak Shores Subdivision located in Sec. 18, T1N R17E of Walworth County, Wisconsin as or file in the Register of Deeds office at Elkhorn, Wis.
1950

Floyd S. Jensen
County Surveyor

2777

Survey of Laurel Heights Subdivision located in the NE 1/4 of the NW 1/4 of Sec 17, T2N R16E, City of Delavan Walworth Co., Wis. Plat is on file in the Register of Deeds office in the County Court House in Elkhorn, Wis.

1950

Floyd S. Jensen
County Surveyor