



562

2382

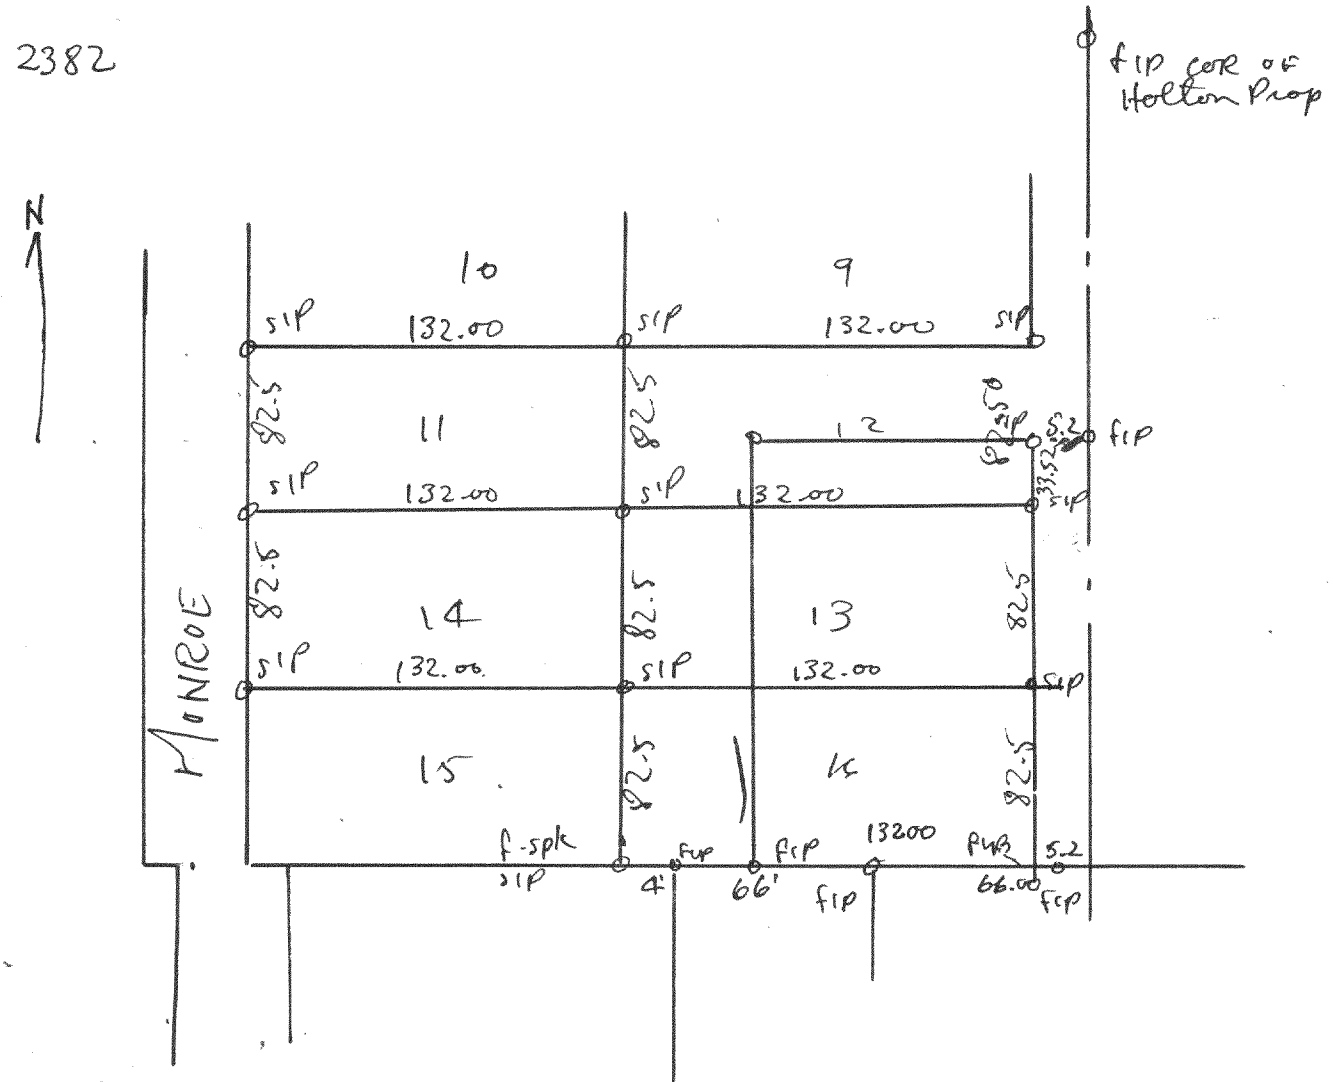

Plot of survey of Lots 11-14, 16 of Block 1
of Harrison's Add. located in the City of Allenton
Walworth County, Wis.
Nov. 1950
Lloyd A. Johnson
County Surveyor

2383

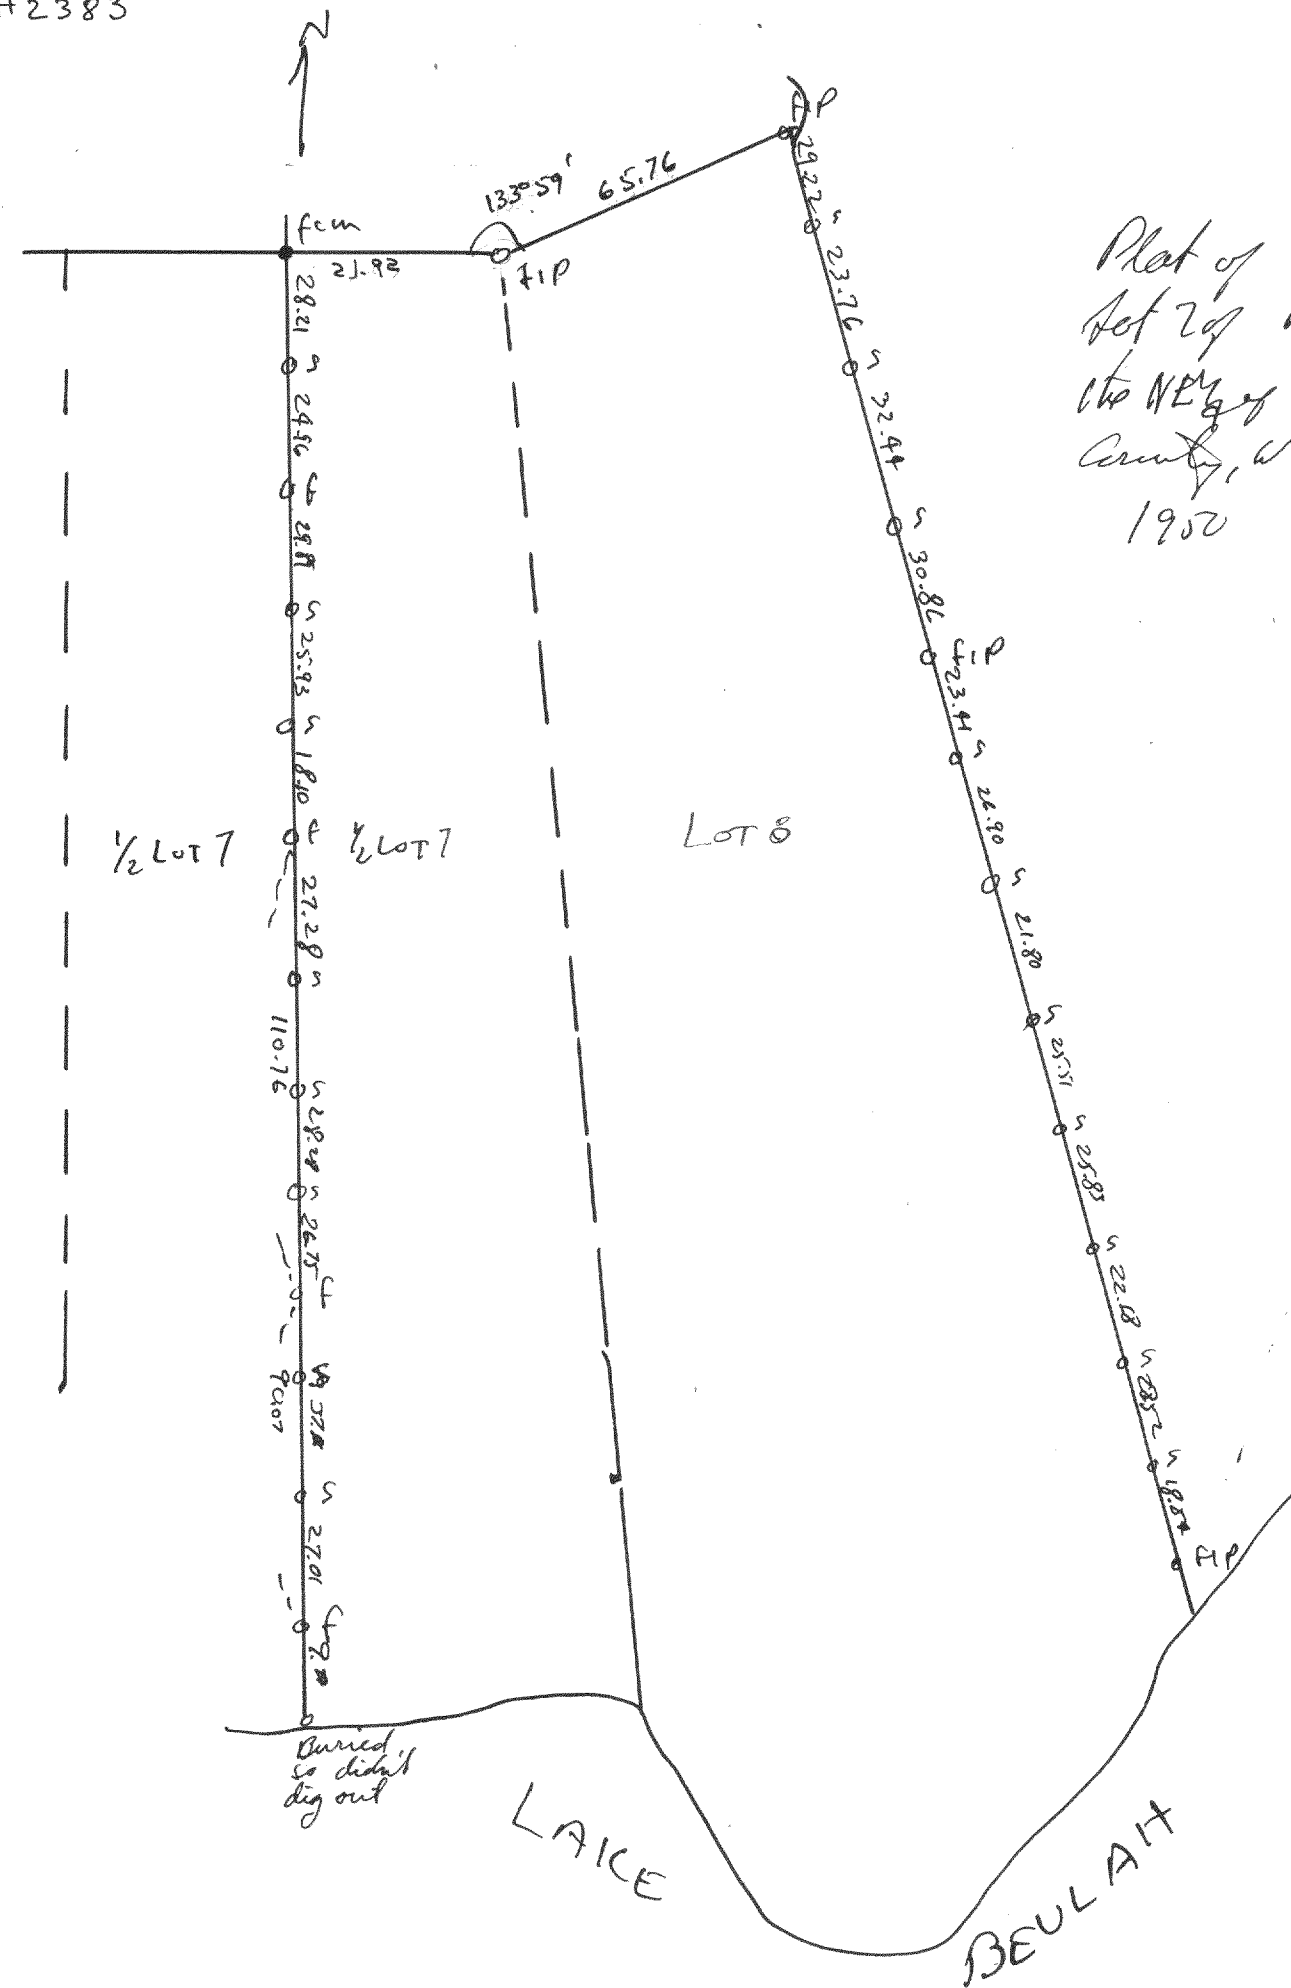

Plot of survey of Lot 8 & part of
Lot 7 of Romadka Park located in
the NE 1/4 of Section 8, T4N R20W of Walworth
County, Wis.
1950
Lloyd A. Johnson
County Surveyor