


2384

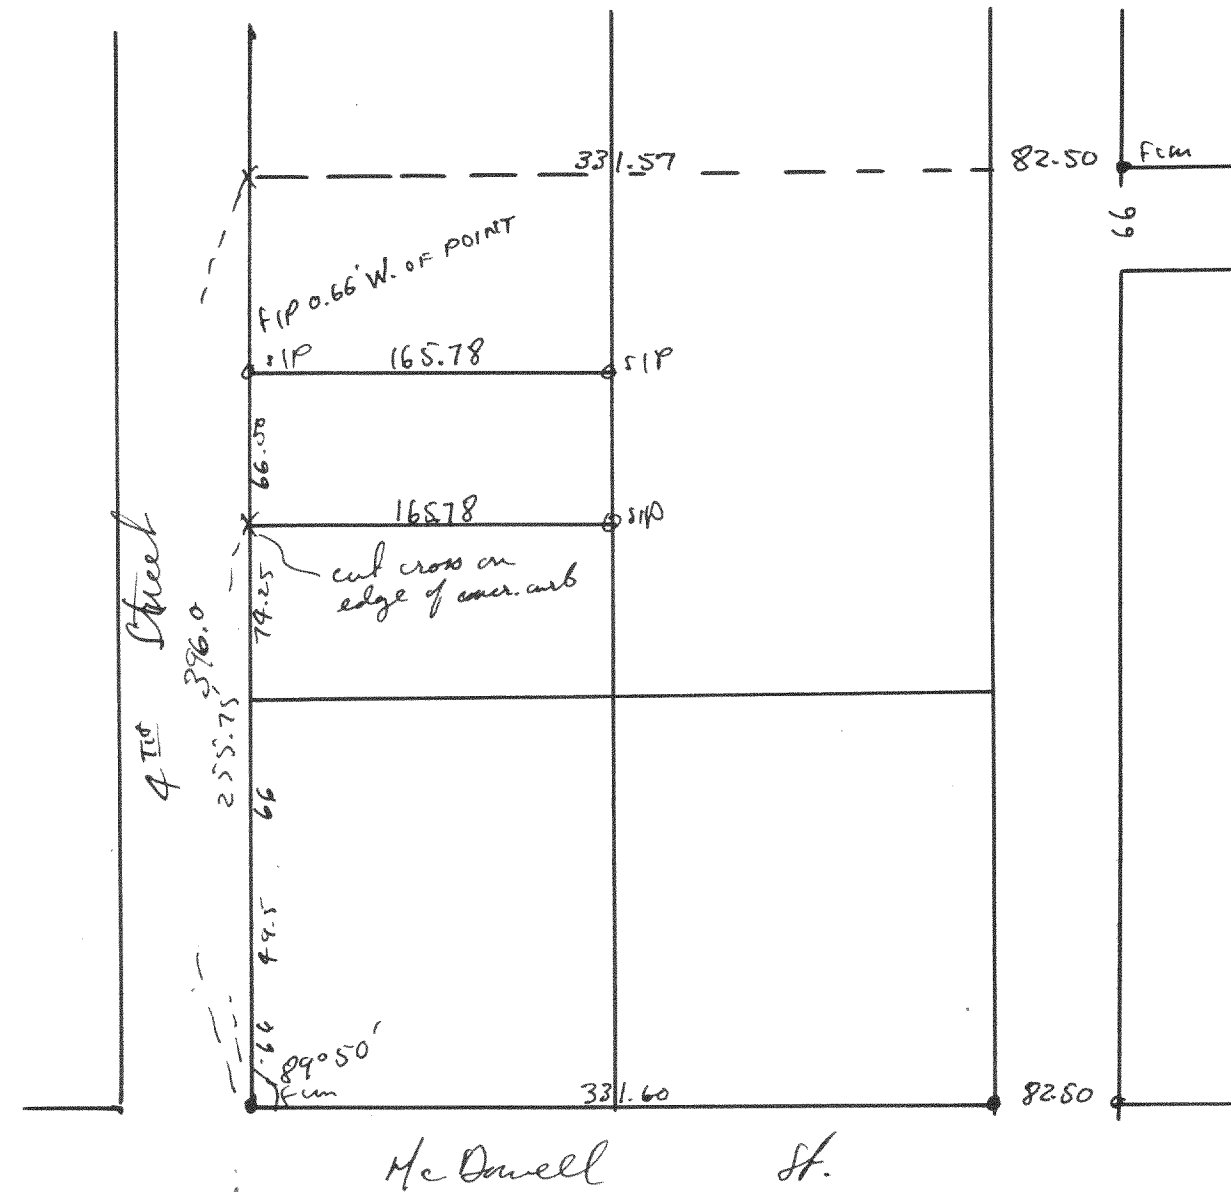


Plat of survey of a parcel of land located on
N 4th St. in the NE 1/4 Sec 18, T2N R10E, City of Wauwatosa,
Walworth County, Wis.
October 21, 1950
Lloyd L. Jensen
County Surveyor

2386

Survey of Unit 6, Addition A, Country Club
Estates located in Sec 14, T2N R10E, Village of
Fontana, Walworth County, Wis.
Plat is on record in the Register of Deeds Office
in the Court House, Elkhorn, Walworth
County, Wis.
Dec 1950
Lloyd L. Jensen
County Surveyor

2385

W 1/4 Corner
Sec 34-2-17

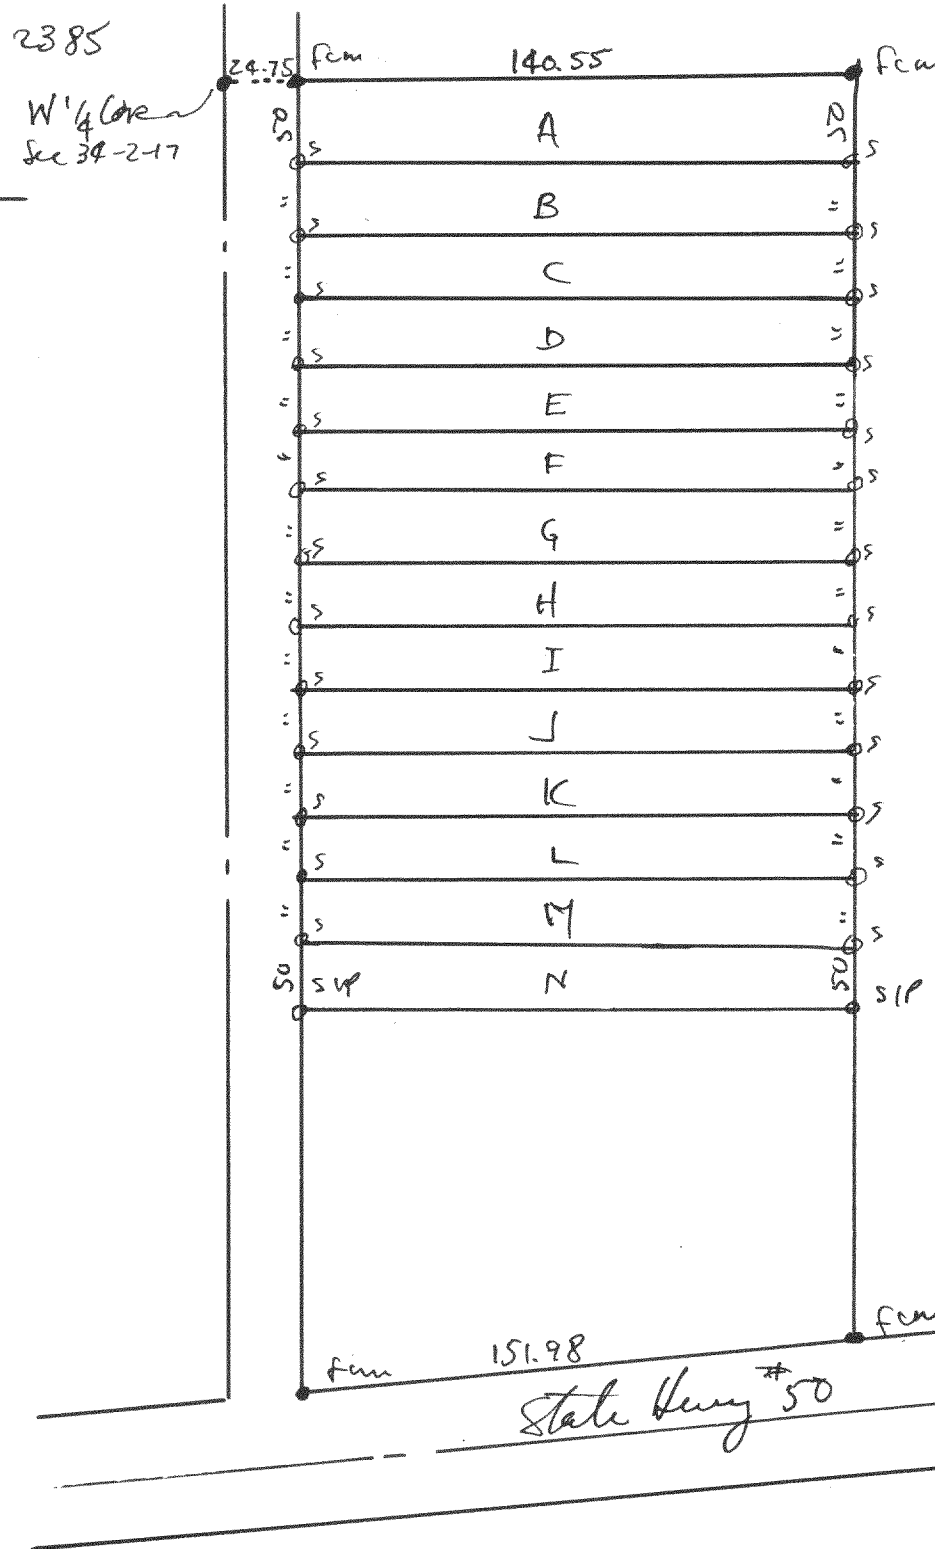

Plat of survey of land located in the SW 1/4 of Sec 34,
T2N R10E Walworth County, Wis.
1948
Lloyd L. Jensen
County Surveyor