



2387

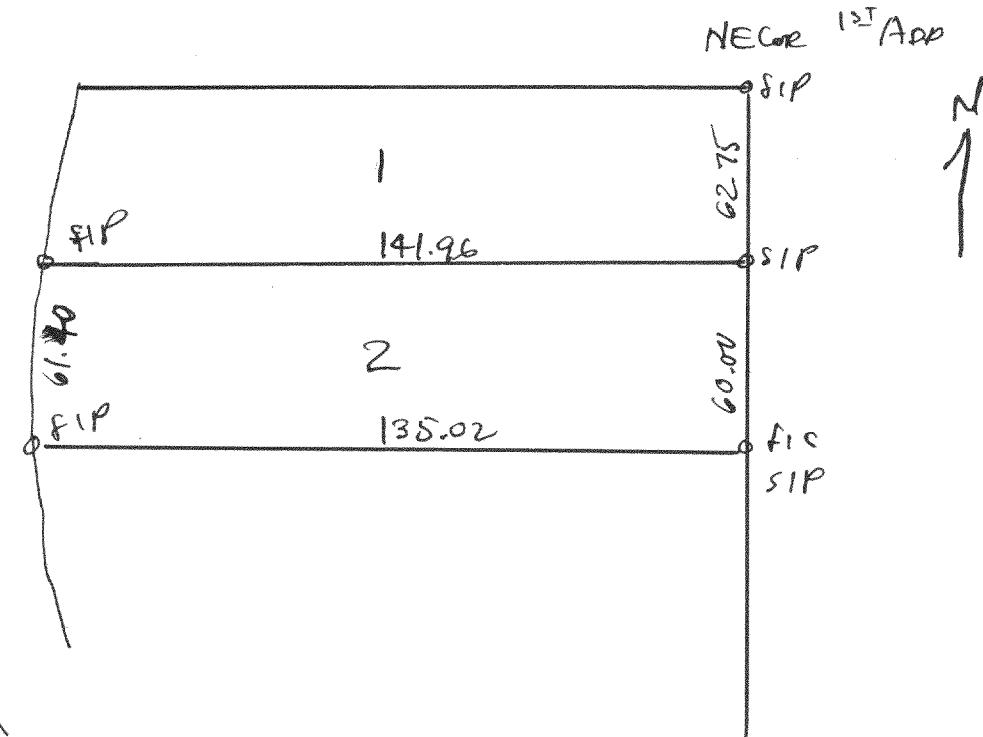

Plat of survey of Lot 2, Block 7 of Indian Wells
1st Addition located in the Village of Fontana
Walworth County, Wisconsin
July 7, 1950
Hoyd L. Jensen


2388

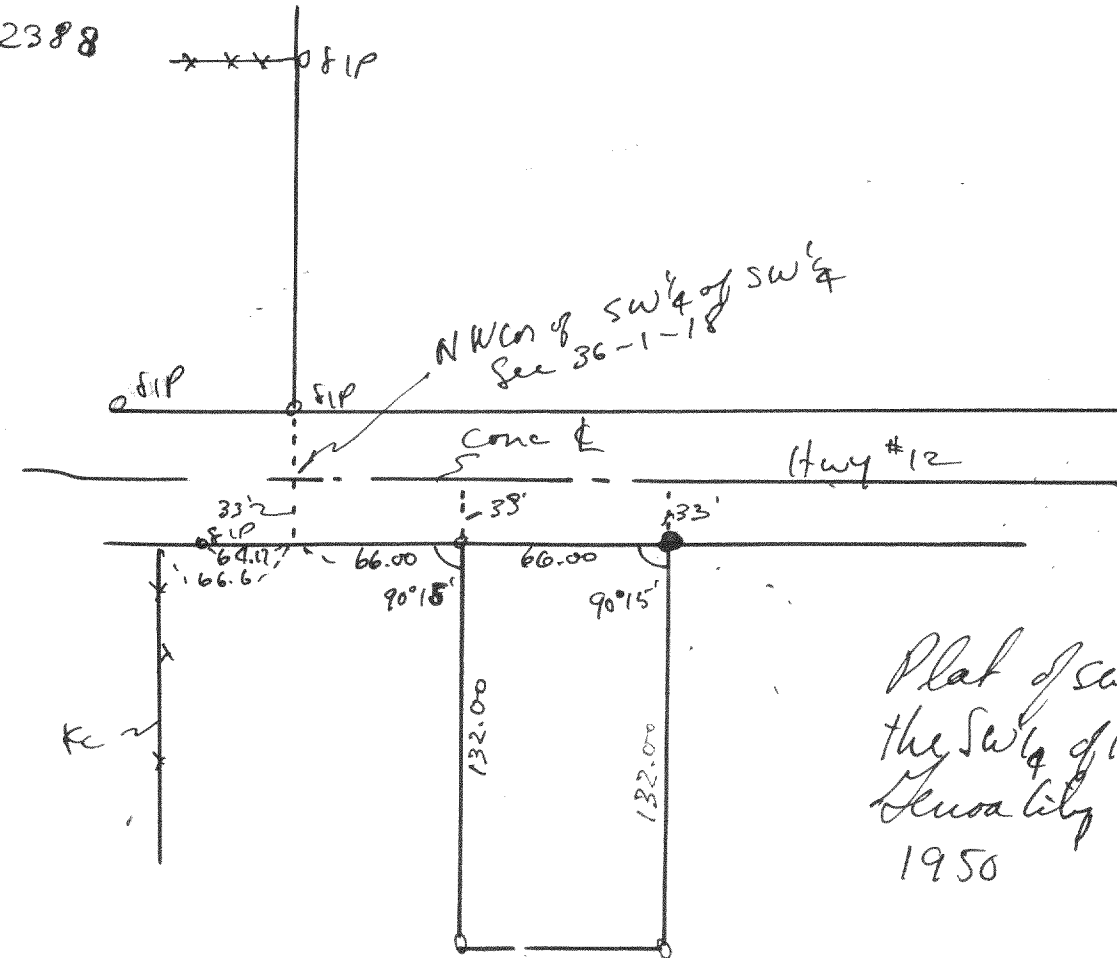

Plat of survey of a parcel of land located in
the SW 1/4 of the SW 1/4 of Sec 36, T14N R18E, Village of
Geneva City, Walworth County, Wis.
1950

Hoyd L. Jensen
County Surveyor

2389

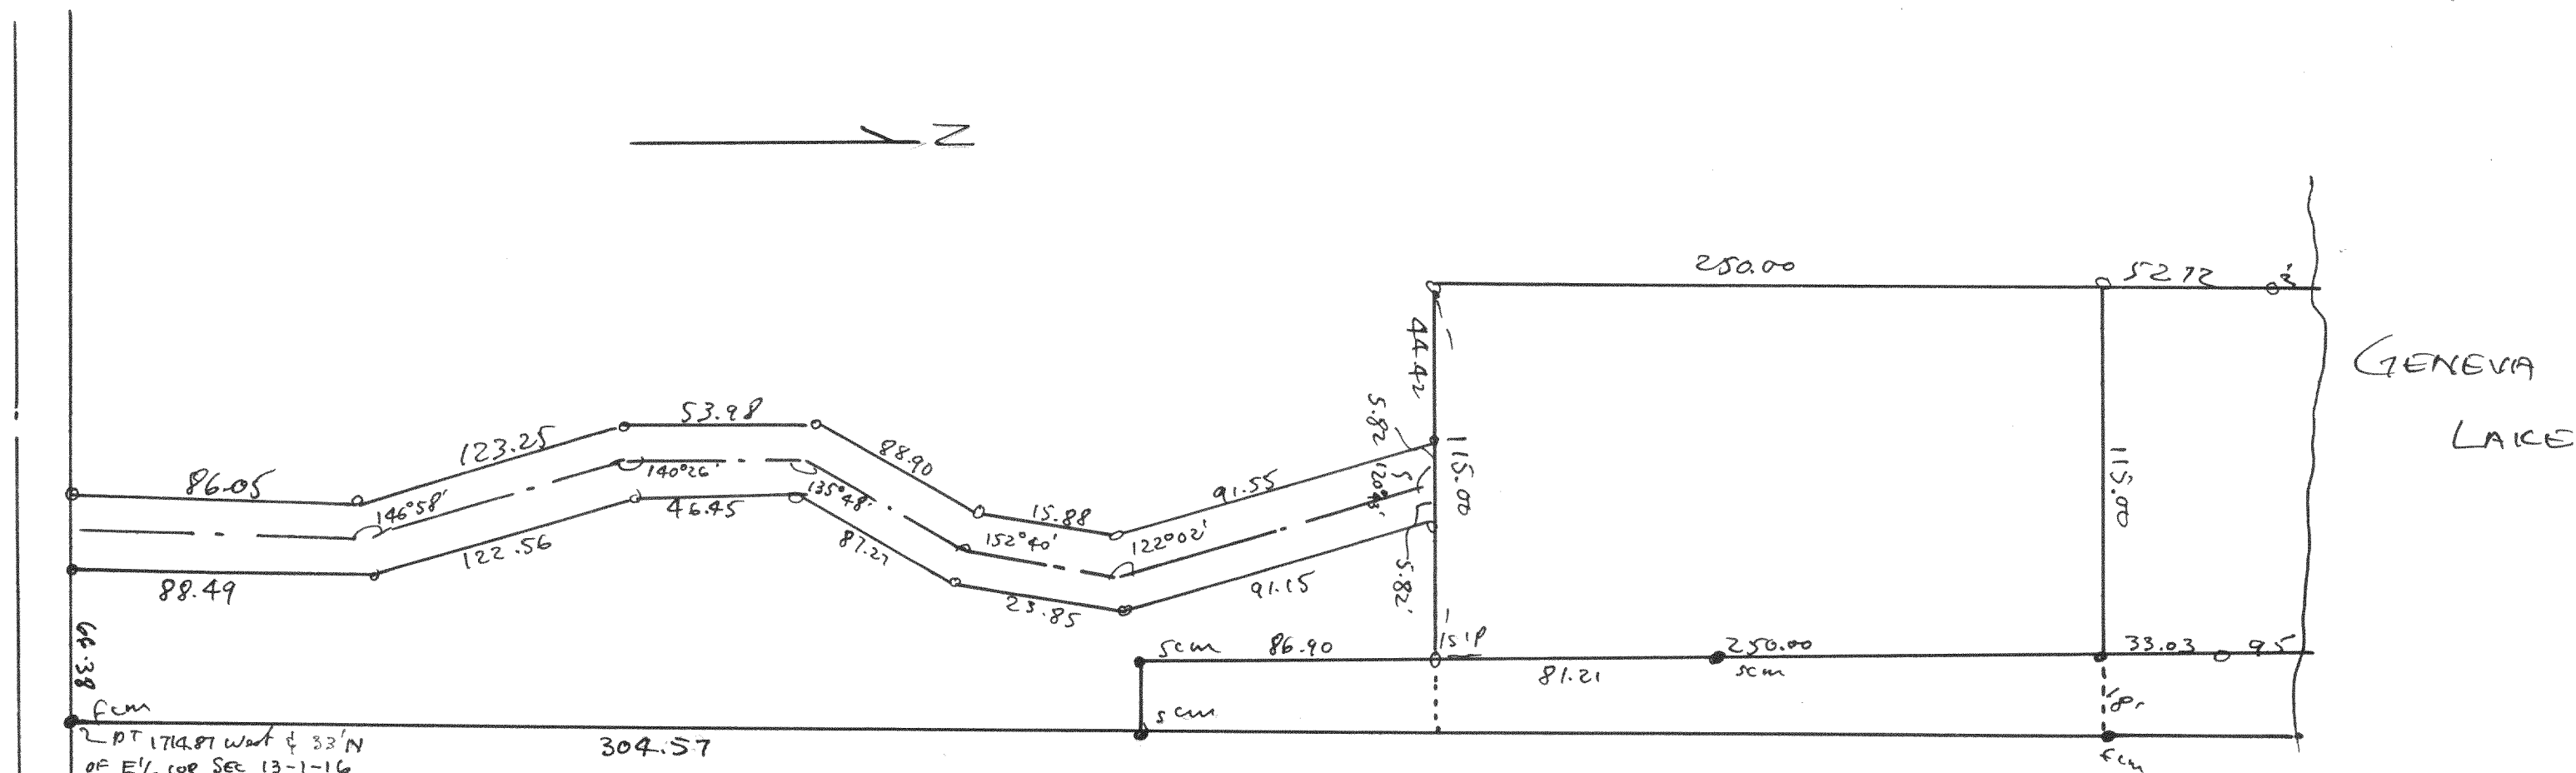

Plat of survey of land sold by Hollenback located in the NE 1/4 Sec 13, T14N R18E,
Village of Fontana, Walworth County, Wis.
March 23, 1950
Hoyd L. Jensen
County Surveyor