


2406

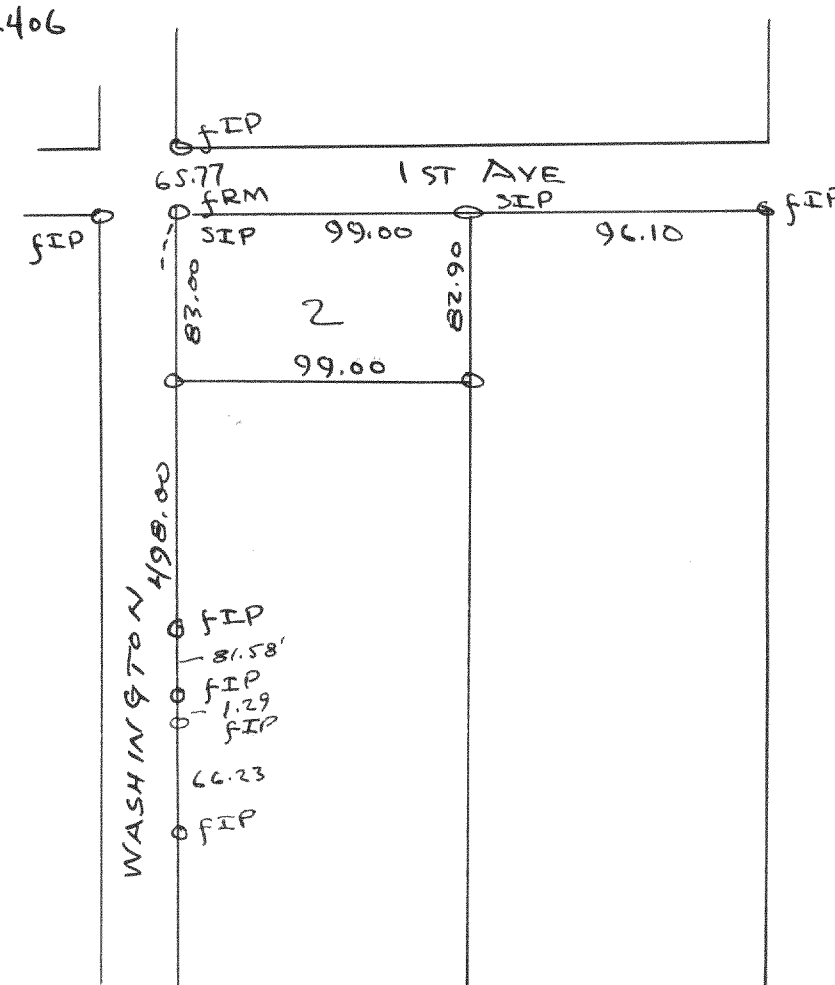


Plat of survey of Lot 2, Blk 35, City of Elkhorn,
Walworth County, Wisconsin
Aug. 25, 1951

Davis add

Lloyd L. Jensen 923
County Surveyor

2407
2406

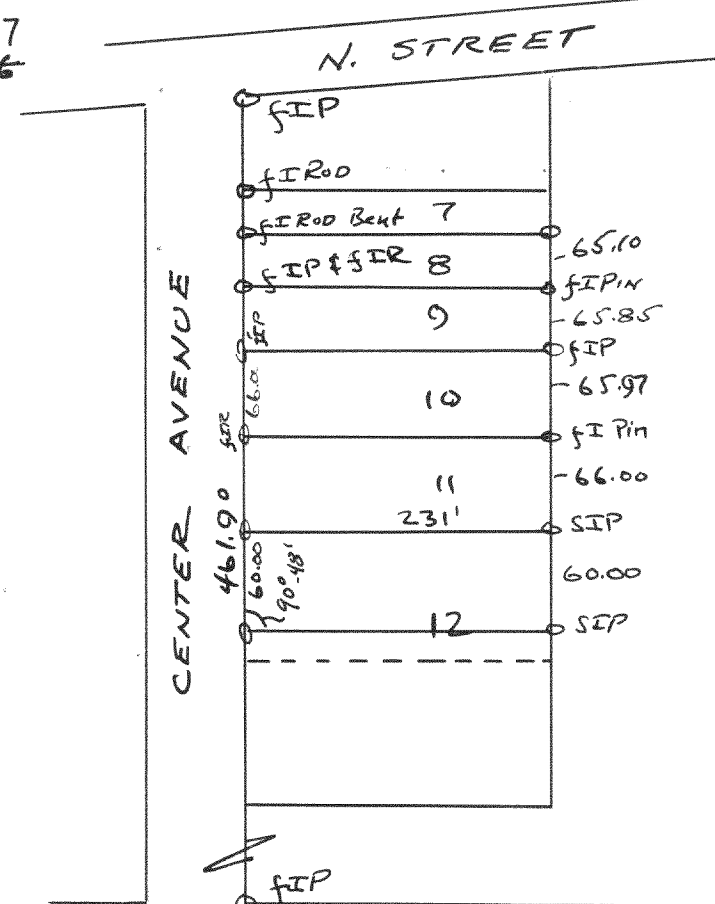

Plat of survey of the N 60' of Lot 12, Blk 2
North View add., Village of East Troy
May 12, 1951

Lloyd L. Jensen 923
County Surveyor

2406 1/2



Plat of survey of Corner Property located on Adams Street in
the SE 1/4 of Sec 36 T3N R16E, City of Elkhorn, Walworth County, Wisconsin
Aug. 1951

Lloyd L. Jensen 923
County Surveyor