



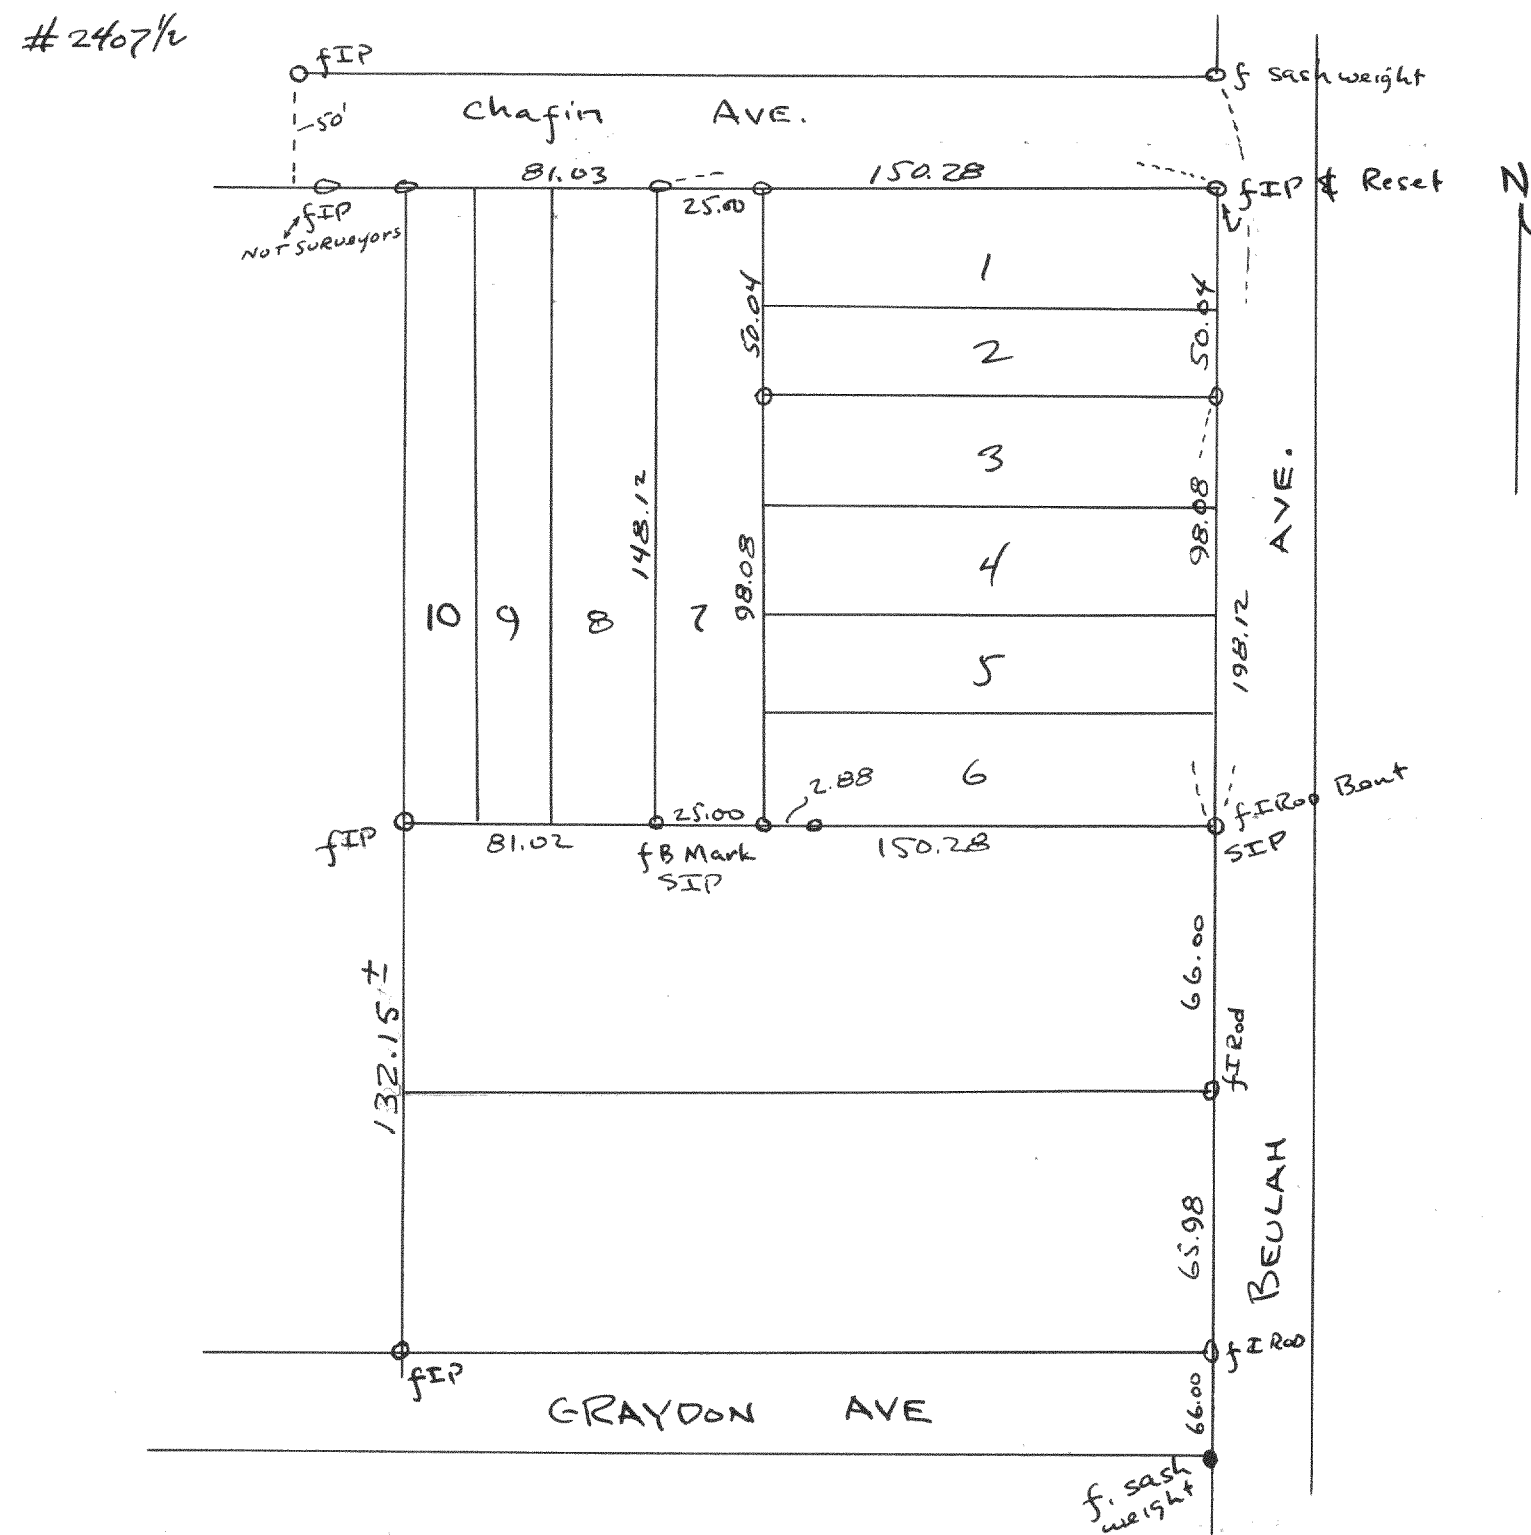

Plat of survey of lots 1, 2, 7 & parcel to the South of Clark's
addition, Village of East Troy, Walworth County, Wisconsin
1951
Lloyd L. Jensen REC
County Surveyor

Lloyd L. Jensen 9EB
County Surveyor

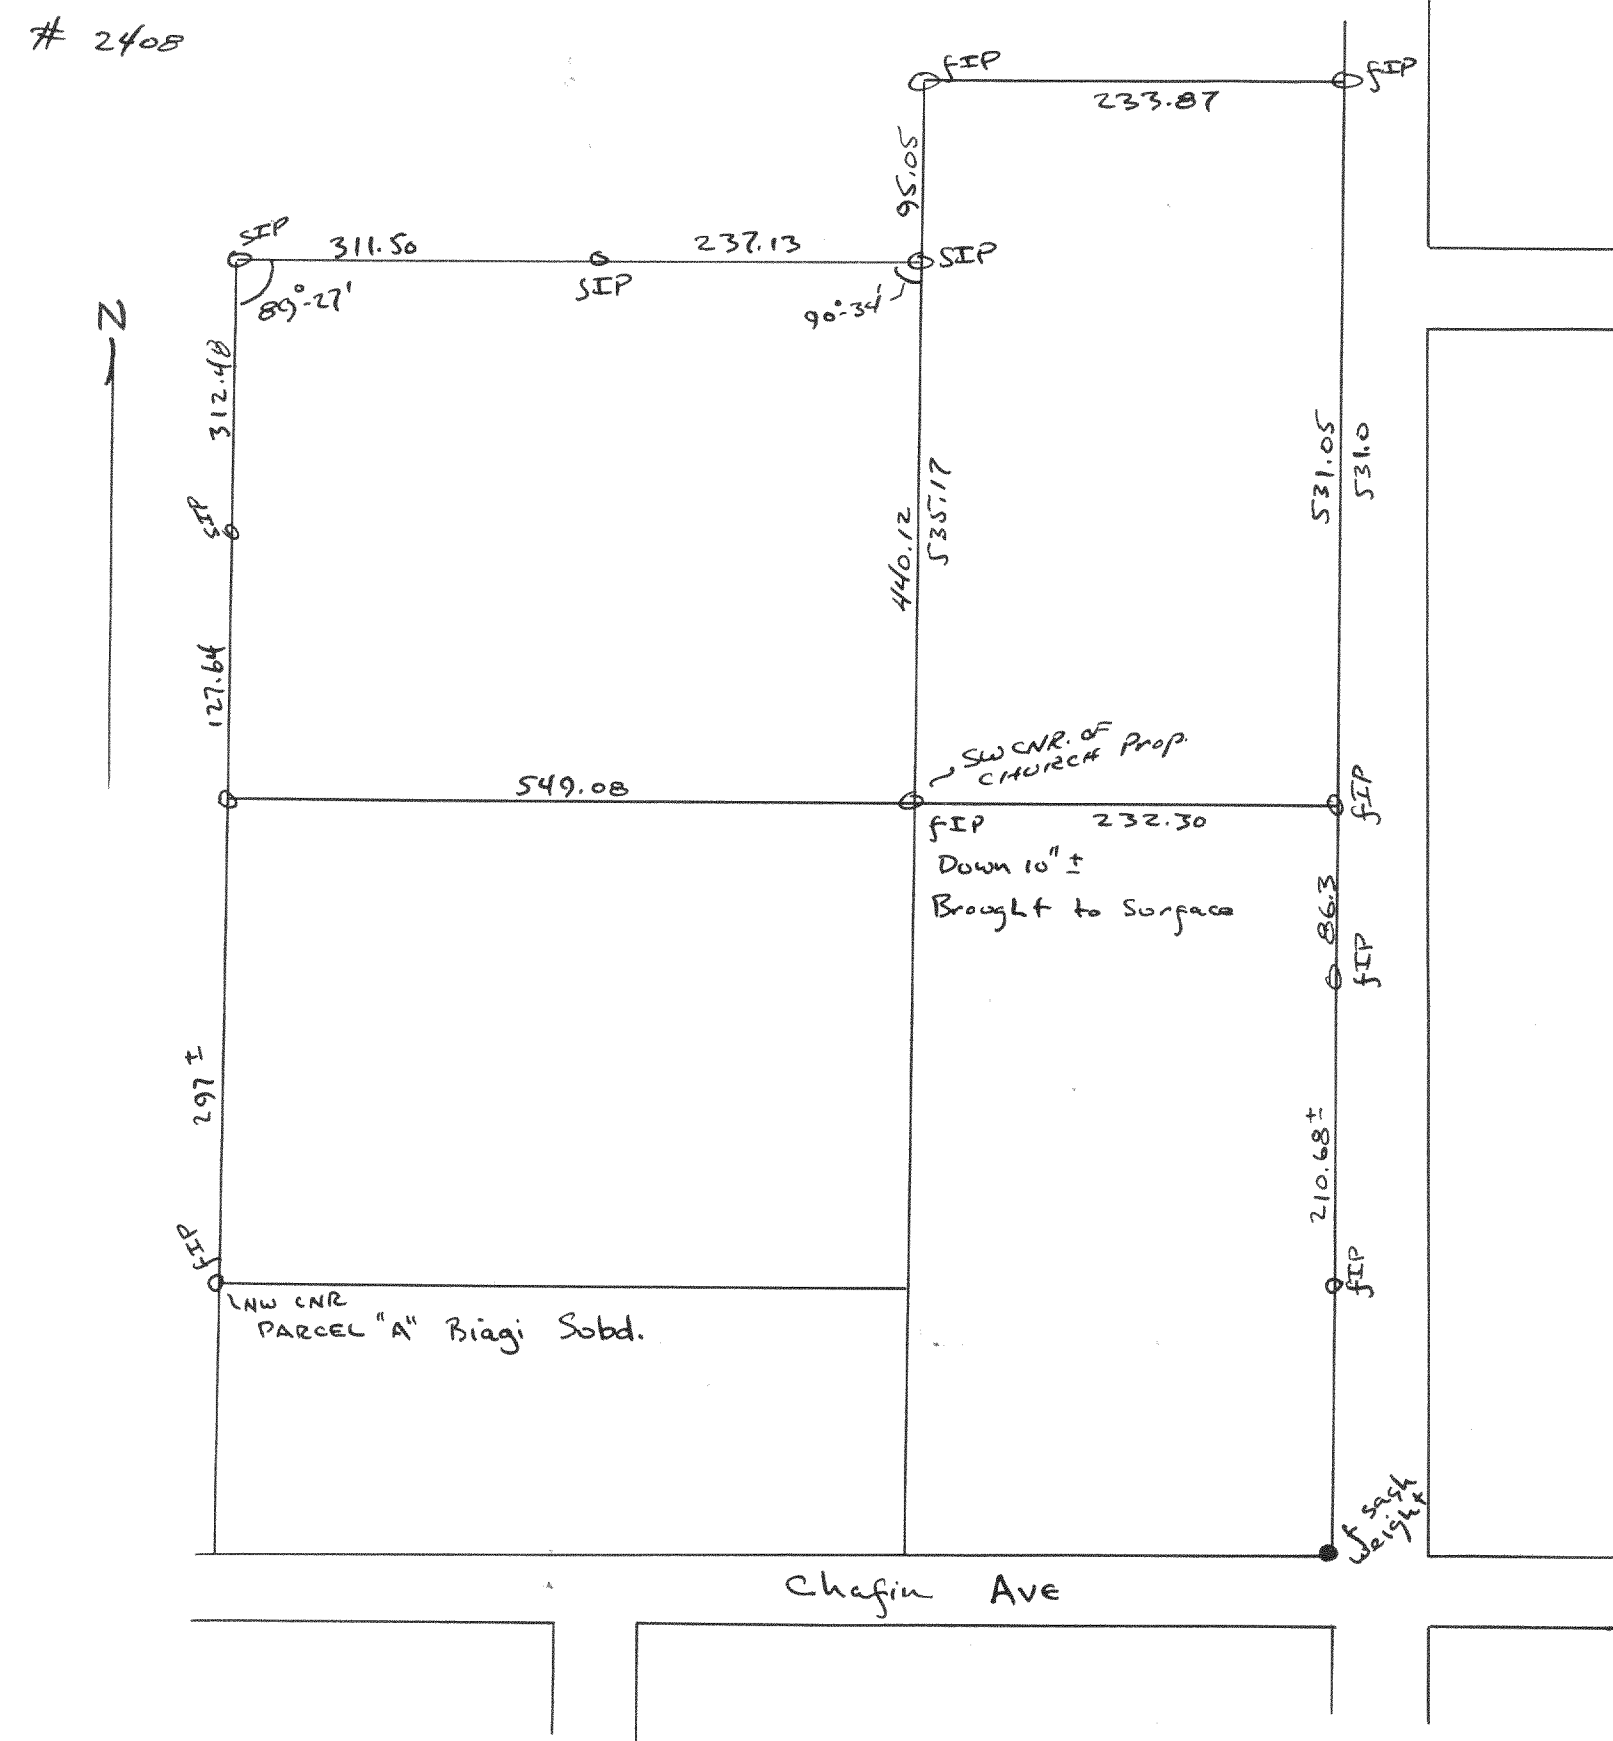

Plat of survey of land purchased by Catholic Church located to the west of present church in the SE 1/4 of Section 19, T4N R18E, Uelage of East Troy, Walworth County, Wisconsin

July 24, 1951

Lloyd L. Jensen 72B

Boyd L. Jensen ^{qeb}
County Surveyor