



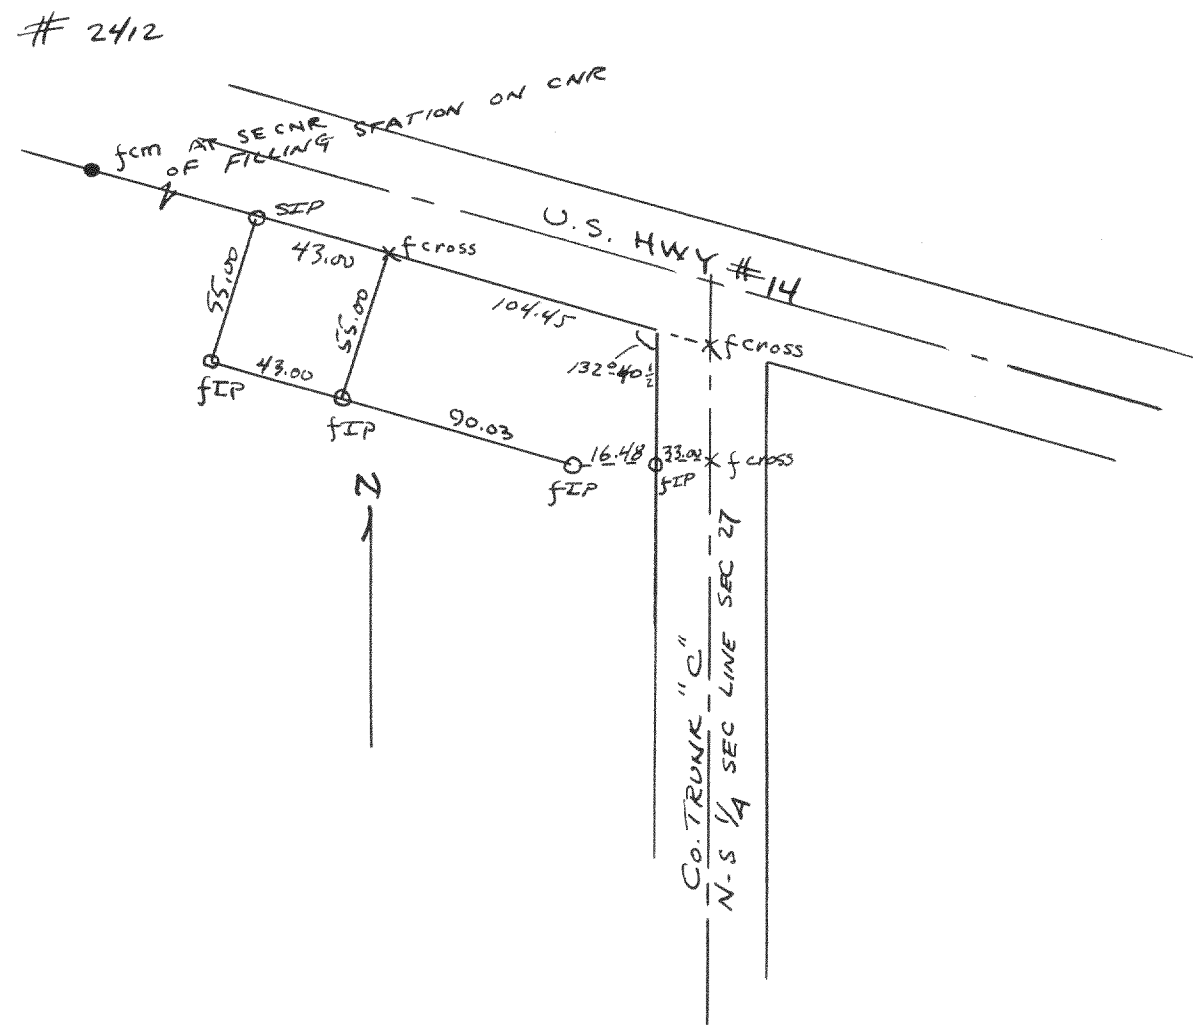

Plat of survey of Pure Oil Station property located in the SW 1/4 Sec 27, T2N R15E, Village of Darien, Walworth County, Wisc.
May 28, 1951
Lloyd L. Jensen 923
County Surveyor

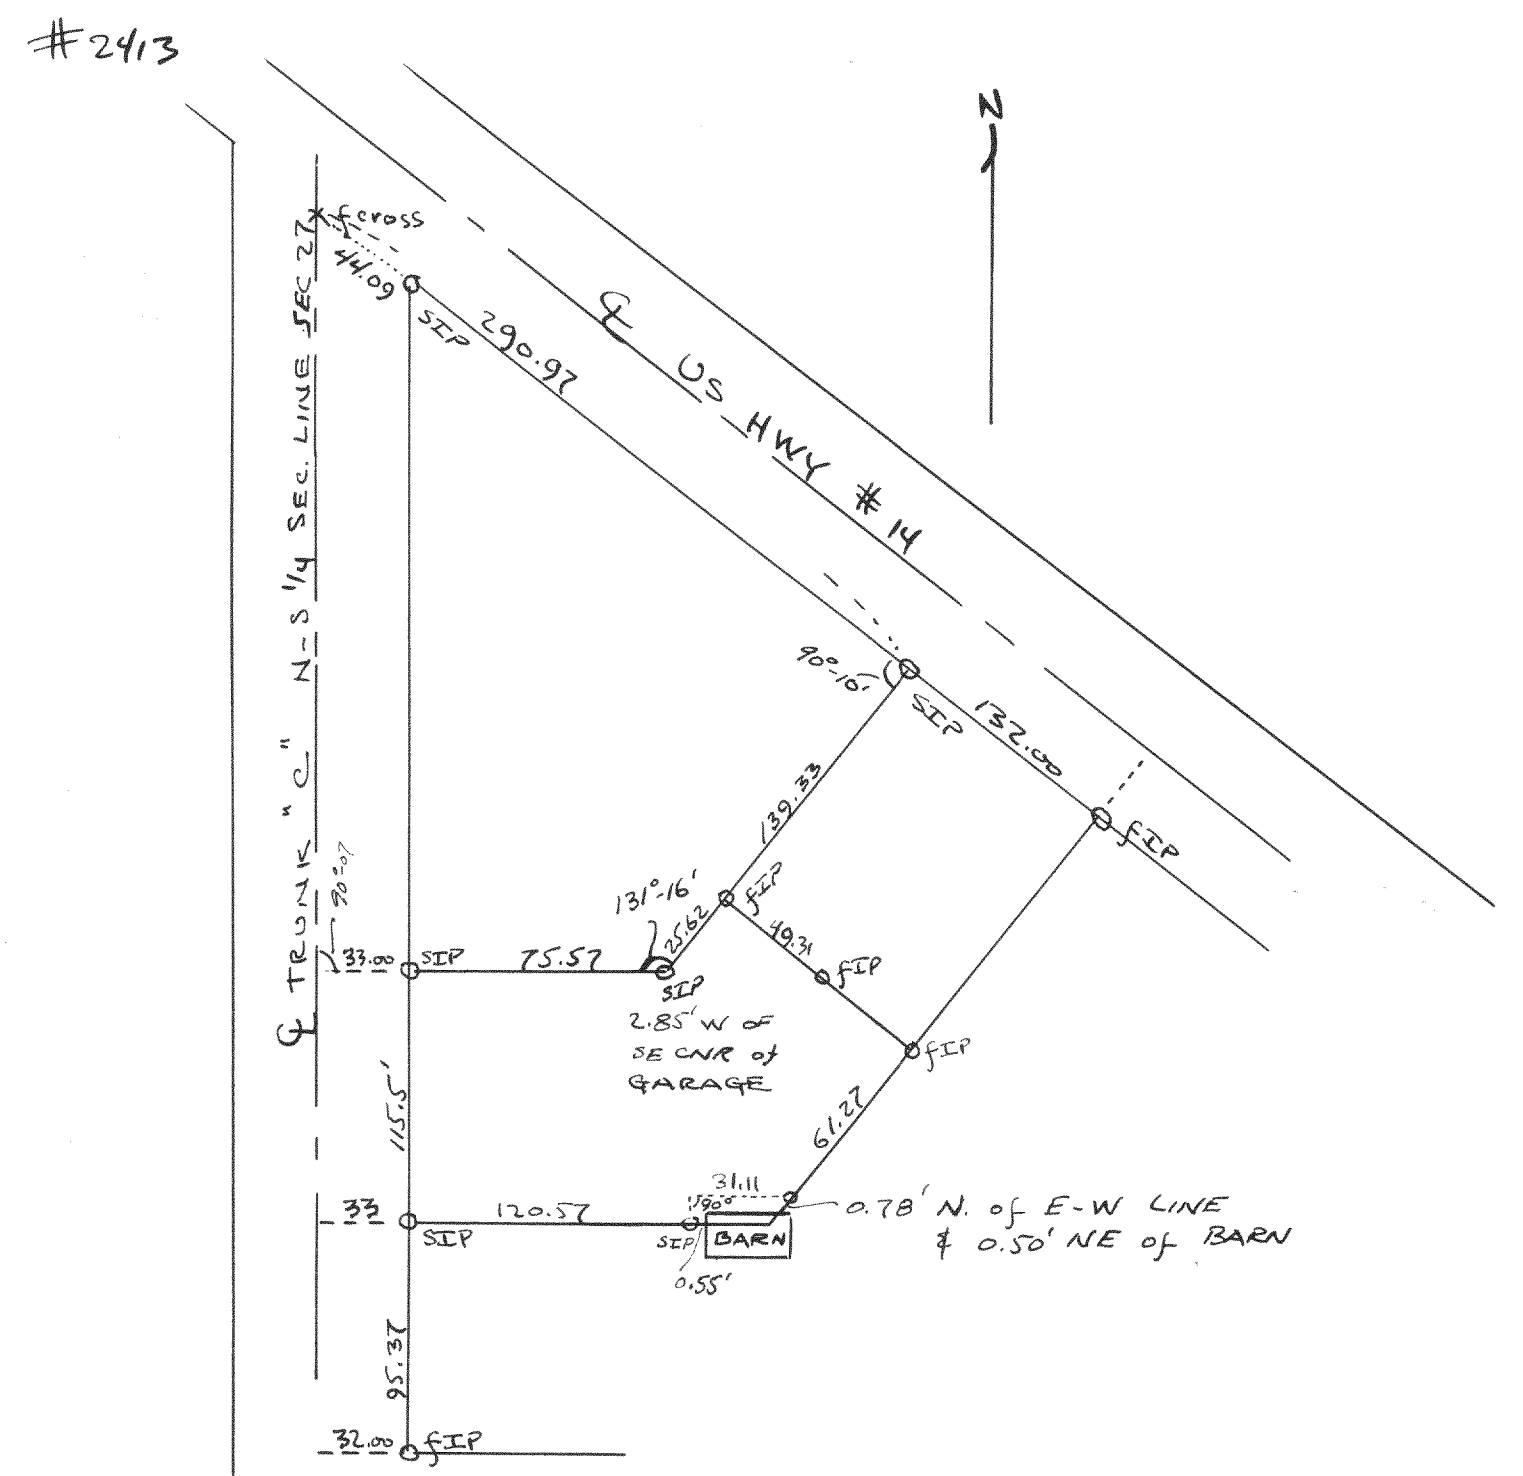

Plat of survey of the Ried Property located in the SE 1/4 of Sec 27 T2N R15E, Village of Darien, Walworth County, Wisconsin
Sept 20, 1951
Lloyd L. Jensen 923
County Surveyor