

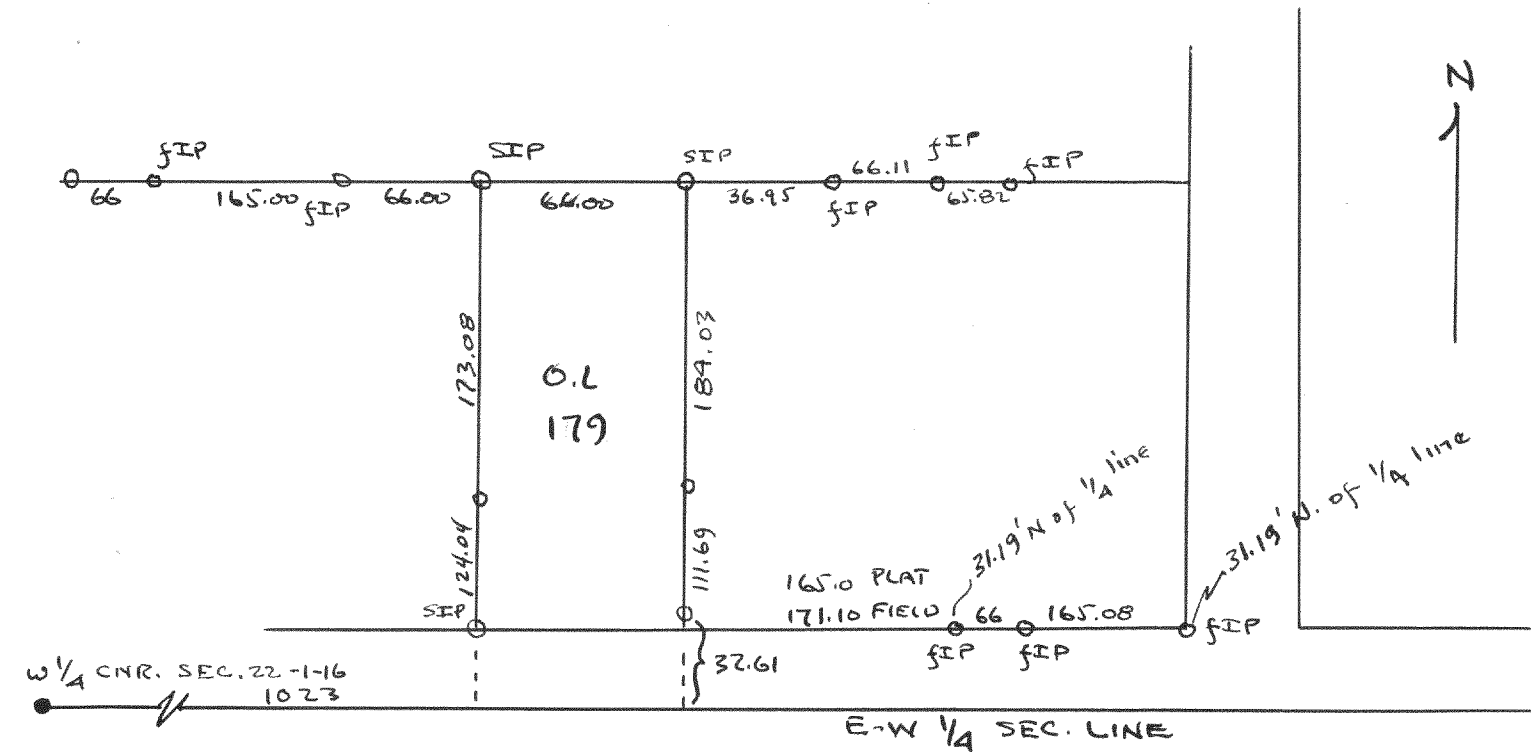


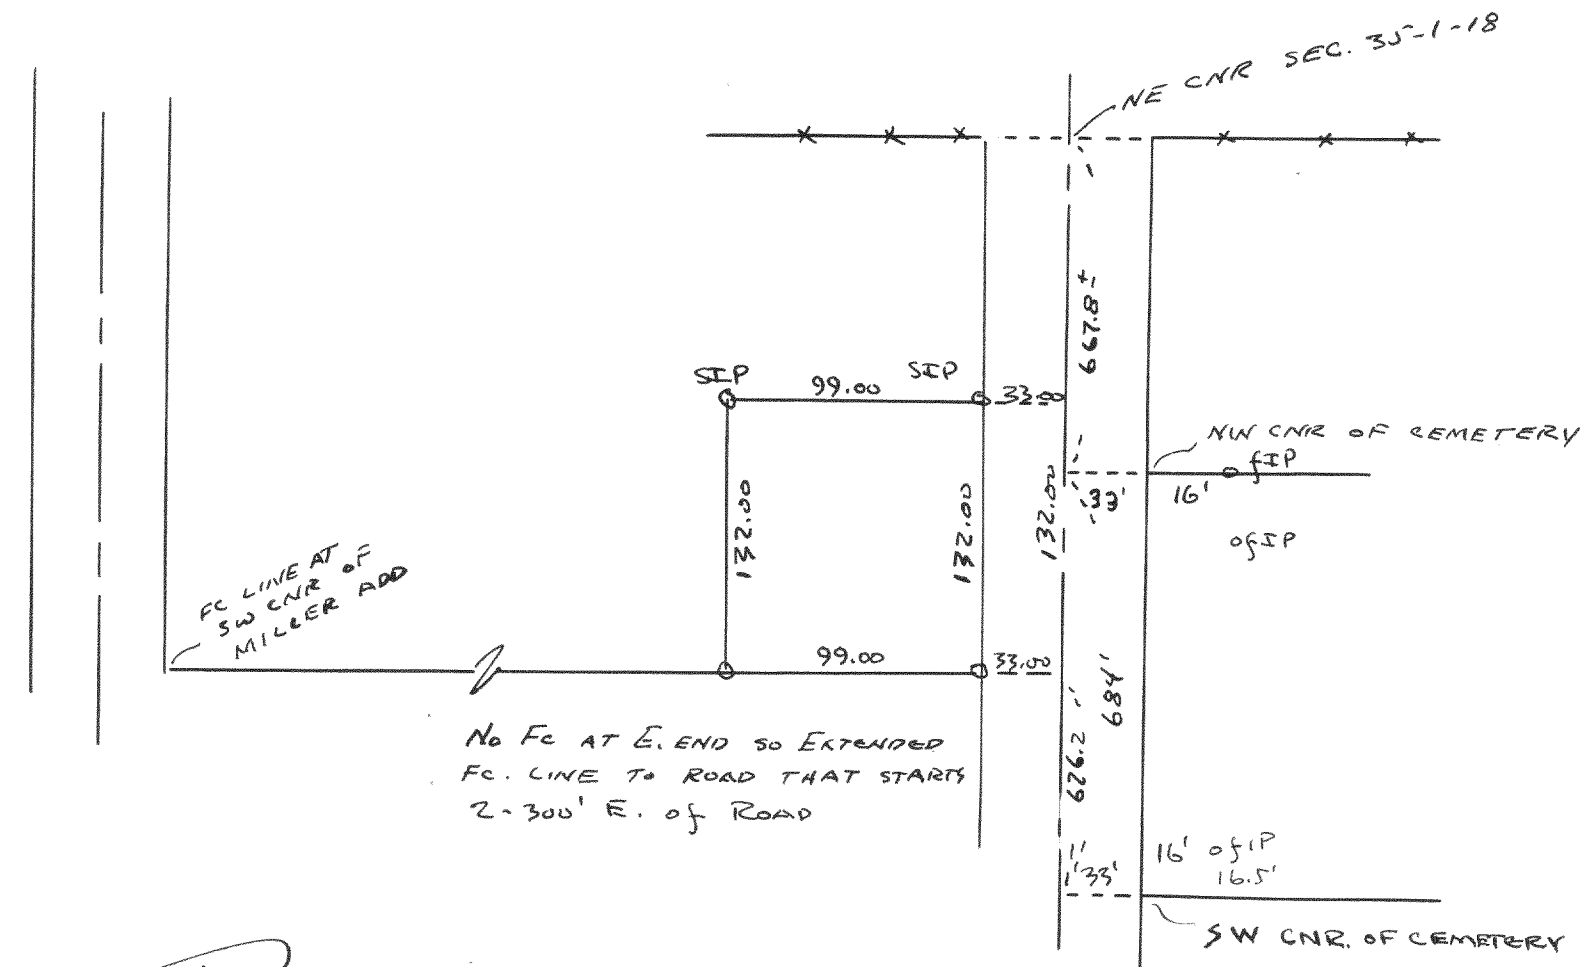

Plat of survey of O.L. 179 Village of Walsworth, Walsworth County, Wisconsin
Oct. 9, 1951 Lloyd L. Jensen J.C.B.
County Surveyor

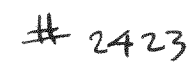

Plat of survey of land located in the NE 1/4
of Section 35 T14N R16E, Village of Genoa City, Walworth County, Wis.
Aug. 10, 1951
Lloyd L. Jensen REC
County Surveyor