


# 2424

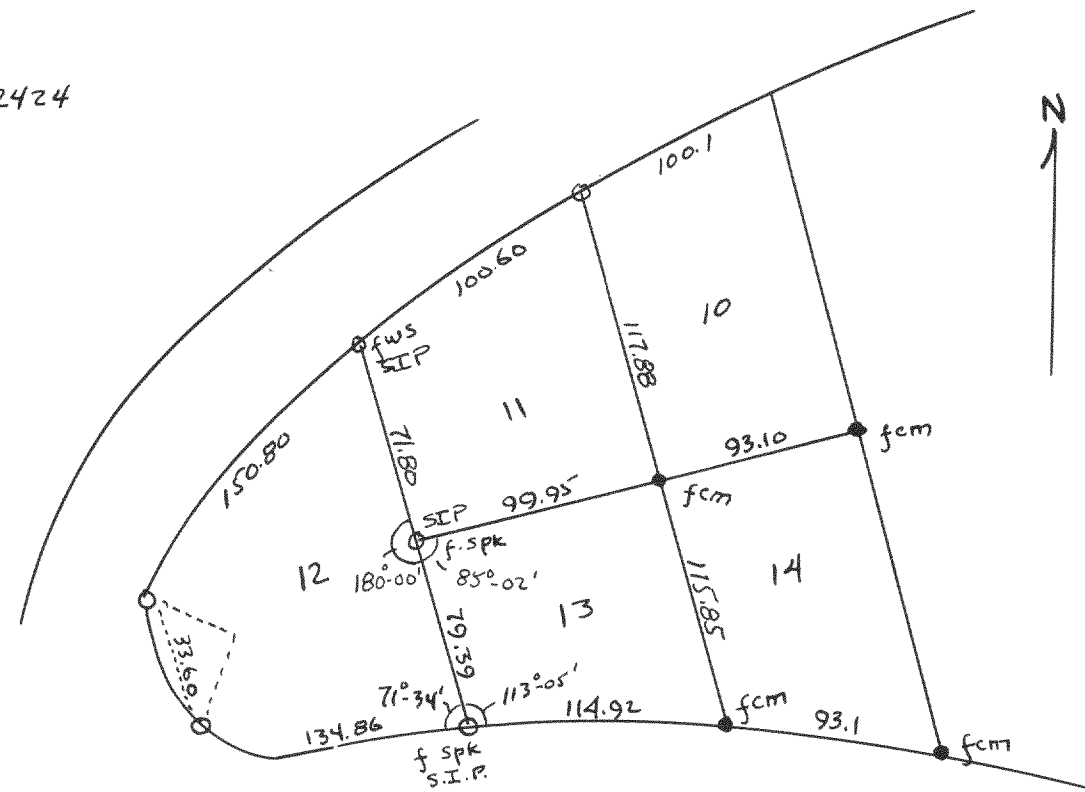


Plat of survey of lots 11 & 12 Unit # 2 of  
Country Club Estates, Village of Fontana, Walworth  
County, Wisconsin  
April 28, 1951  
Lloyd L. Jensen JEB  
County Surveyor

# 2426



Plat of survey of lot 1 in Unit # 2, Country Club  
Estates, Village of Fontana, Walworth County, Wisconsin  
Oct 1, 1951  
Lloyd L. Jensen JEB  
County Surveyor

# 2425

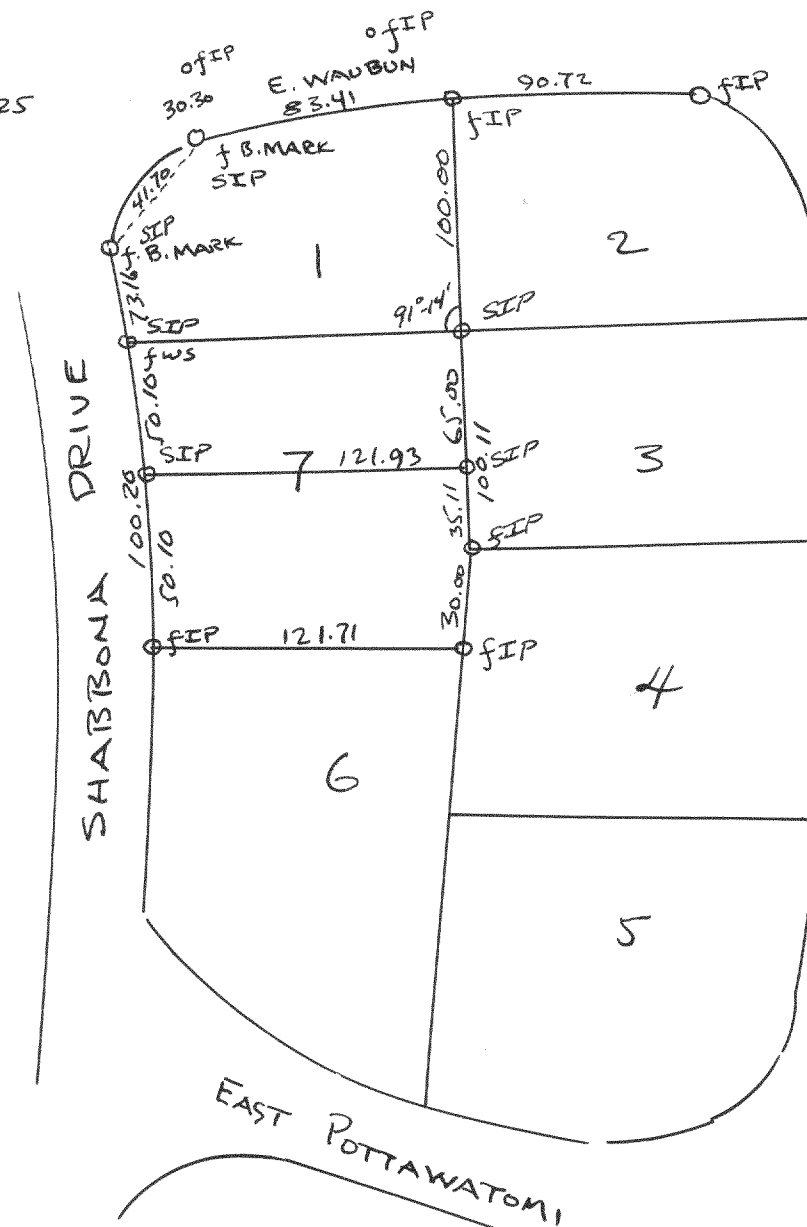

Plat of survey of lot 1 and the N 1/2 lot 7, Blk. 6 of Unit # 3  
Country Club Estates located in the Village of Fontana,  
Walworth County, Wisconsin  
Sept 6, 1951

Lloyd L. Jensen JEB  
County Surveyor