



2434

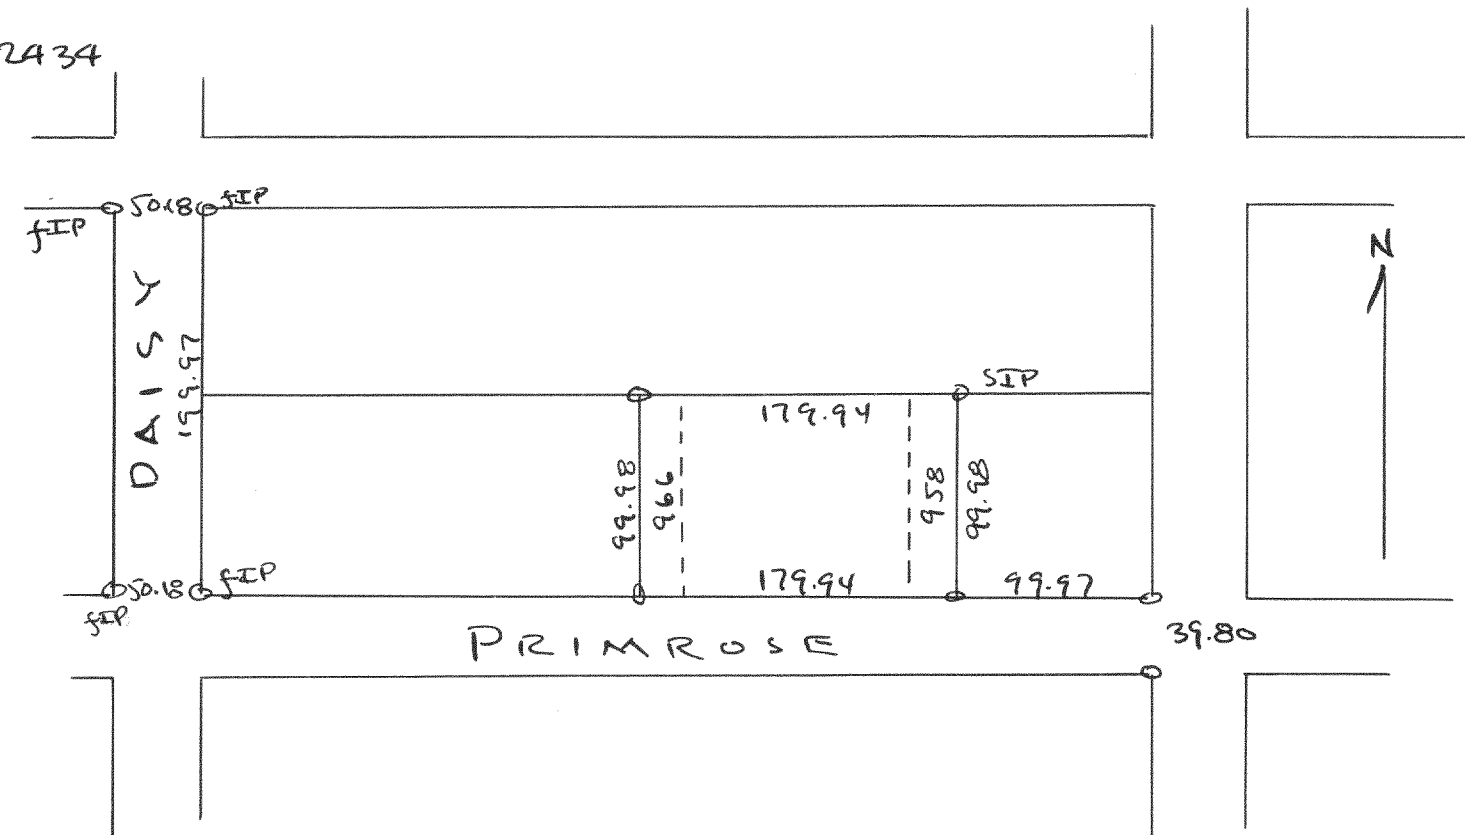


Plat of survey of lots 958-966, Peel Lake Addition, Walworth County, Wisconsin
1951
Lloyd L. Jensen Reg
County Surveyor

2435

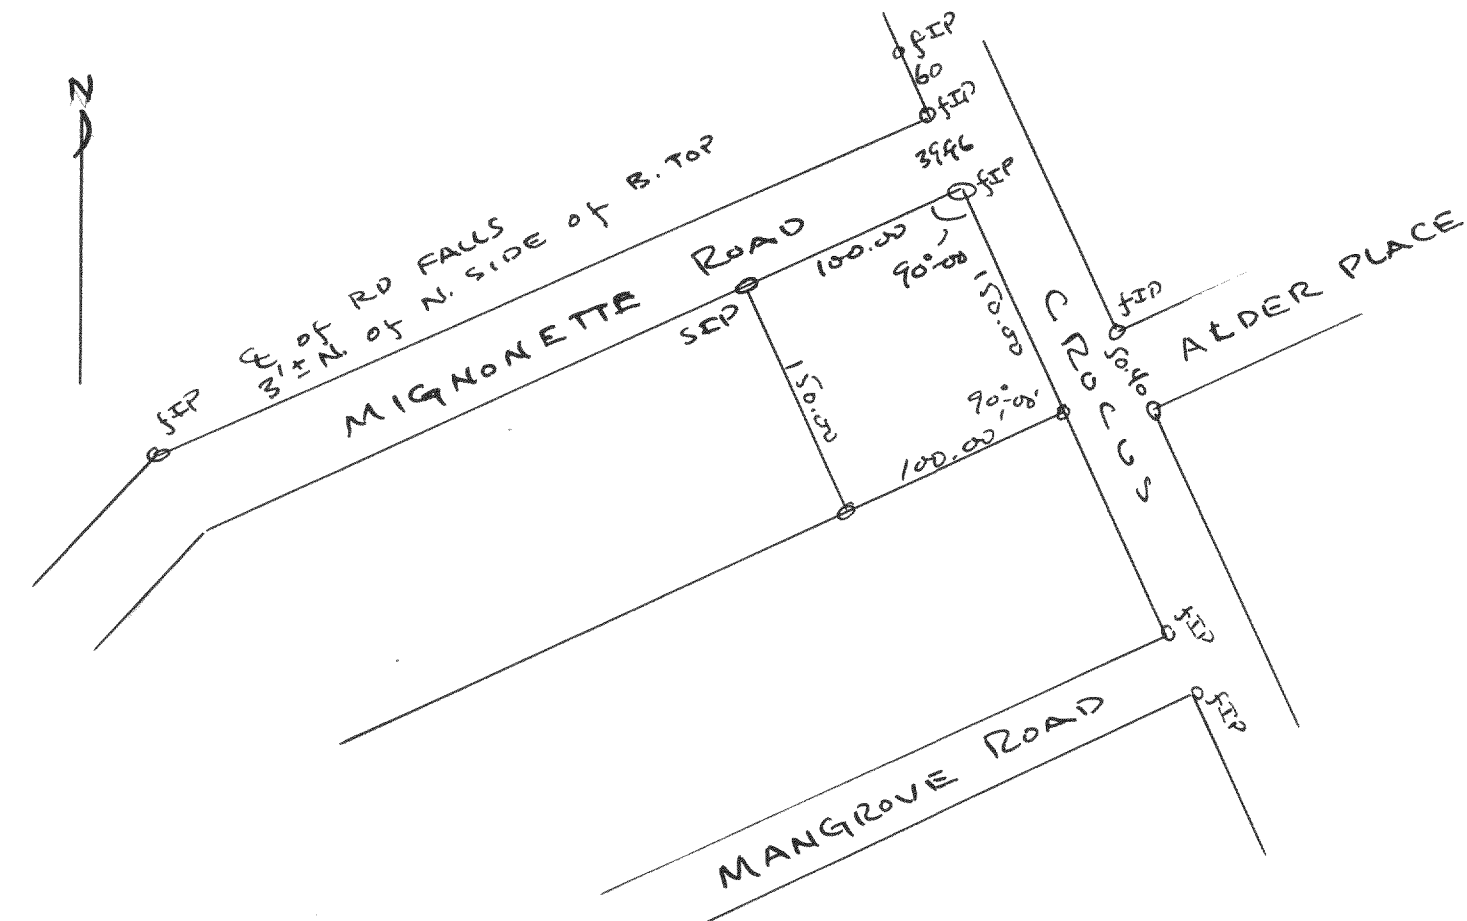

Plat of survey of lots 6724-6728, Peel Lake Subdivision
TINRIBE, Walworth County, Wisconsin
Sept 7, 1951
Lloyd L. Jensen Reg
County Surveyor

2436

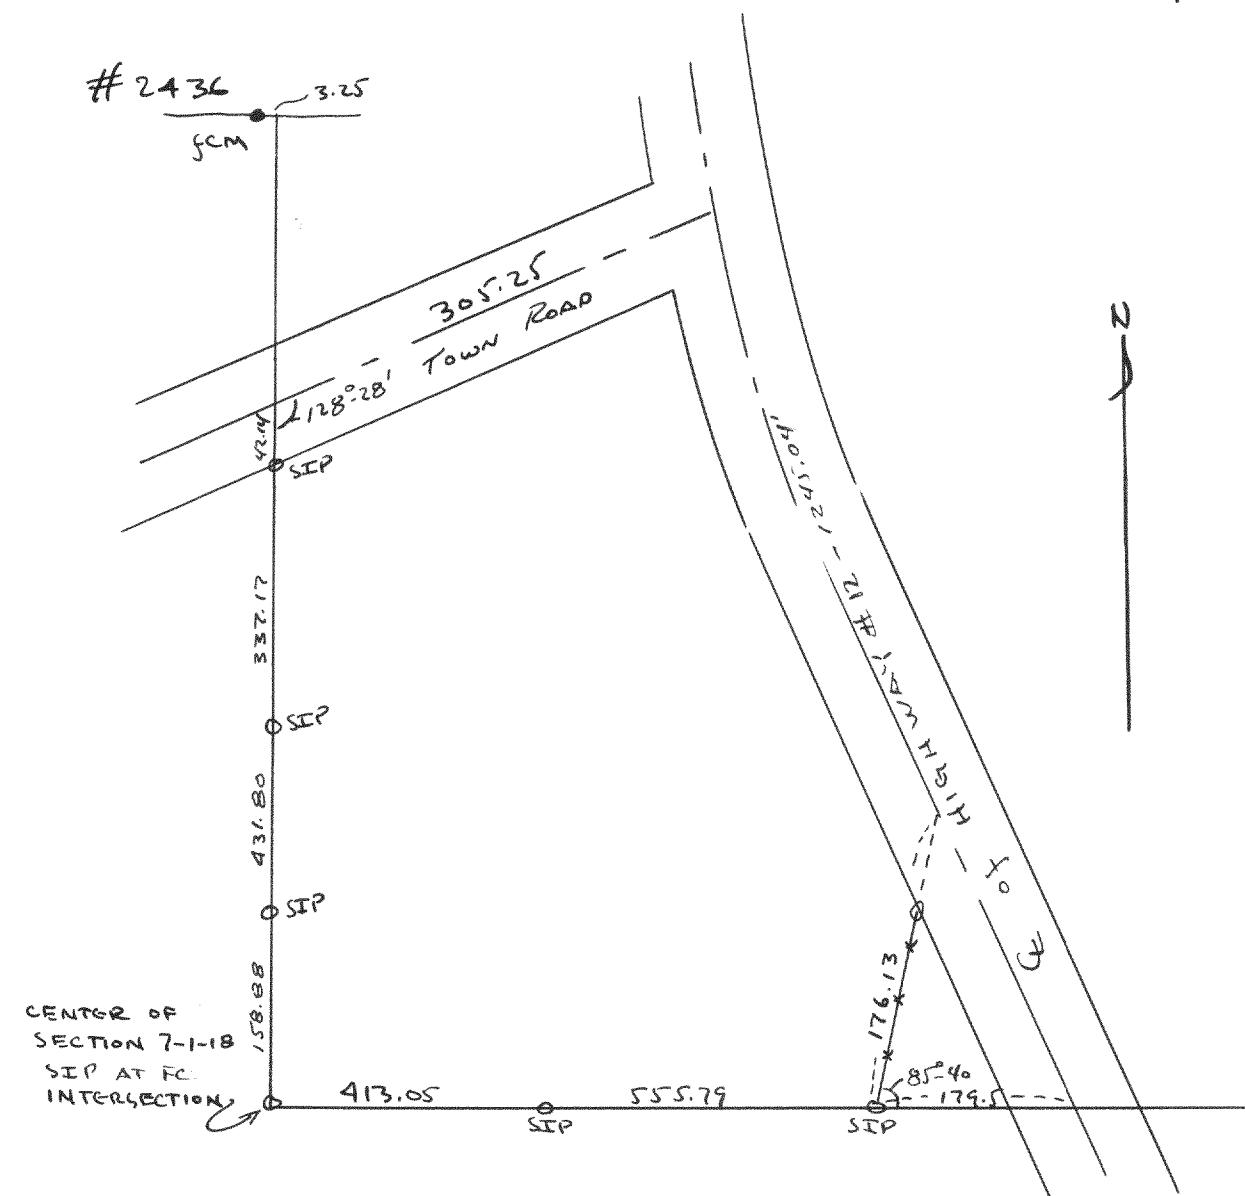

Plat of survey of a parcel of land owned by Richert located in
the NE 1/4 of Sec 7-1-18 Walworth County, Wisconsin
Nov. 18, 1951
Lloyd L. Jensen Reg
County Surveyor