



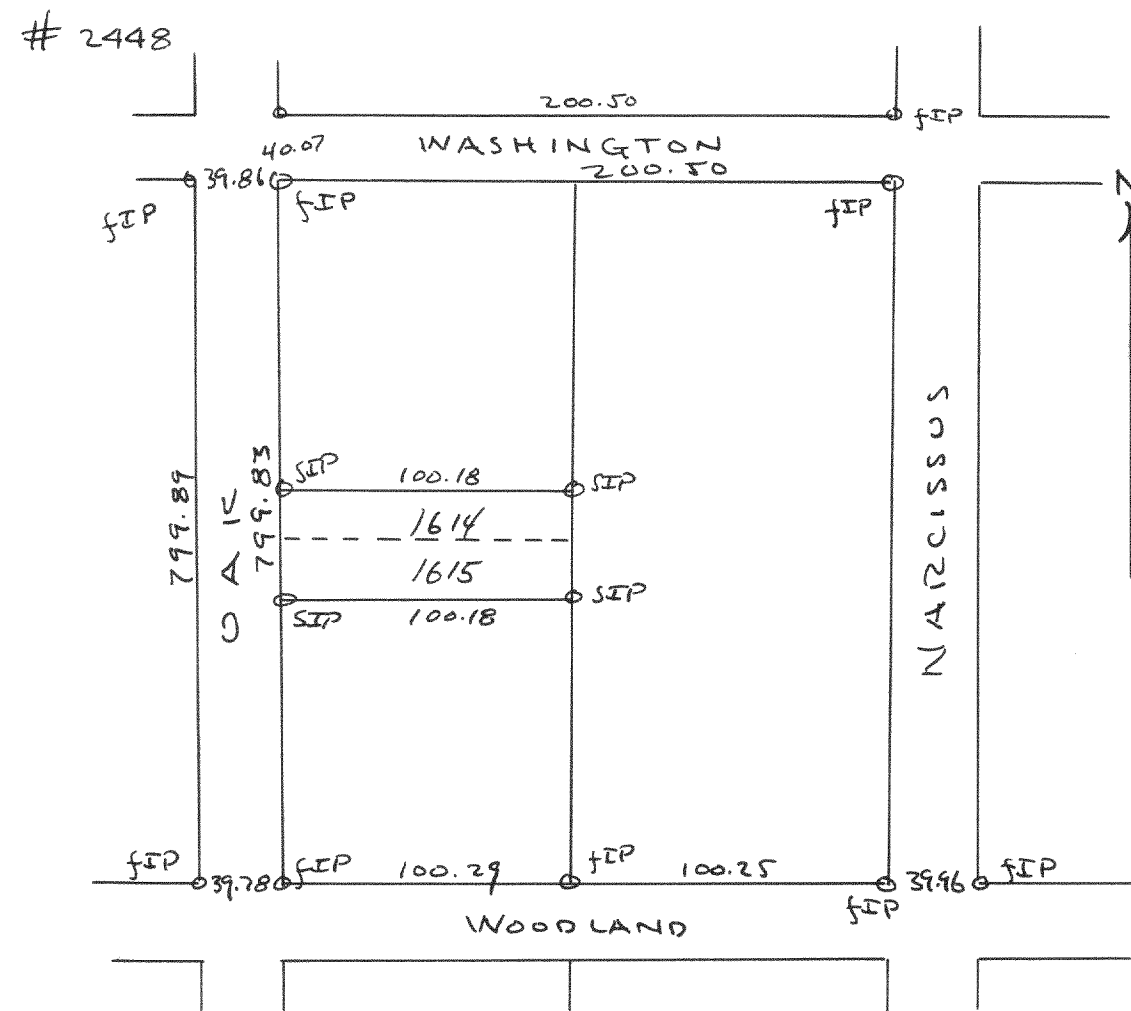


Plat of survey of lots 1614-1615, Lake Como Beach located in T2N R17E, Walworth County, Wisconsin Aug. 9, 1951

Lloyd L. Jensen 9EB
County Surveyor

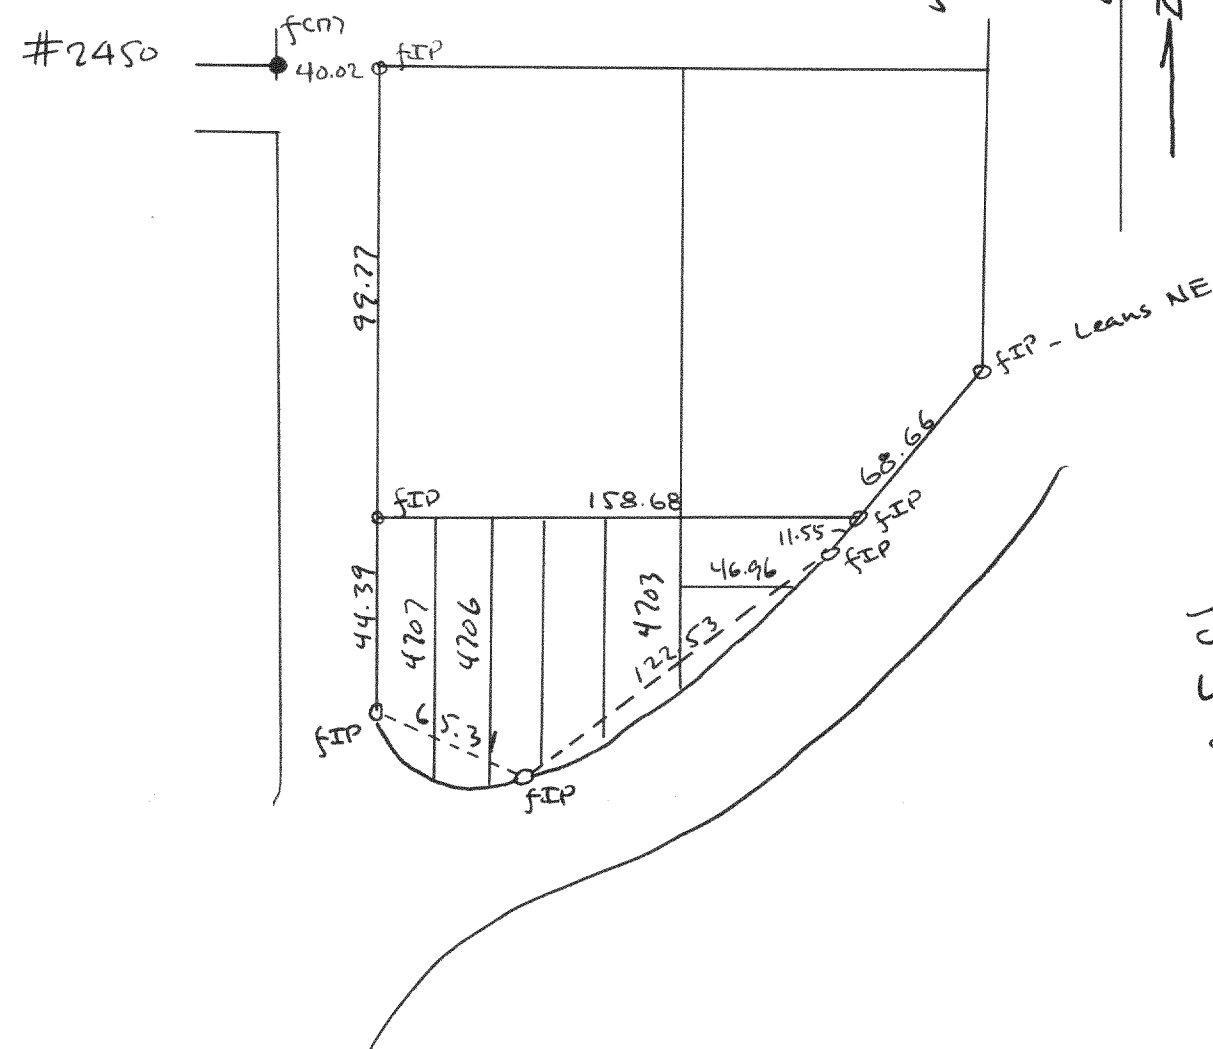

Plat of survey of lots 4696-4697, 4703-4707 of Lake Como Beach Subdivision located in T2N R17E Walworth County, Wisconsin Sept 2, 1951

Lloyd L. Jensen 9EB
County Surveyor

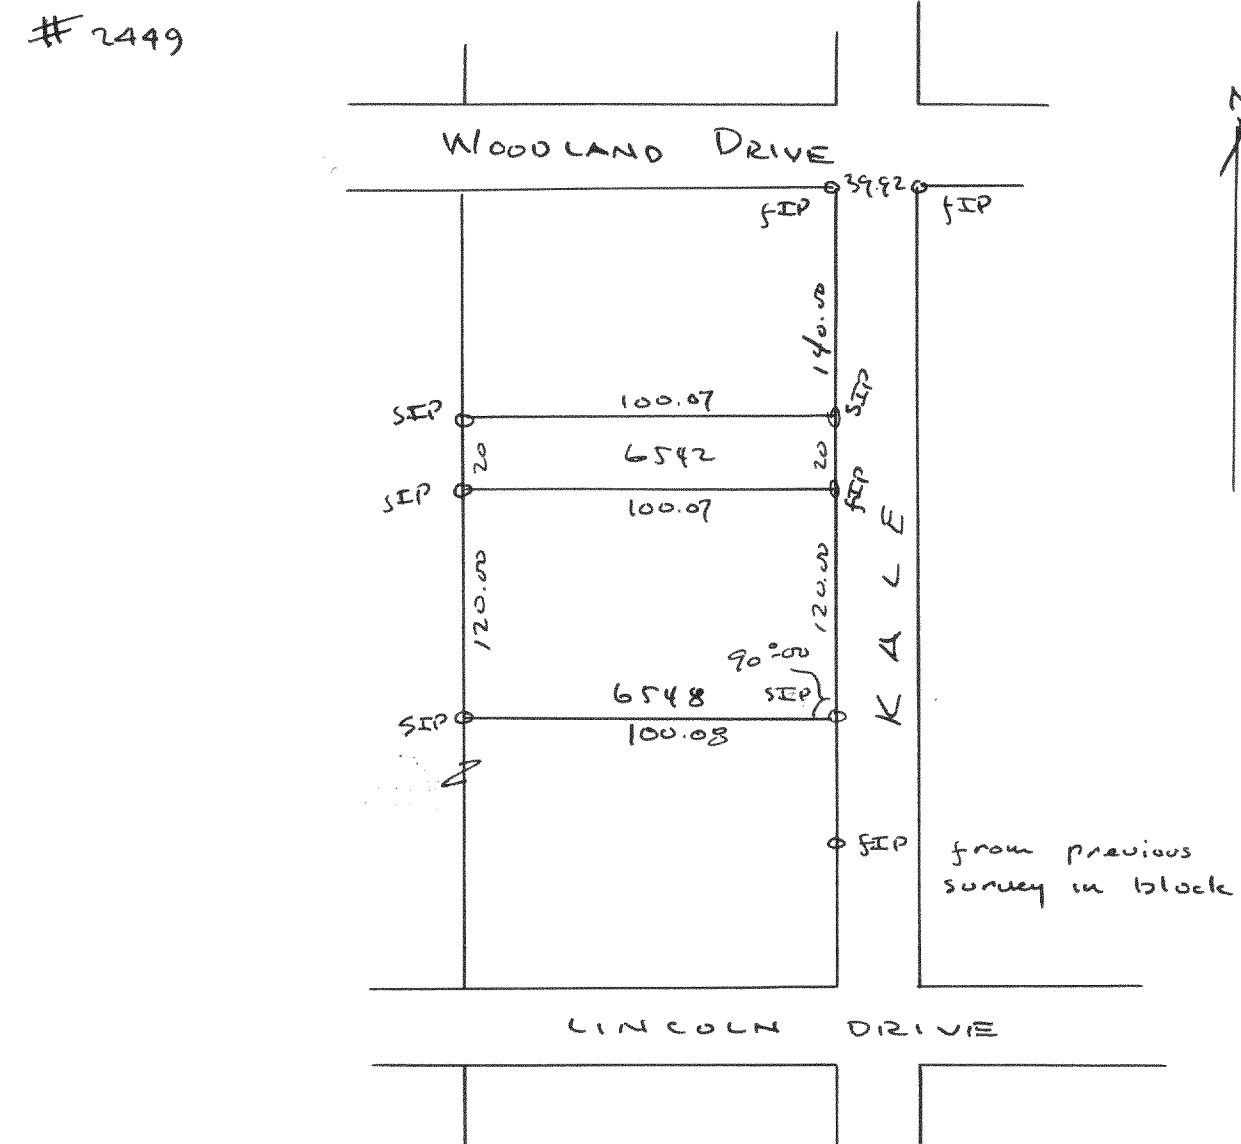

Plat of survey of lots 6542-6548 Lake Como Subdivision located in T2N R17E, Walworth County, Wisconsin 1951

Lloyd L. Jensen 9EB
County Surveyor