


SURVEY NO. 1291

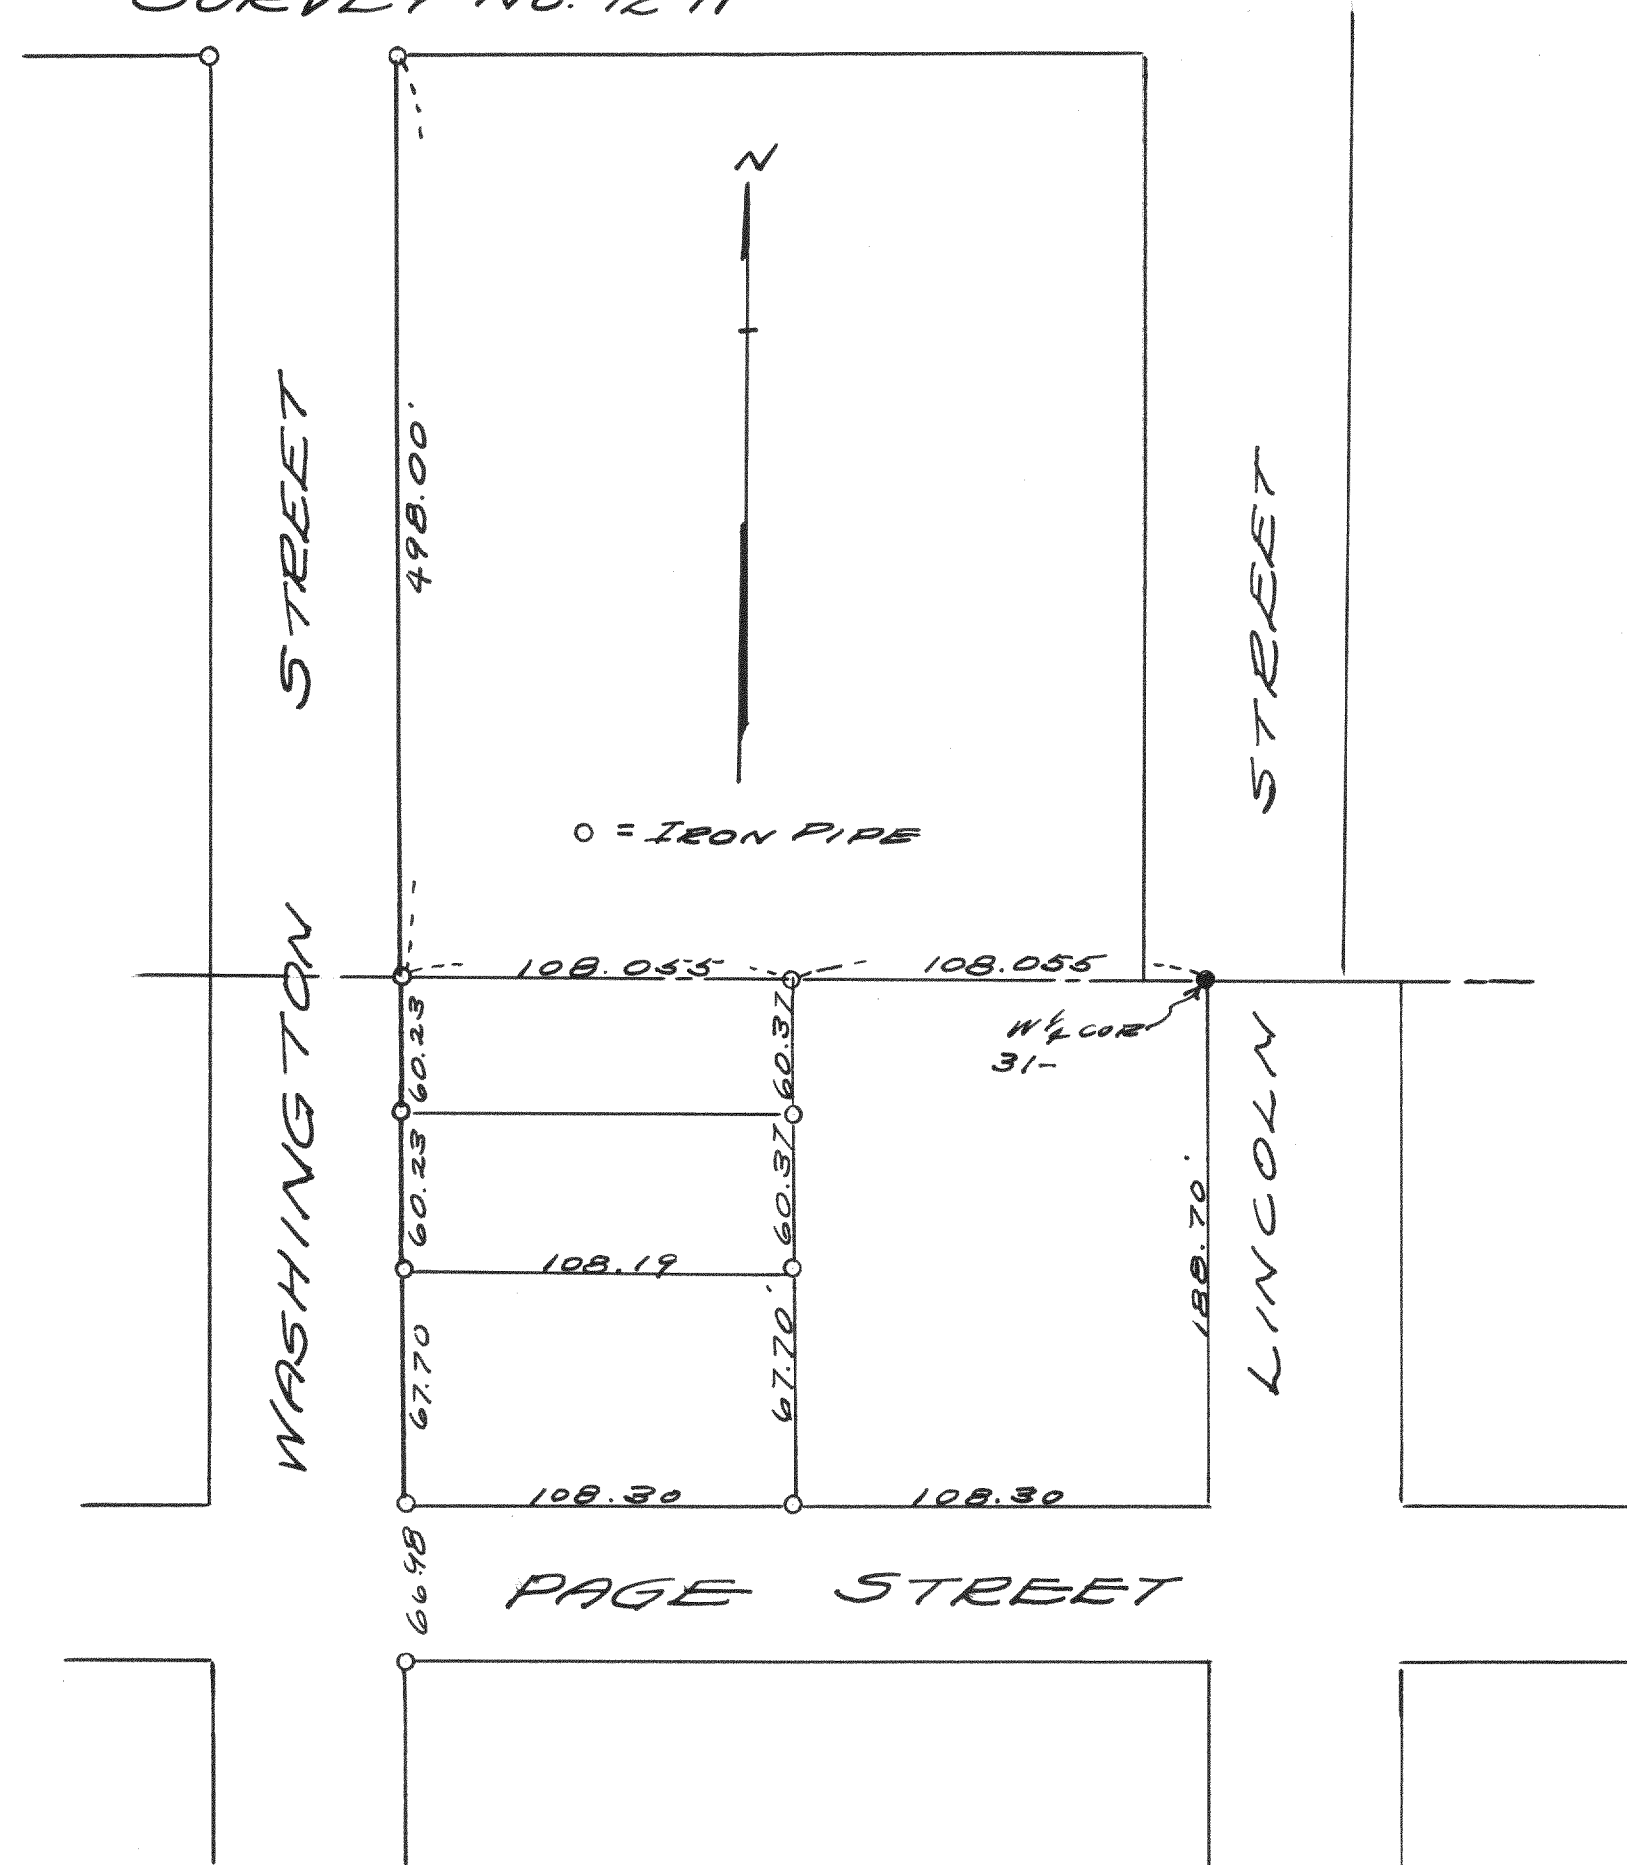


PLAT OF SURVEY OF LOT 3 & W 1/2 OF LOT 2
OF BLOCK 2, OF THE ORIGINAL CITY OF
ELKHORN, WALKWORTH CO., WISC.

DEC. 1942

Lloyd L. Jensen
S.E.G.

SURVEY NO. 1292

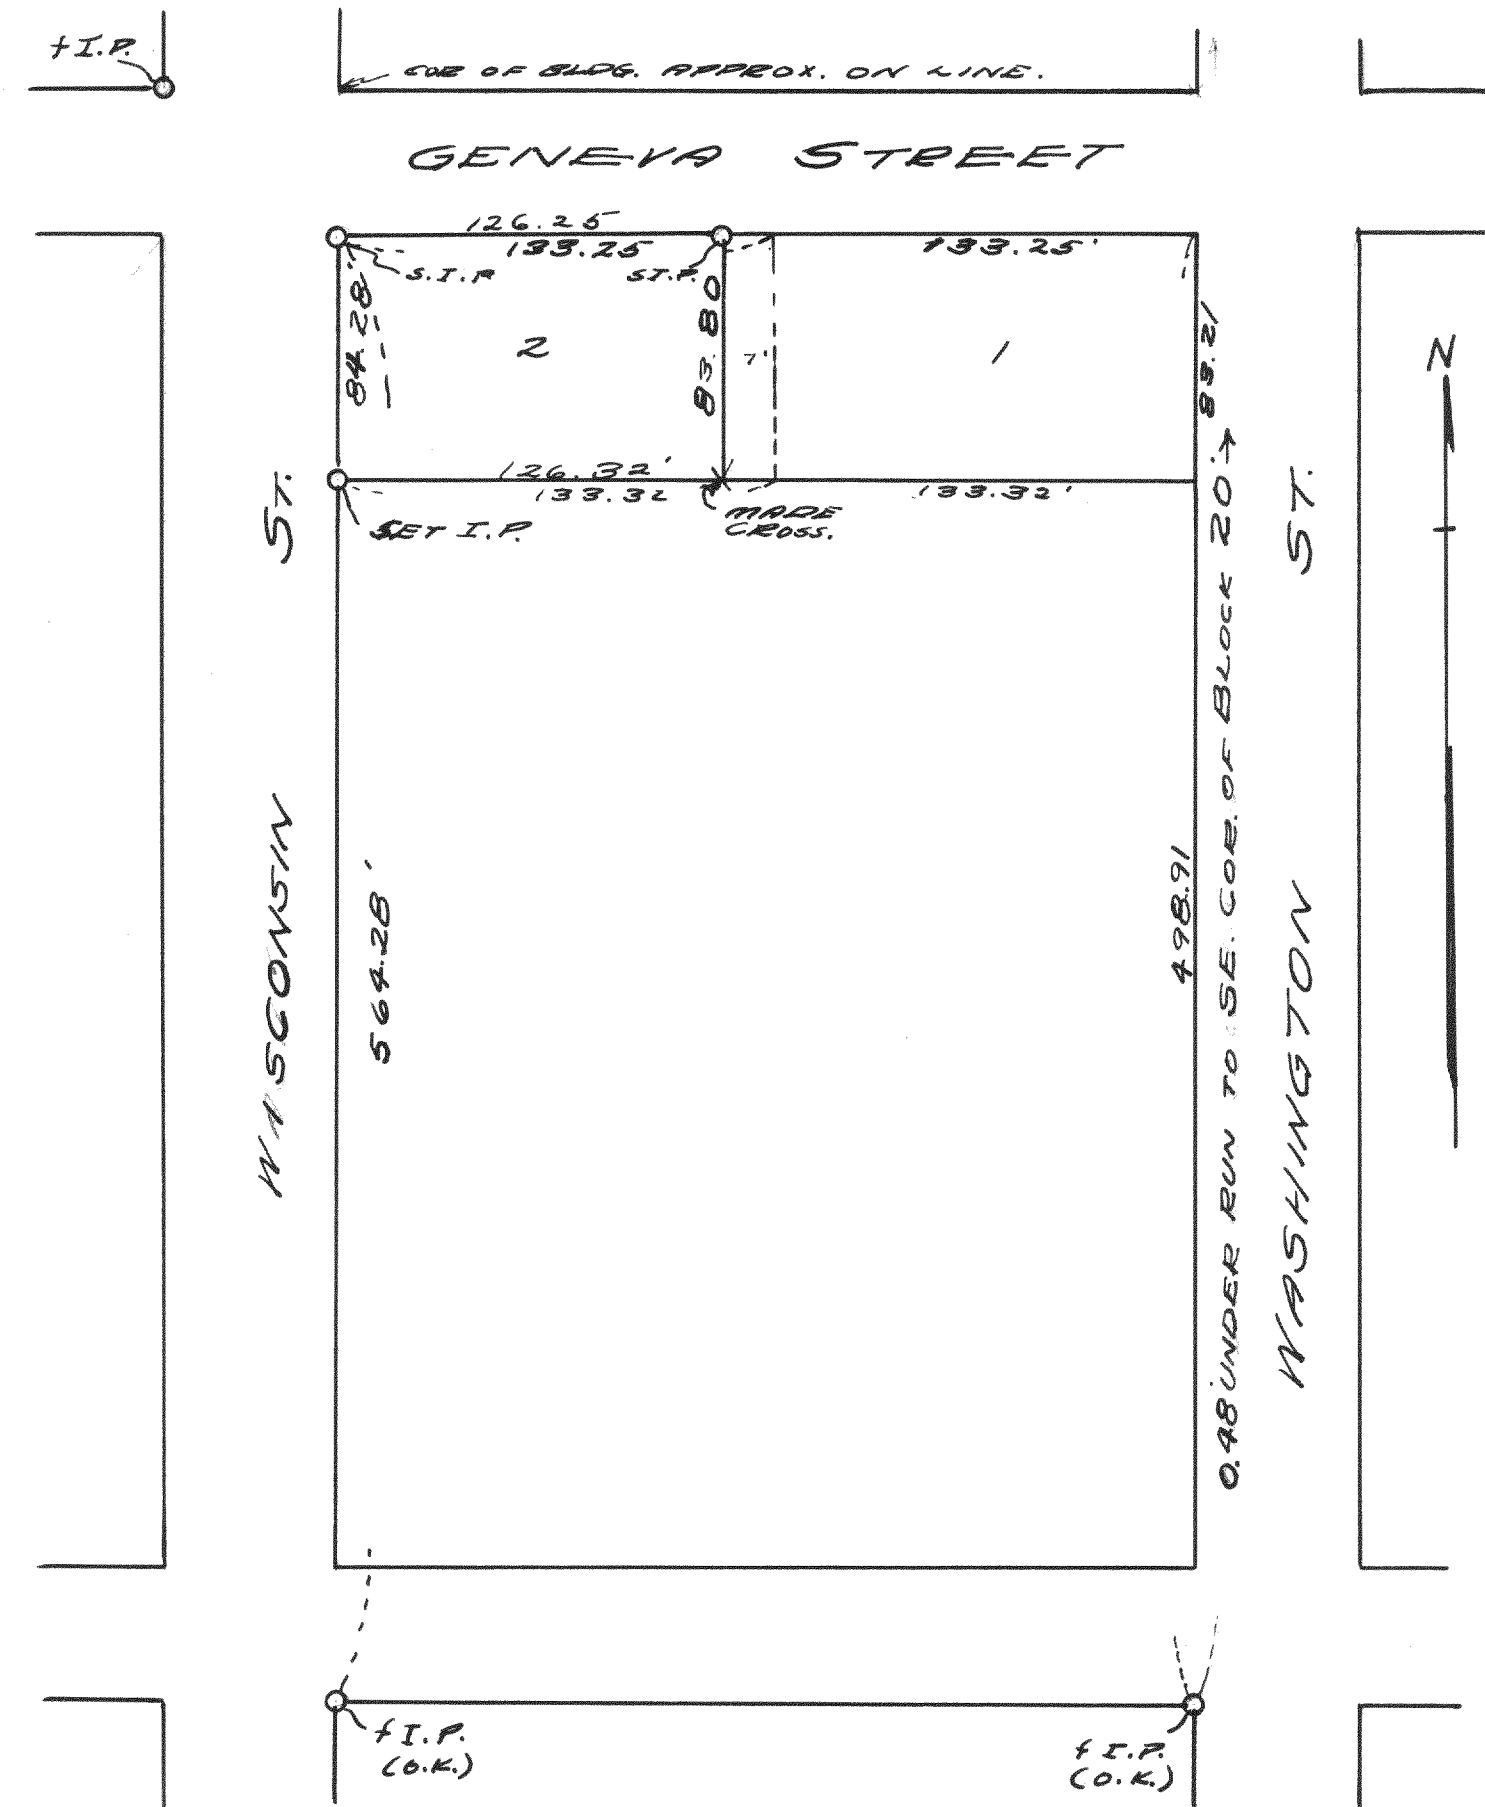

PLAT OF SURVEY OF LOT 2 (EXCEPT THE
EAST 7' THEREOF) OF BLK. 33 OF THE ORIGINAL
TOWN OF ELKHORN, WALKWORTH COUNTY,
WISCONSIN
MAY, 1941

Lloyd L. Jensen
S.E.G.