



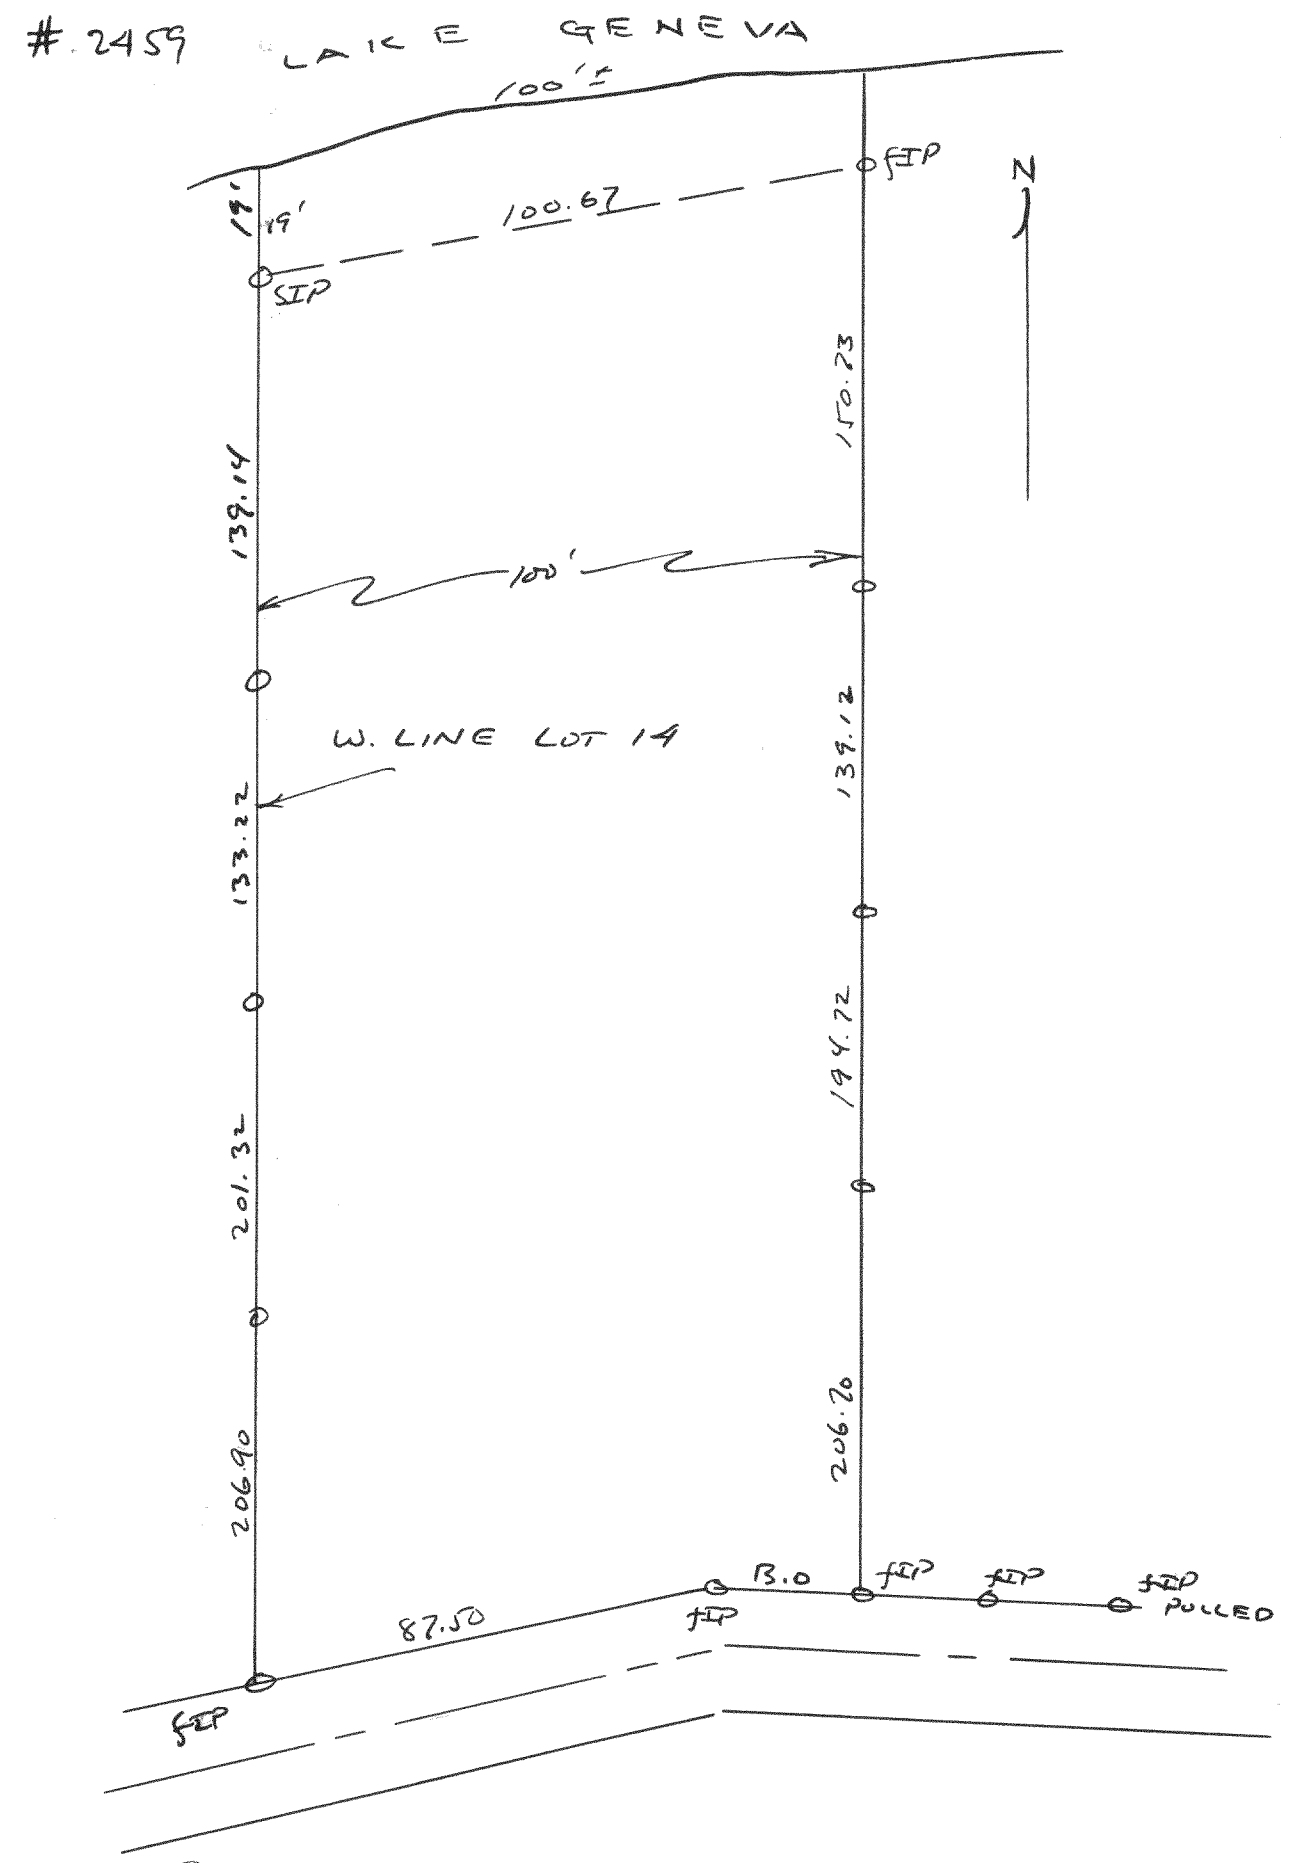

Plat of survey of 100' strip of land located east of the W. line of lot 14 of the Biches Subdivision T1N R17E, Walworth County, Wisconsin
1951
Lloyd S. Jensen 9EB
County Surveyor

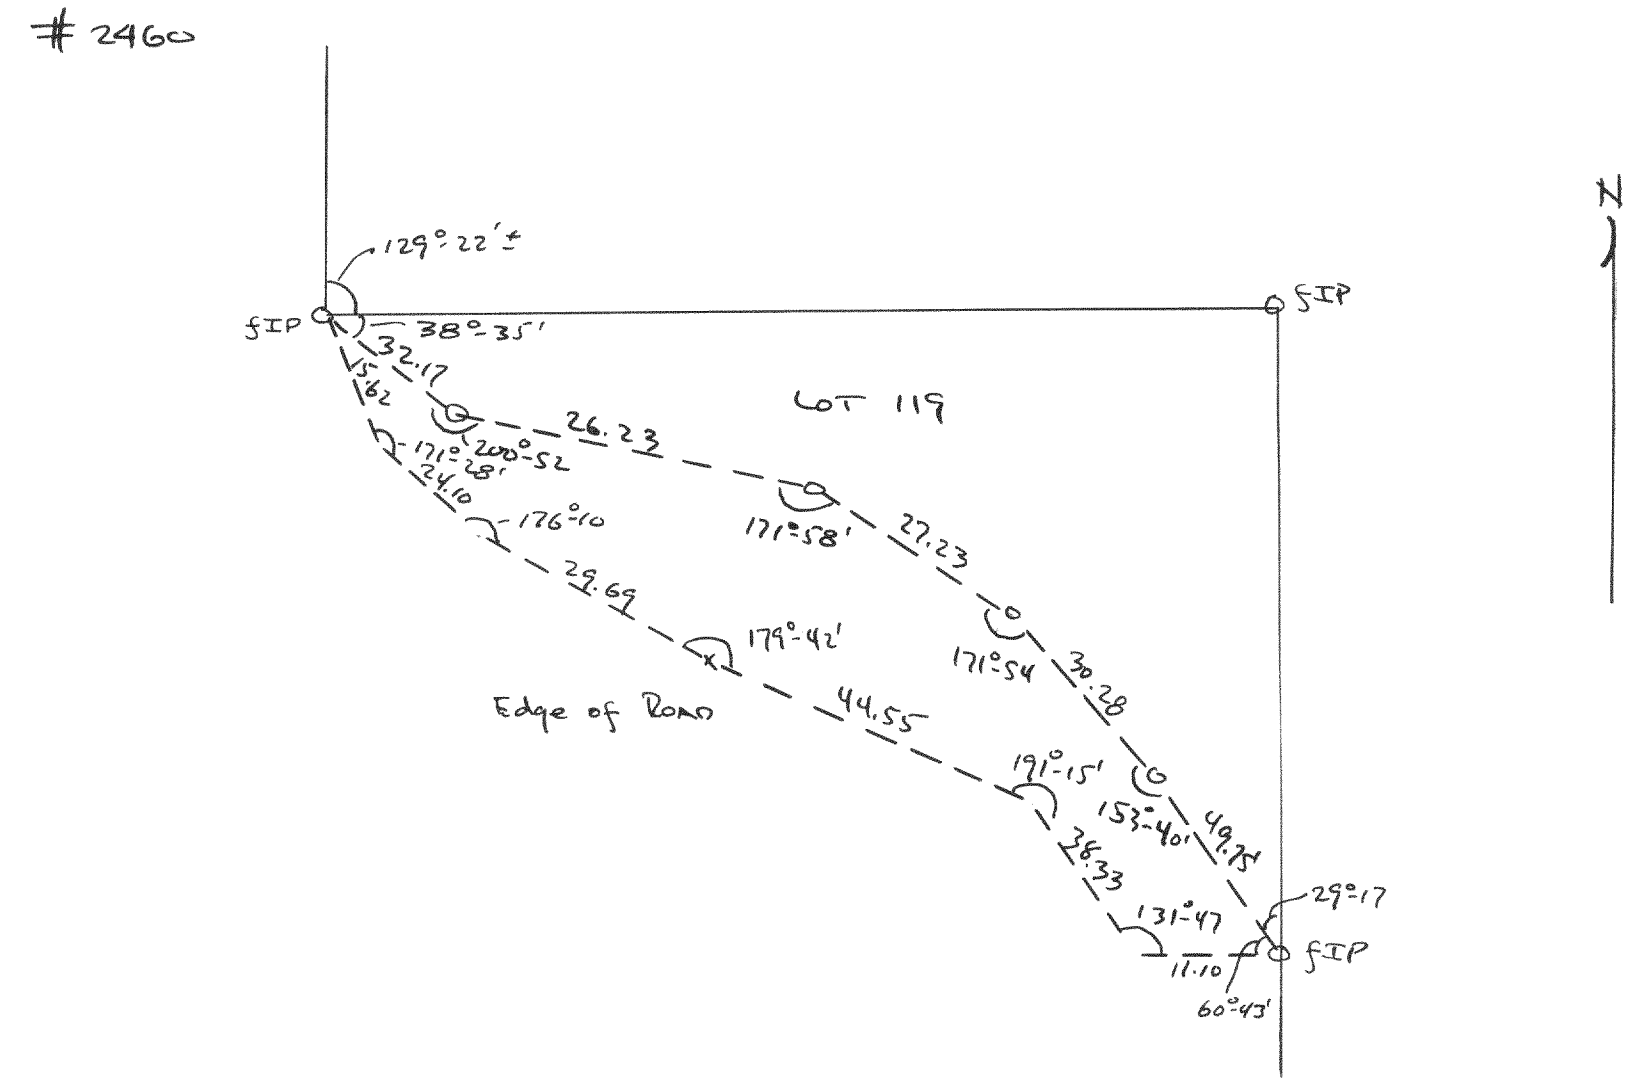

Plat of survey of the land located between the edge of the road & the S line of lot 119, Lake Geneva Beach Subdivision, T1N R17E, Walworth County, Wisconsin
March 20, 1951
Lloyd S. Jensen 9EB
County Surveyor