



2463

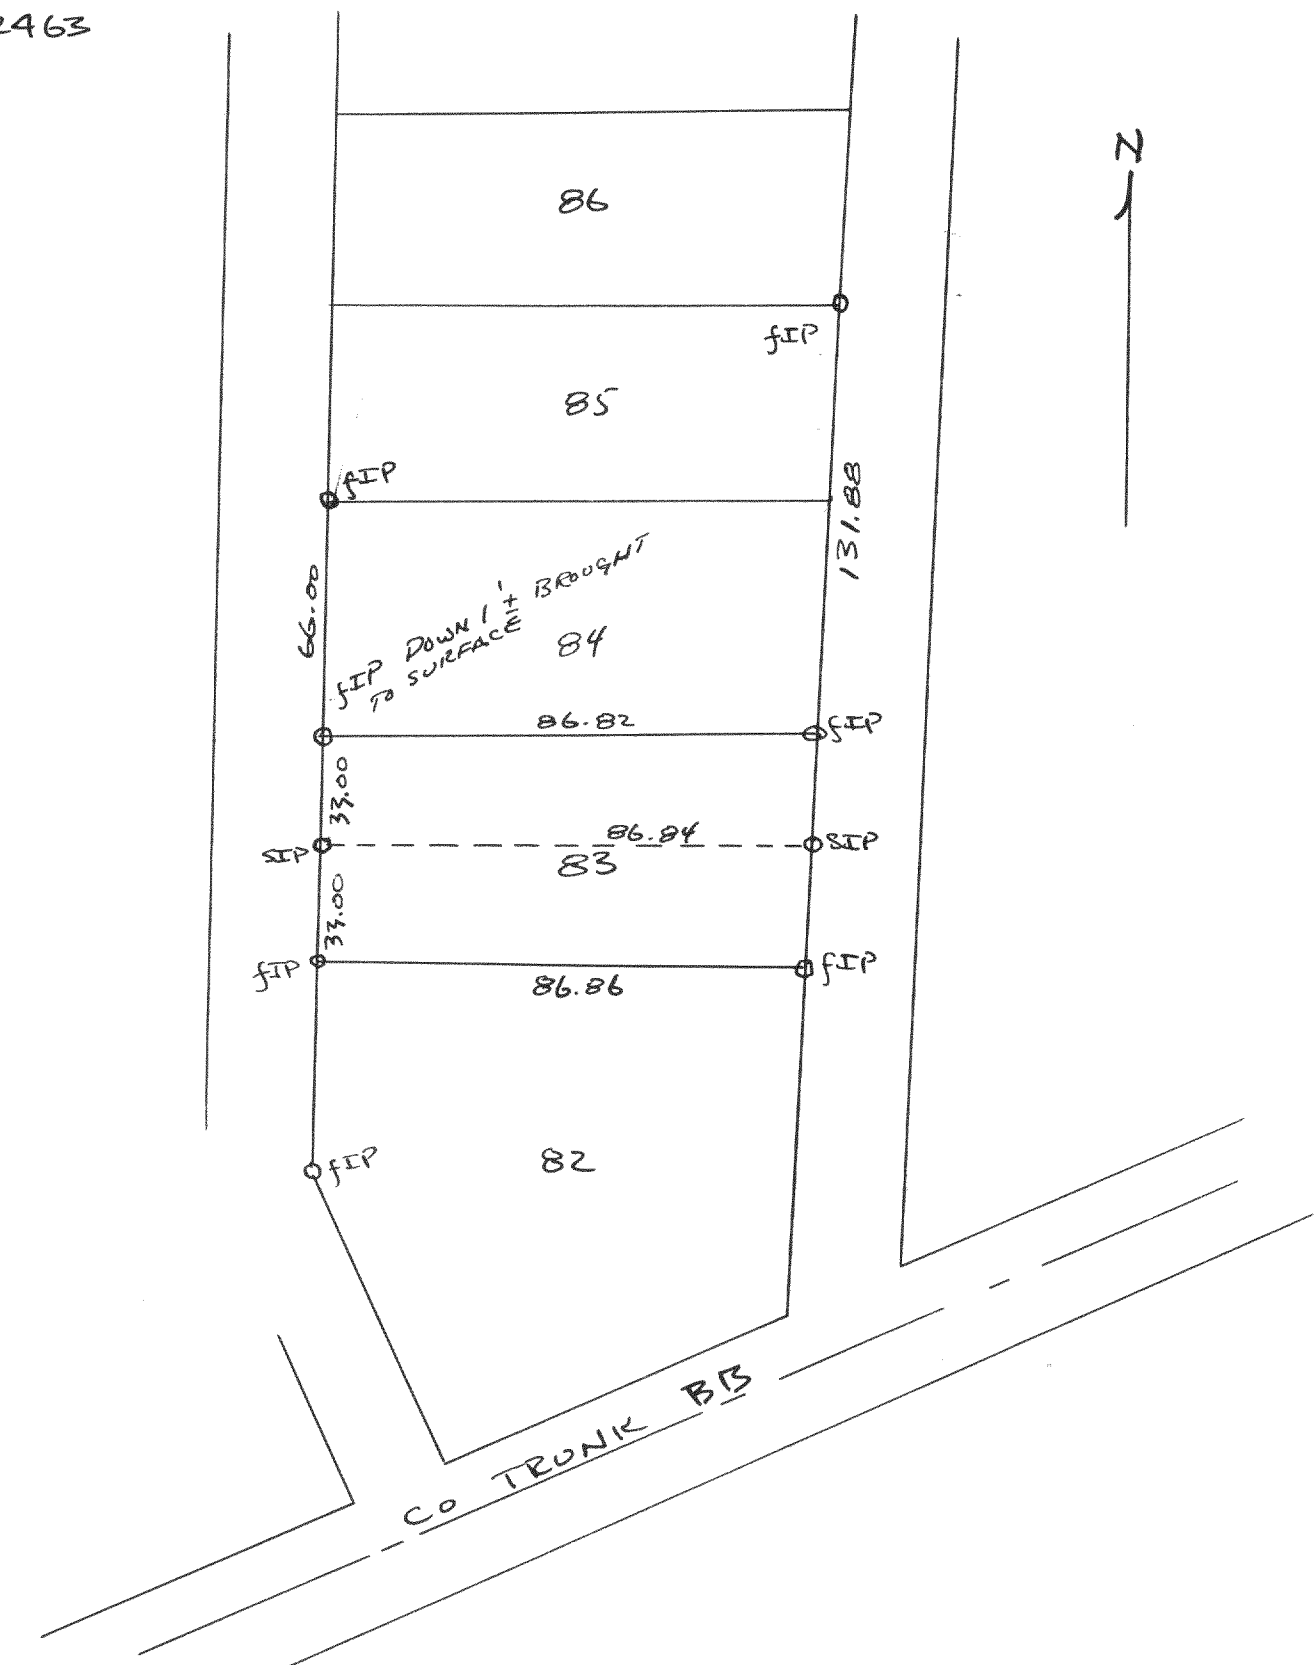

Plat of survey of the N 1/2 of lot 83, Robinsons 2nd Subd.
located in the NW 1/4, Sec 14, T14N R17E, Walworth County, Wisconsin
Lloyd L. Jensen JCB
County Surveyor

2464

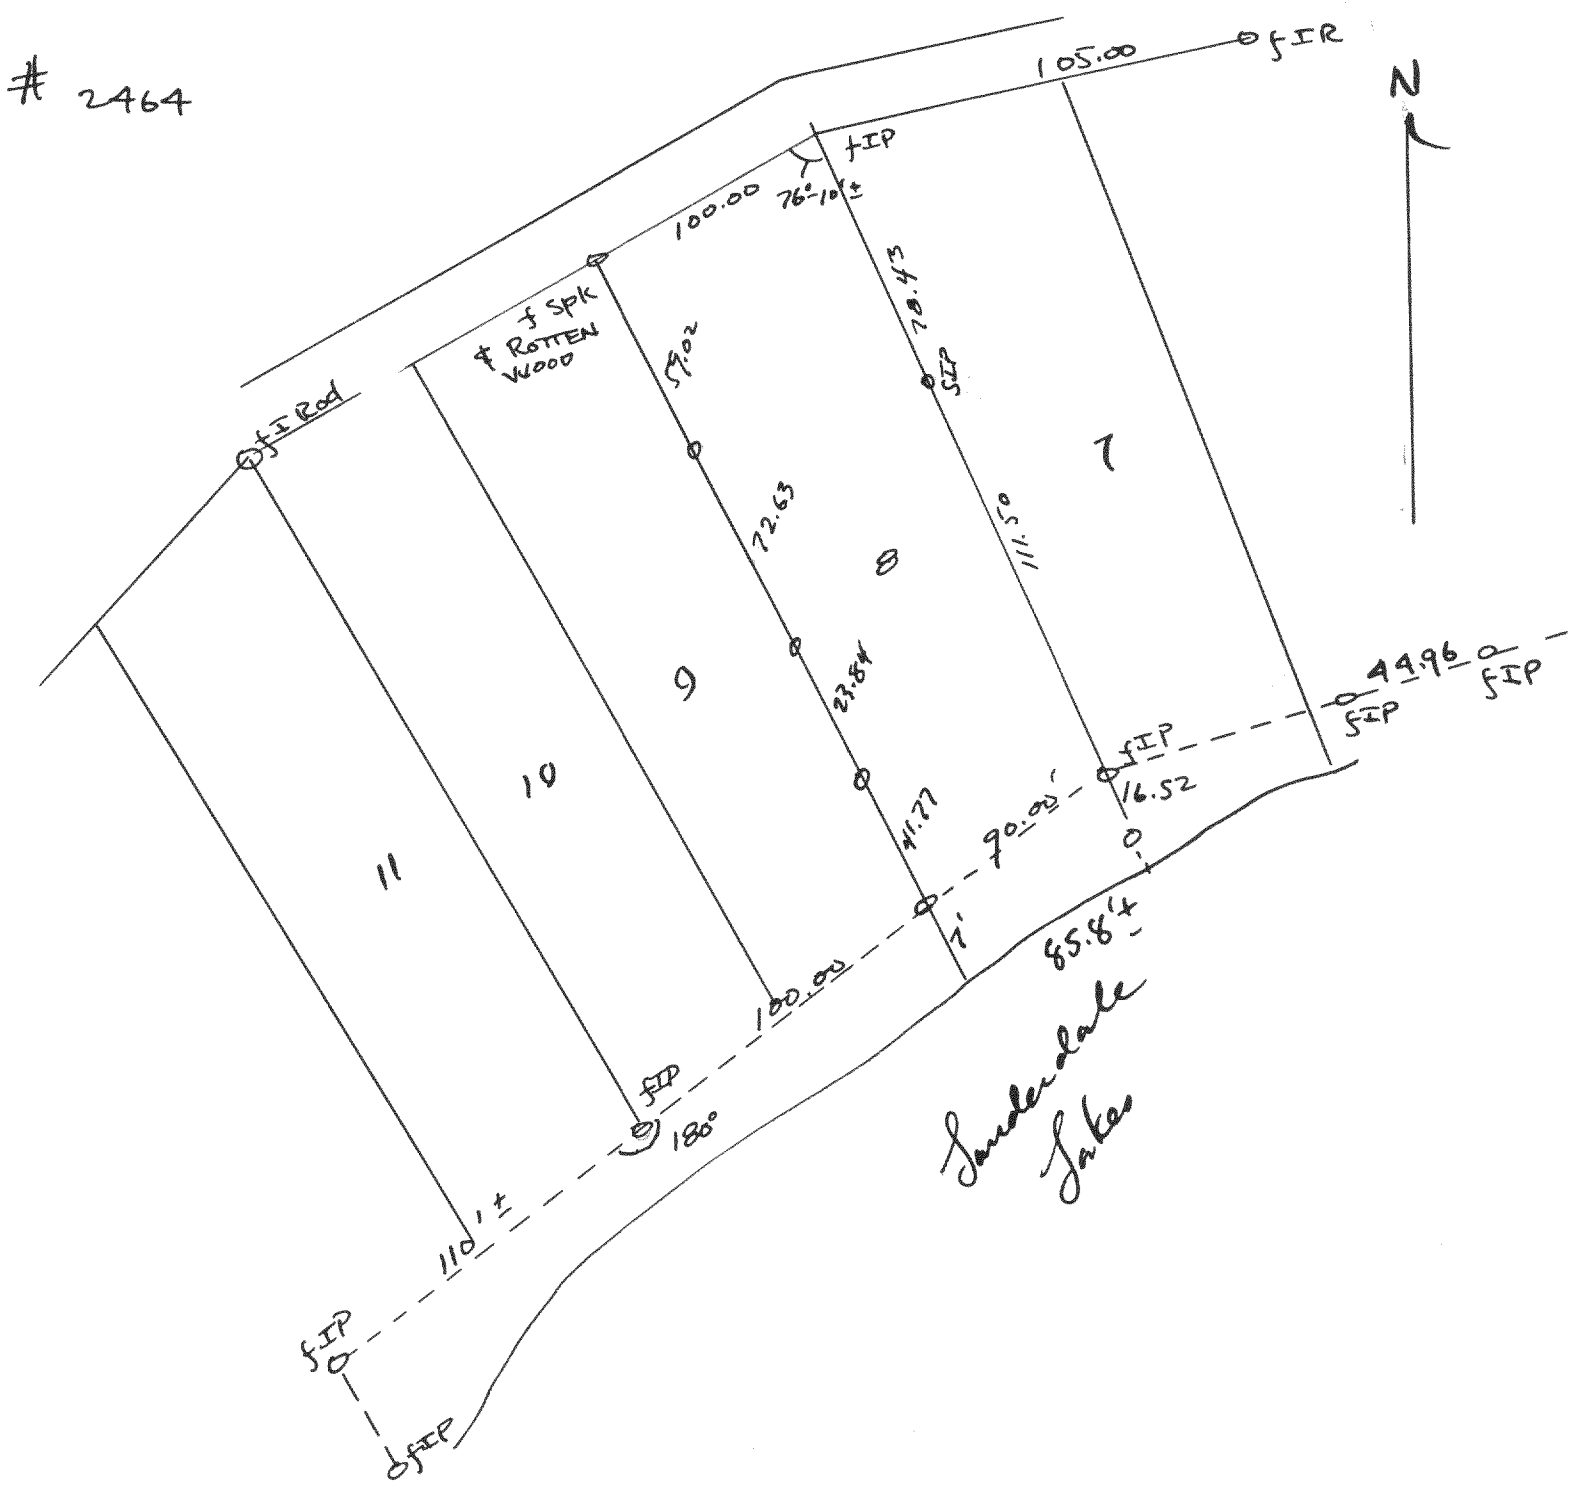

Plat of survey of lot 8, Oak Park Subdivision located in Sec.
26 T4N R16E, Walworth County, Wisconsin
May 17, 1951
Lloyd L. Jensen JCB
County Surveyor