



2476

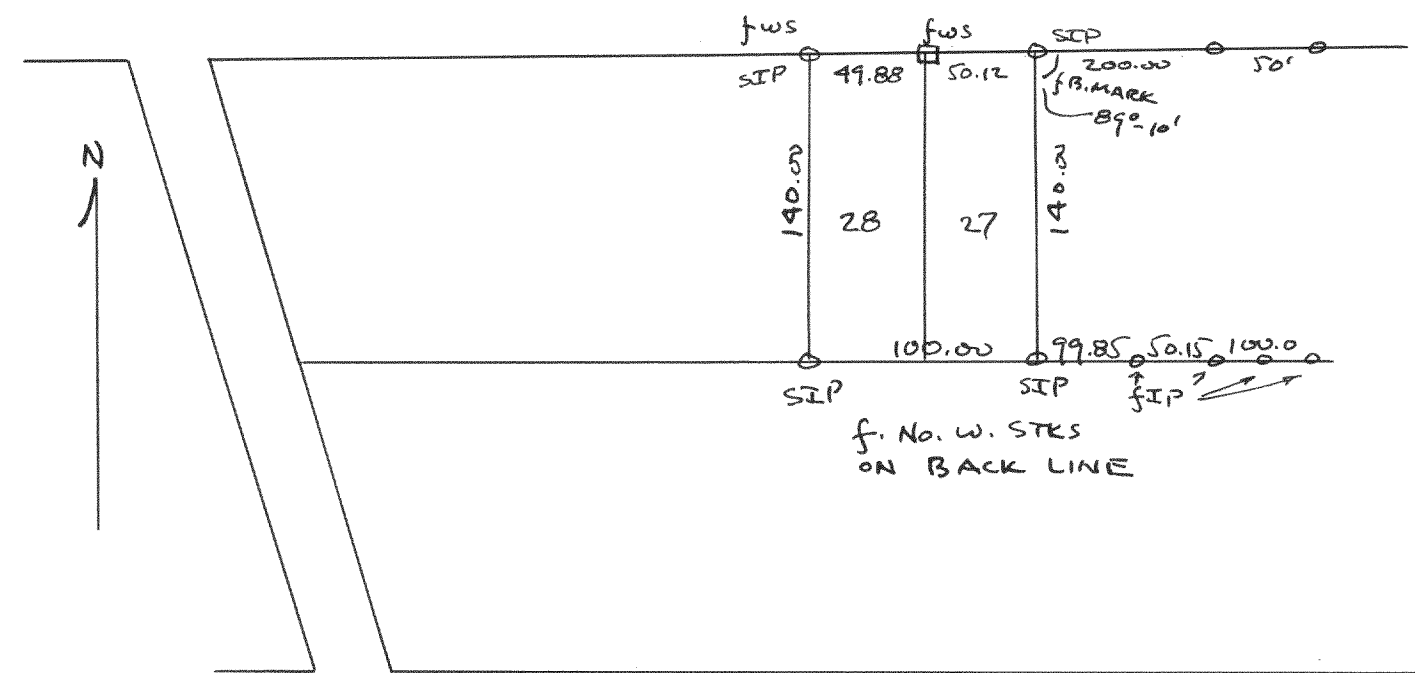


Survey of lots 27 & 28, Block 2, Inlet Oaks Subdivision No 3
located in Section 22, T2N R16E, Walworth County, Wisconsin
March 27, 1951
Lloyd L. Jensen g.e.B.
County Surveyor

2478

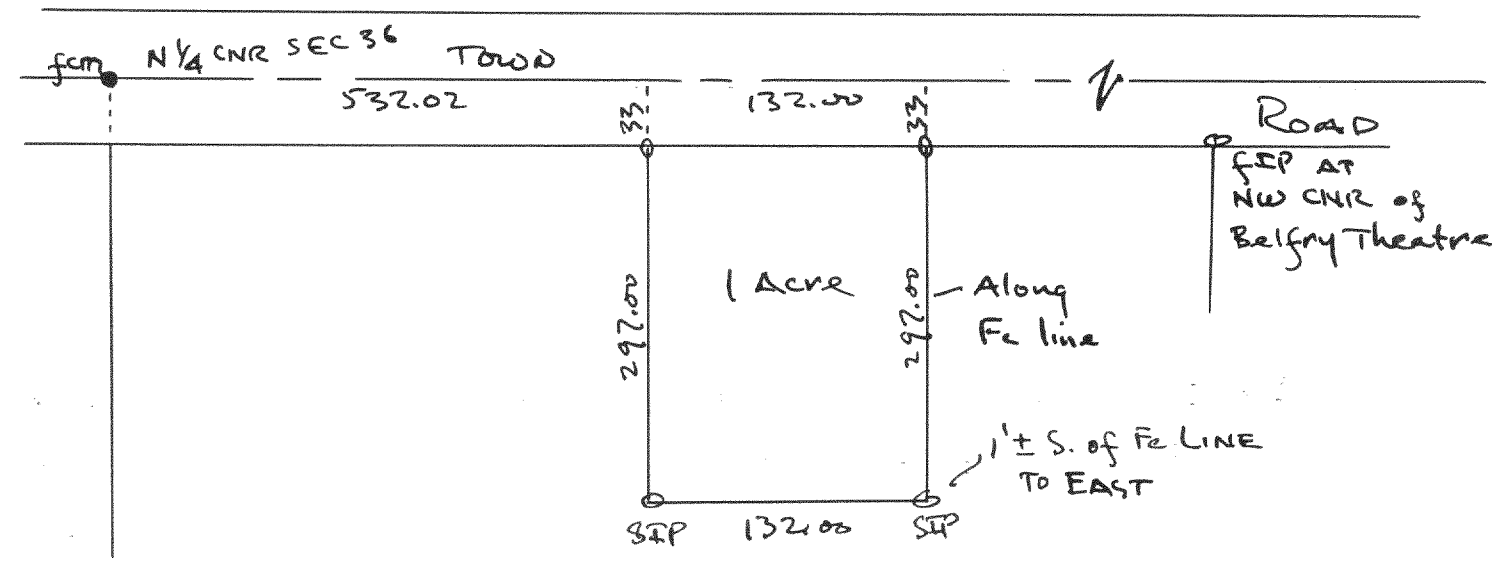

Plat of survey of 1 acre parcel on John Ingersoll property
located in the NE $\frac{1}{4}$ of Section 36, T2N R16E, Walworth County, Wisconsin
May 31, 1951
Lloyd L. Jensen rec
County Surveyor


2477

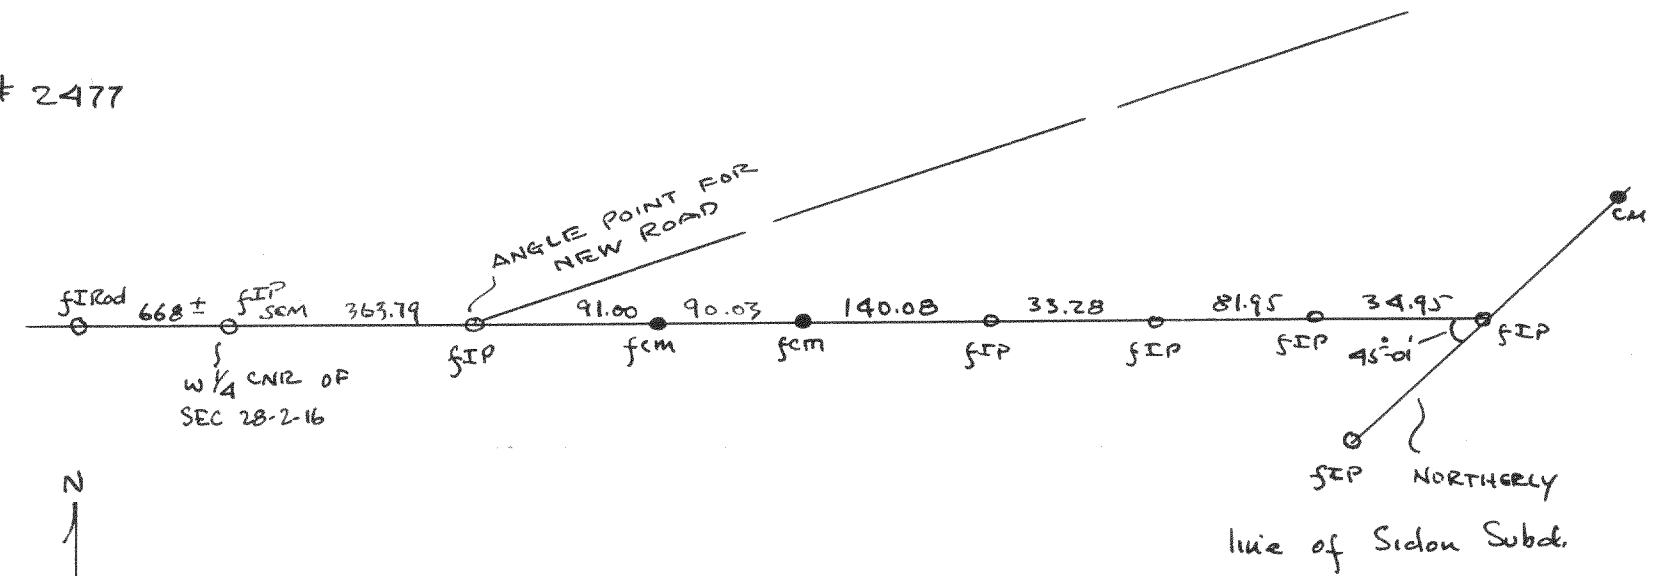

Survey of part of the E-W $\frac{1}{4}$ Section line of Section 28
T2N R16E of Walworth County, Wisconsin
April 11, 1951
Floyd S. Jean

Lloyd S. Jensen 9EB
County Surveyor

2479

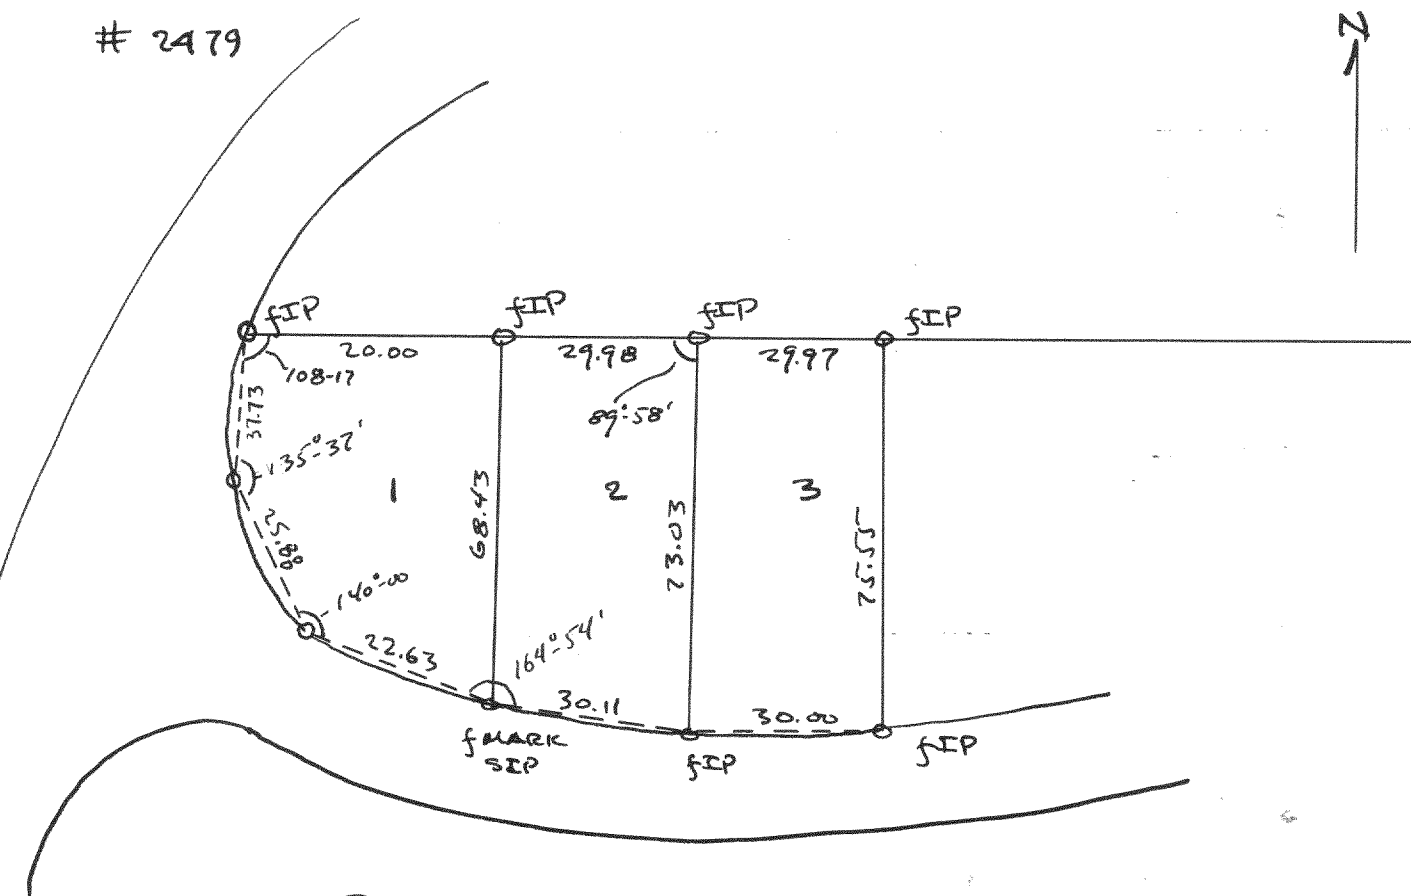

Plat of survey of lots 1 & 2 Block Y of Assembly
Park located in Section 21, T2N R16E, Walworth County,
Wisconsin
Aug. 1, 1951
Hoyd L. Jensen 9-EB

Harold L. Jensen 9-EB
County Surveyor