



SURVEY NO. 1293

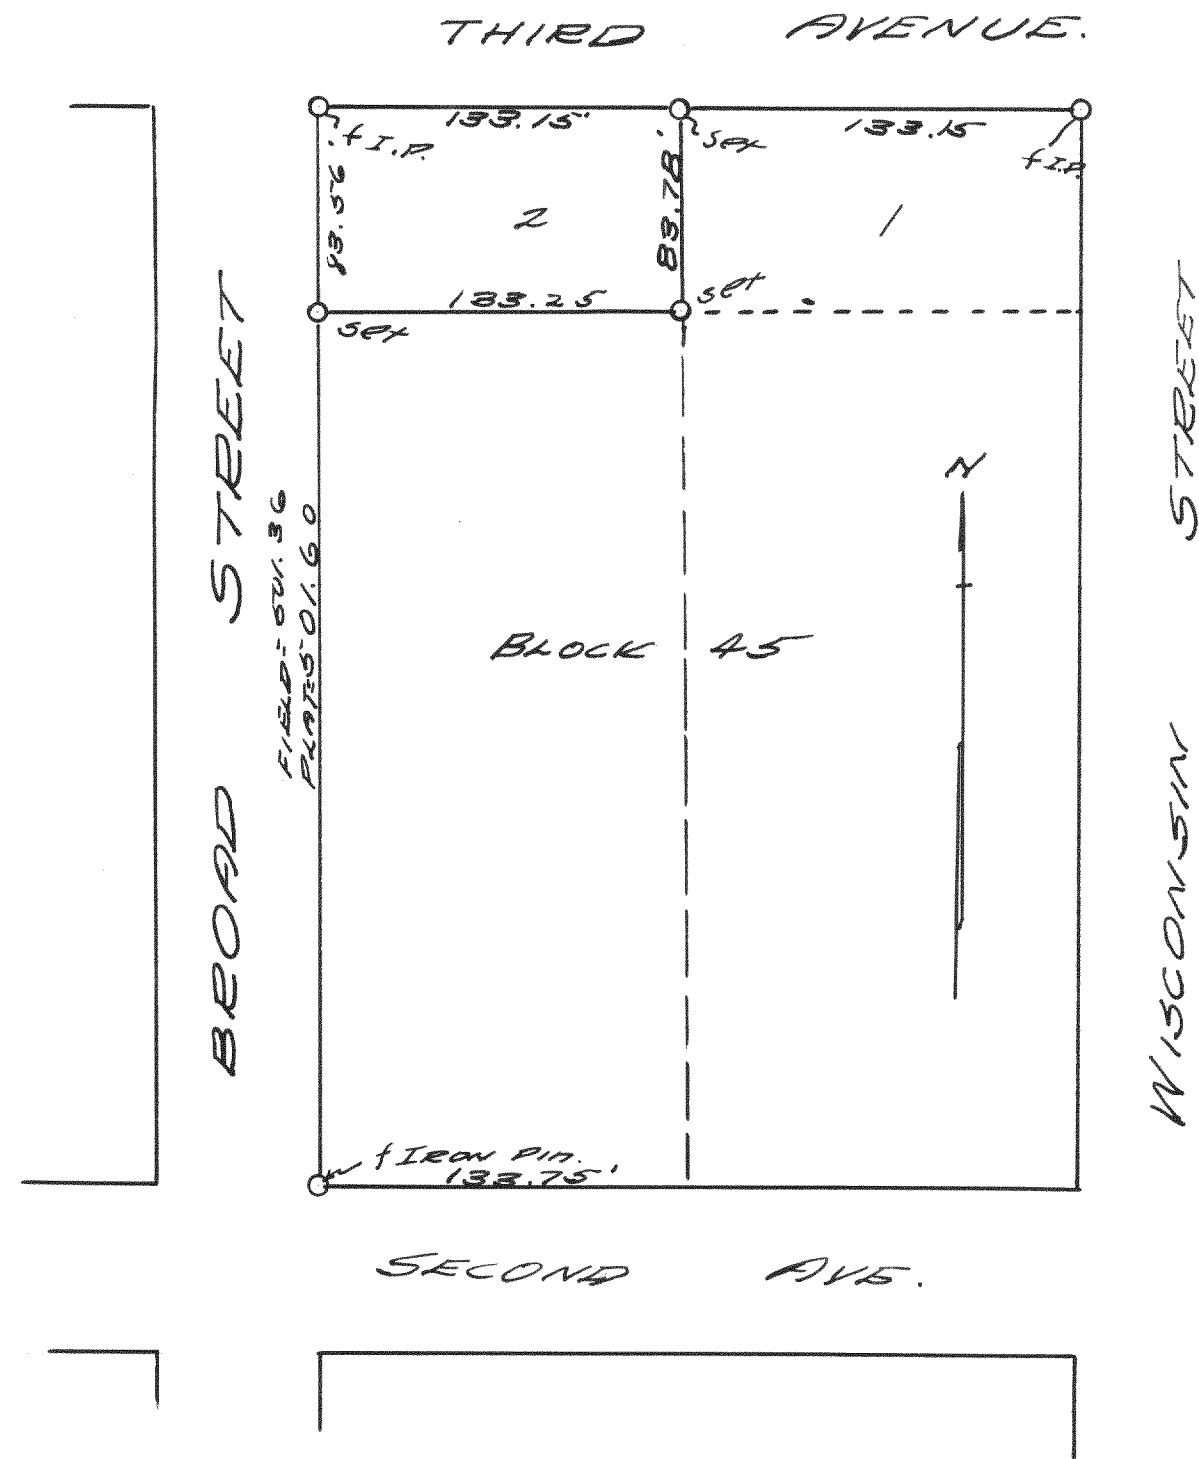

PLAT OF SURVEY OF LOT 2, BLOCK 45
OF DAVIS' ADDITION.
NOV. 1941

Lloyd L. Jensen
REG.

SURVEY NO. 1294

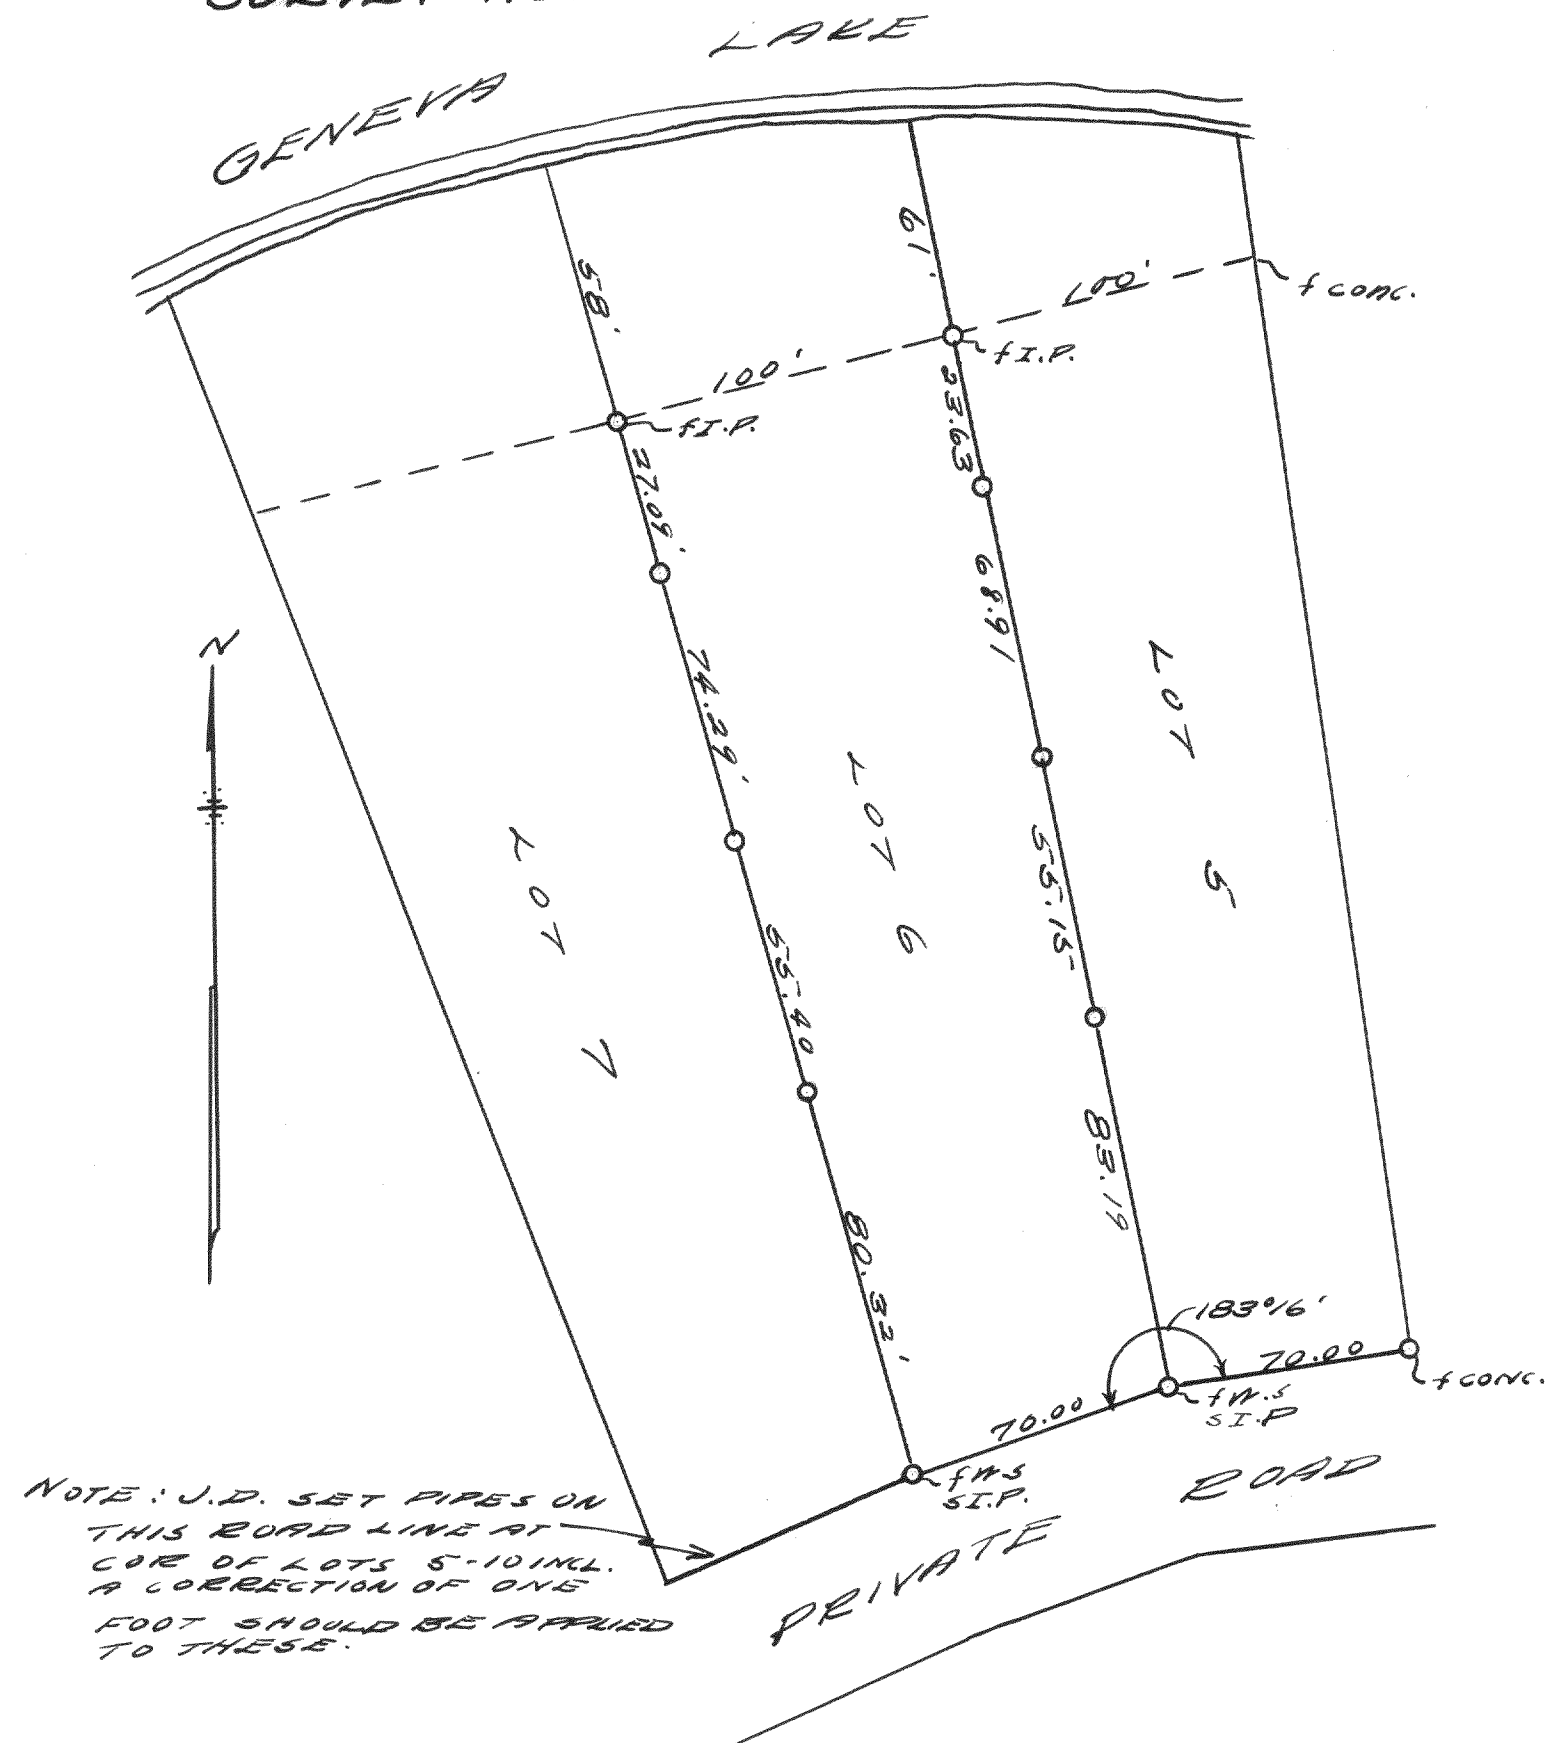

PLAT OF SURVEY OF LOT 6 OF "THE
BIRCHES" TINRITE, WALWORTH COUNTY, WISC.
JUNE 7, 1941

Lloyd L. Jensen
REG.