



2480

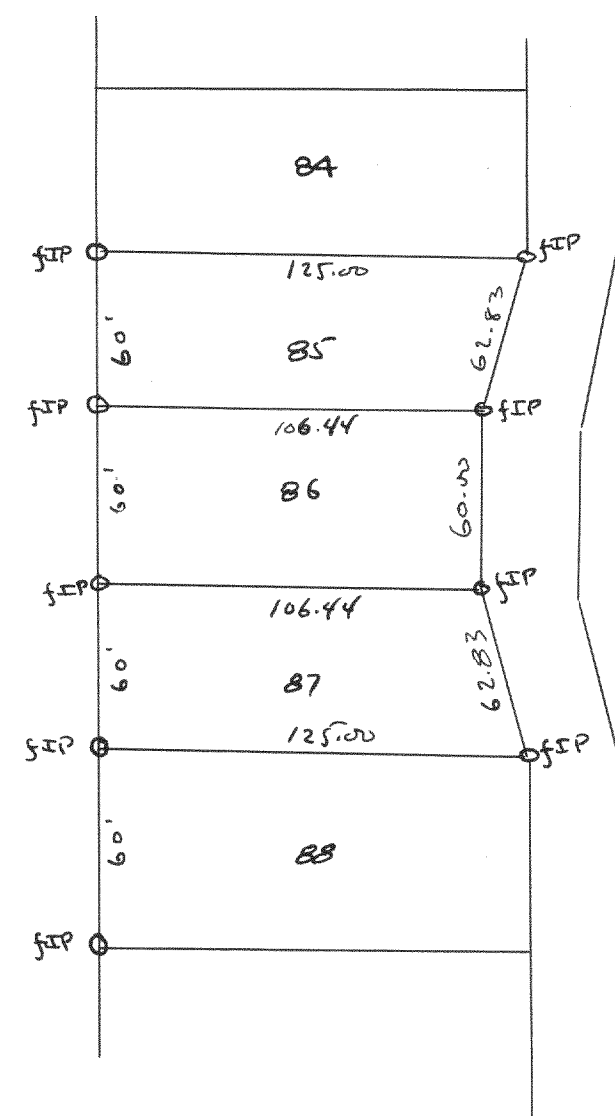

Plat of survey of lots 85, 86, 87 of Jackwood Subdivision
located in Section 36, T2N R16E, Walworth County, Wisconsin
Sept 25, 1951

Slyd L. Jensen 923
County Surveyor

2481

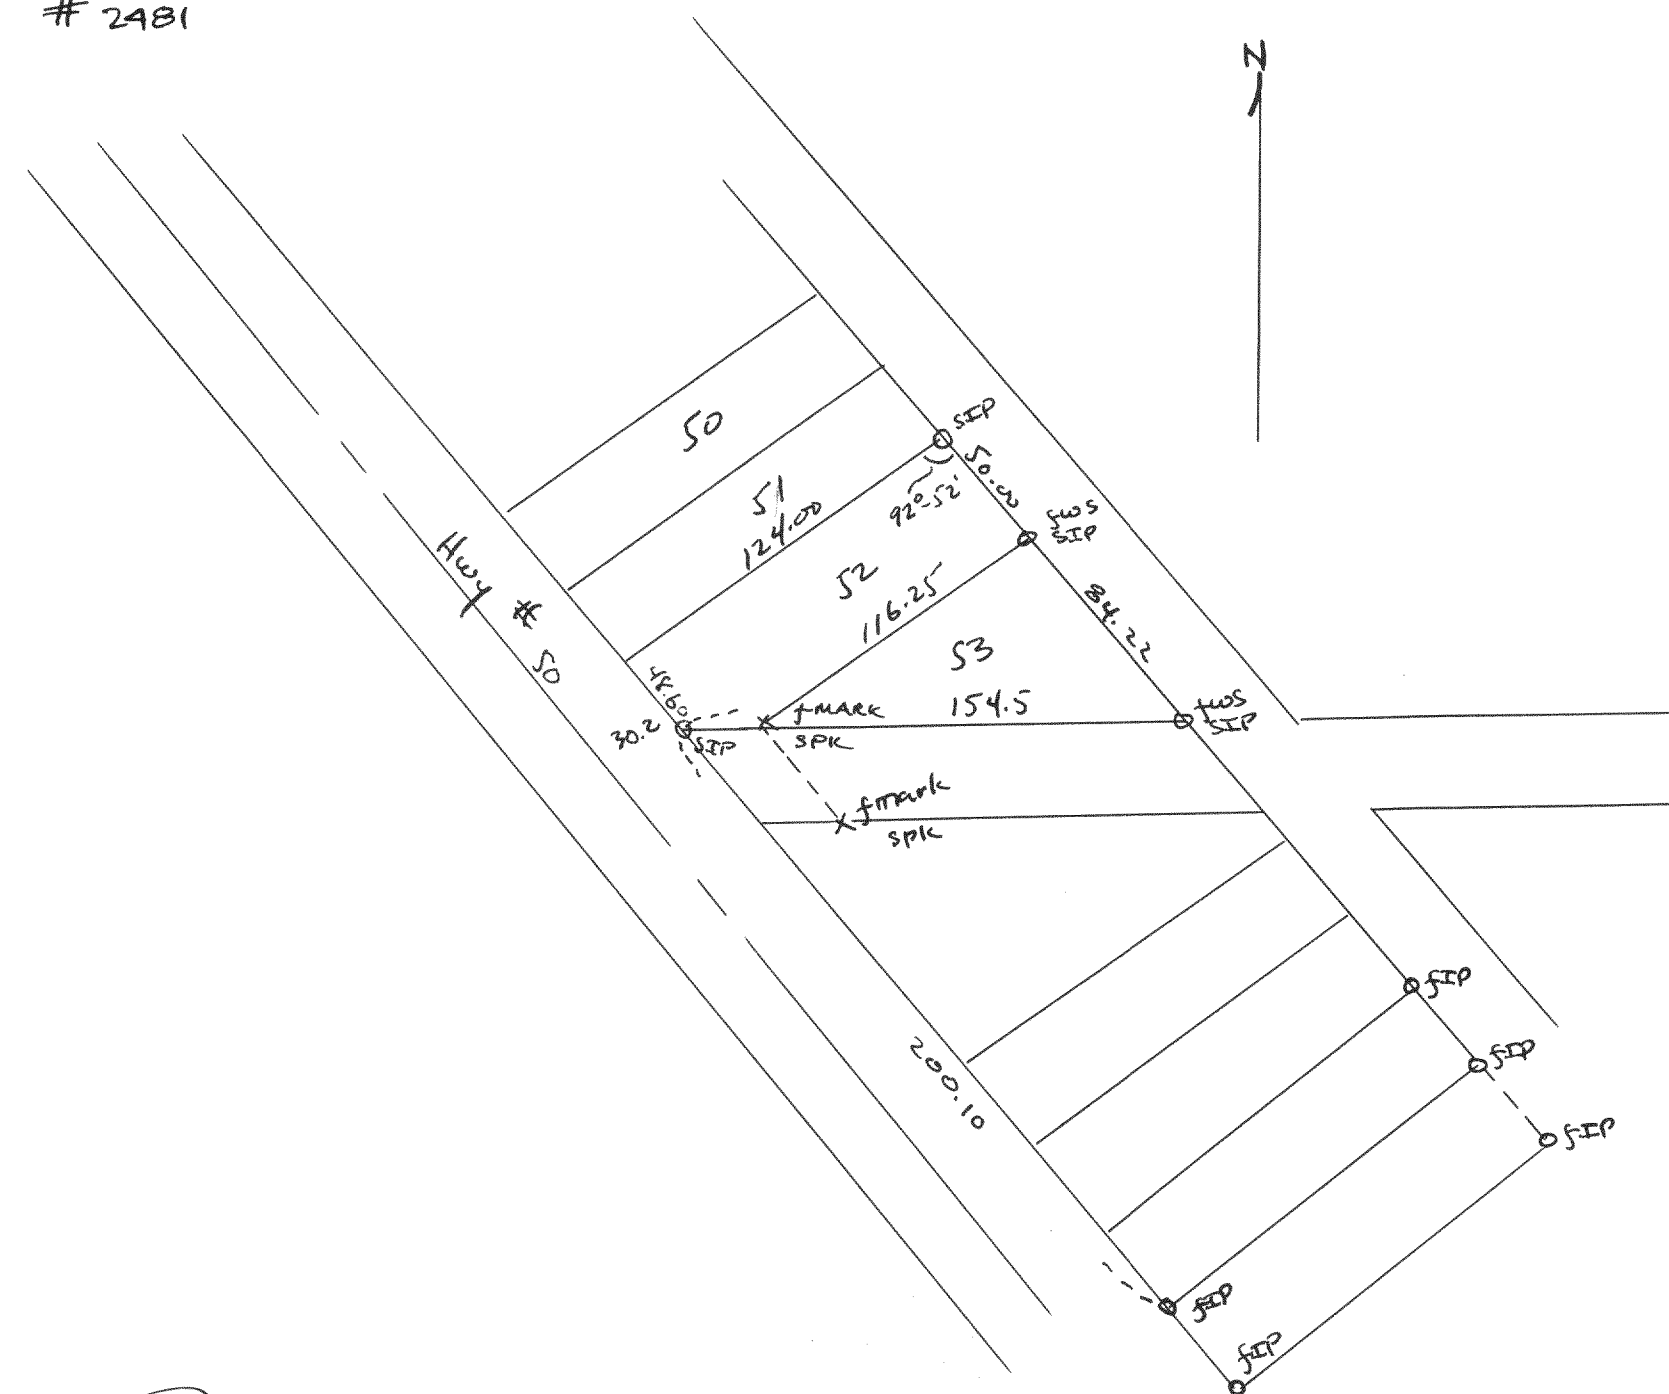

Plat of survey of lots 52 & 53, Block 3 of Lake Oak Subdivision
located in Section 22, T2N R16E, Walworth County, Wisconsin

Sept., 1951

Slyd L. Jensen 923
County Surveyor