


Lloyd L. Jensen 9EB
County Surveyor

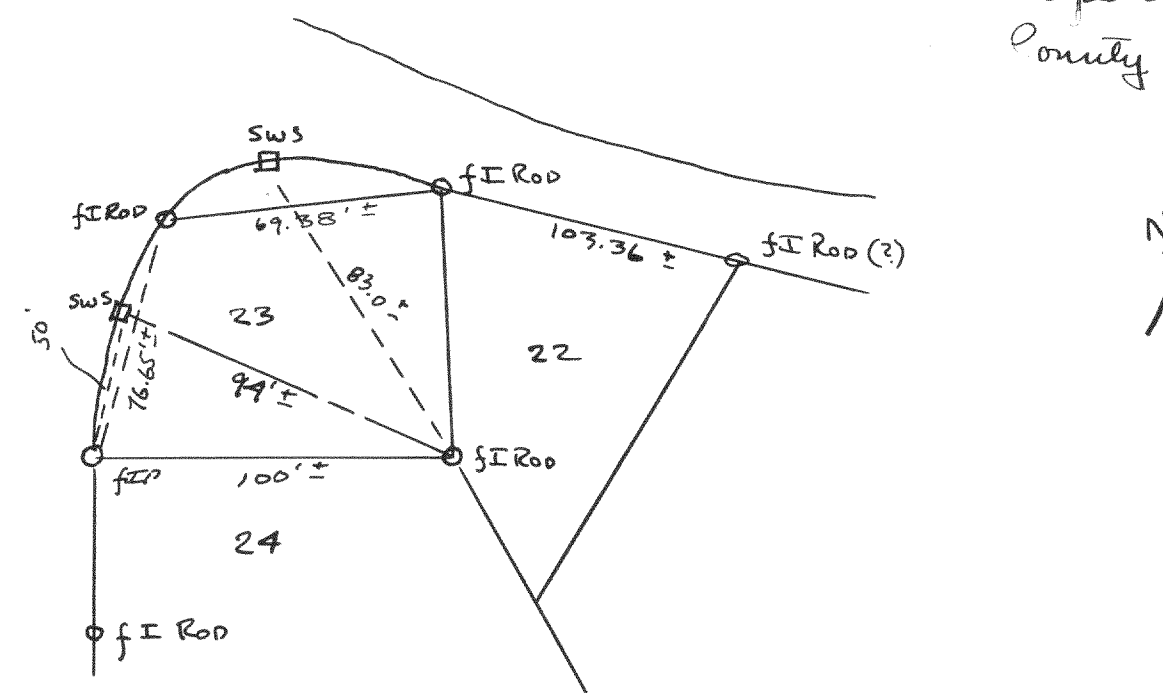

Plat of Partial Survey of lot 23, Block 6, Crystal Ensl
Subdivision located in Section 12, T3N R15E, Walworth
County Wisconsin
Aug 7, 1951

Lloyd L. Jensen 9013
County Surveyor