



2494

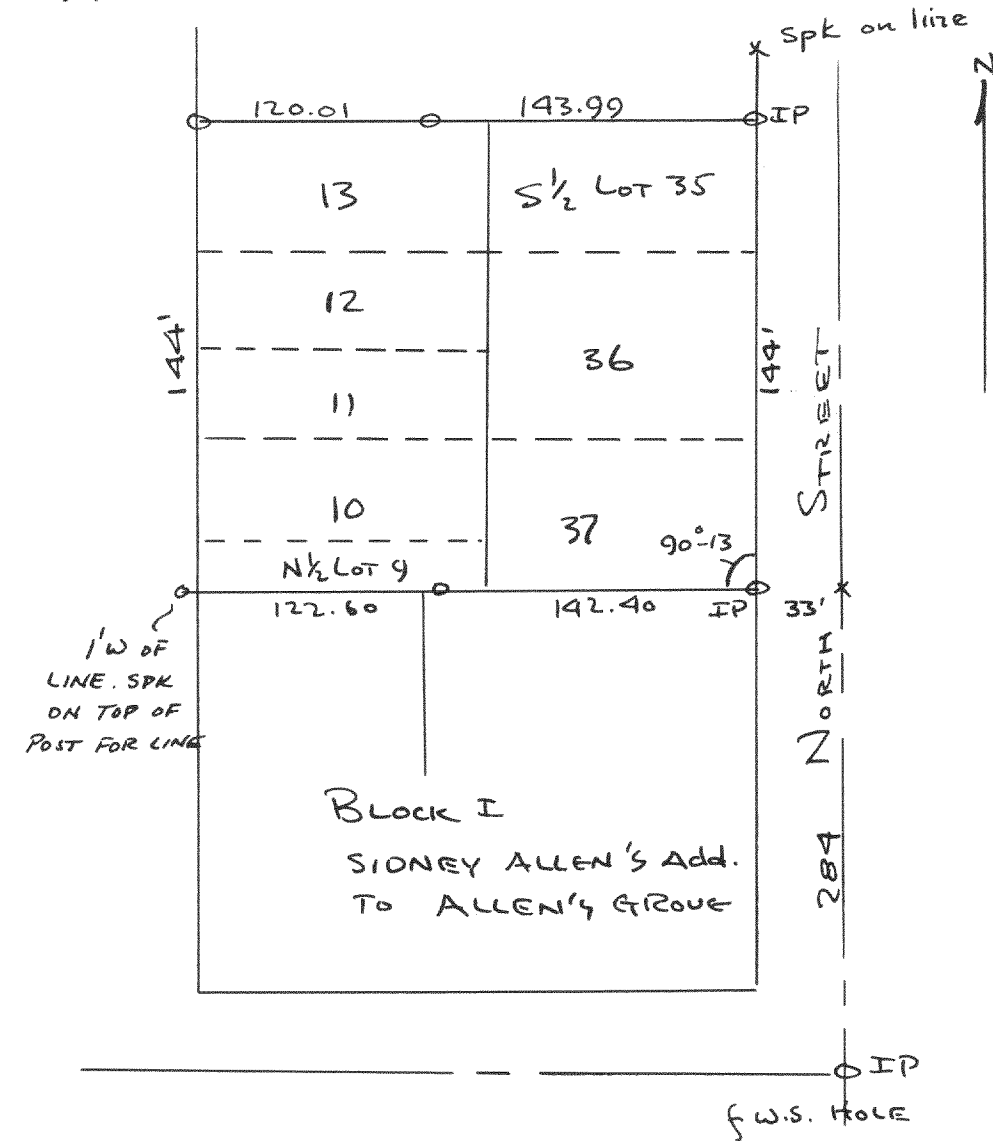

Plat of survey of N 1/2 lot 9, 10, 12, 13, S 1/2 lot 35, 36, 37
 Block I, Sidney Allen's add. to Allen's Grove, Sec. 31
 T2N R15E, Walworth County, Wisconsin
 June 13, 1951
 Lloyd L. Jensen *q.e.b.*
 County Surveyor

2495

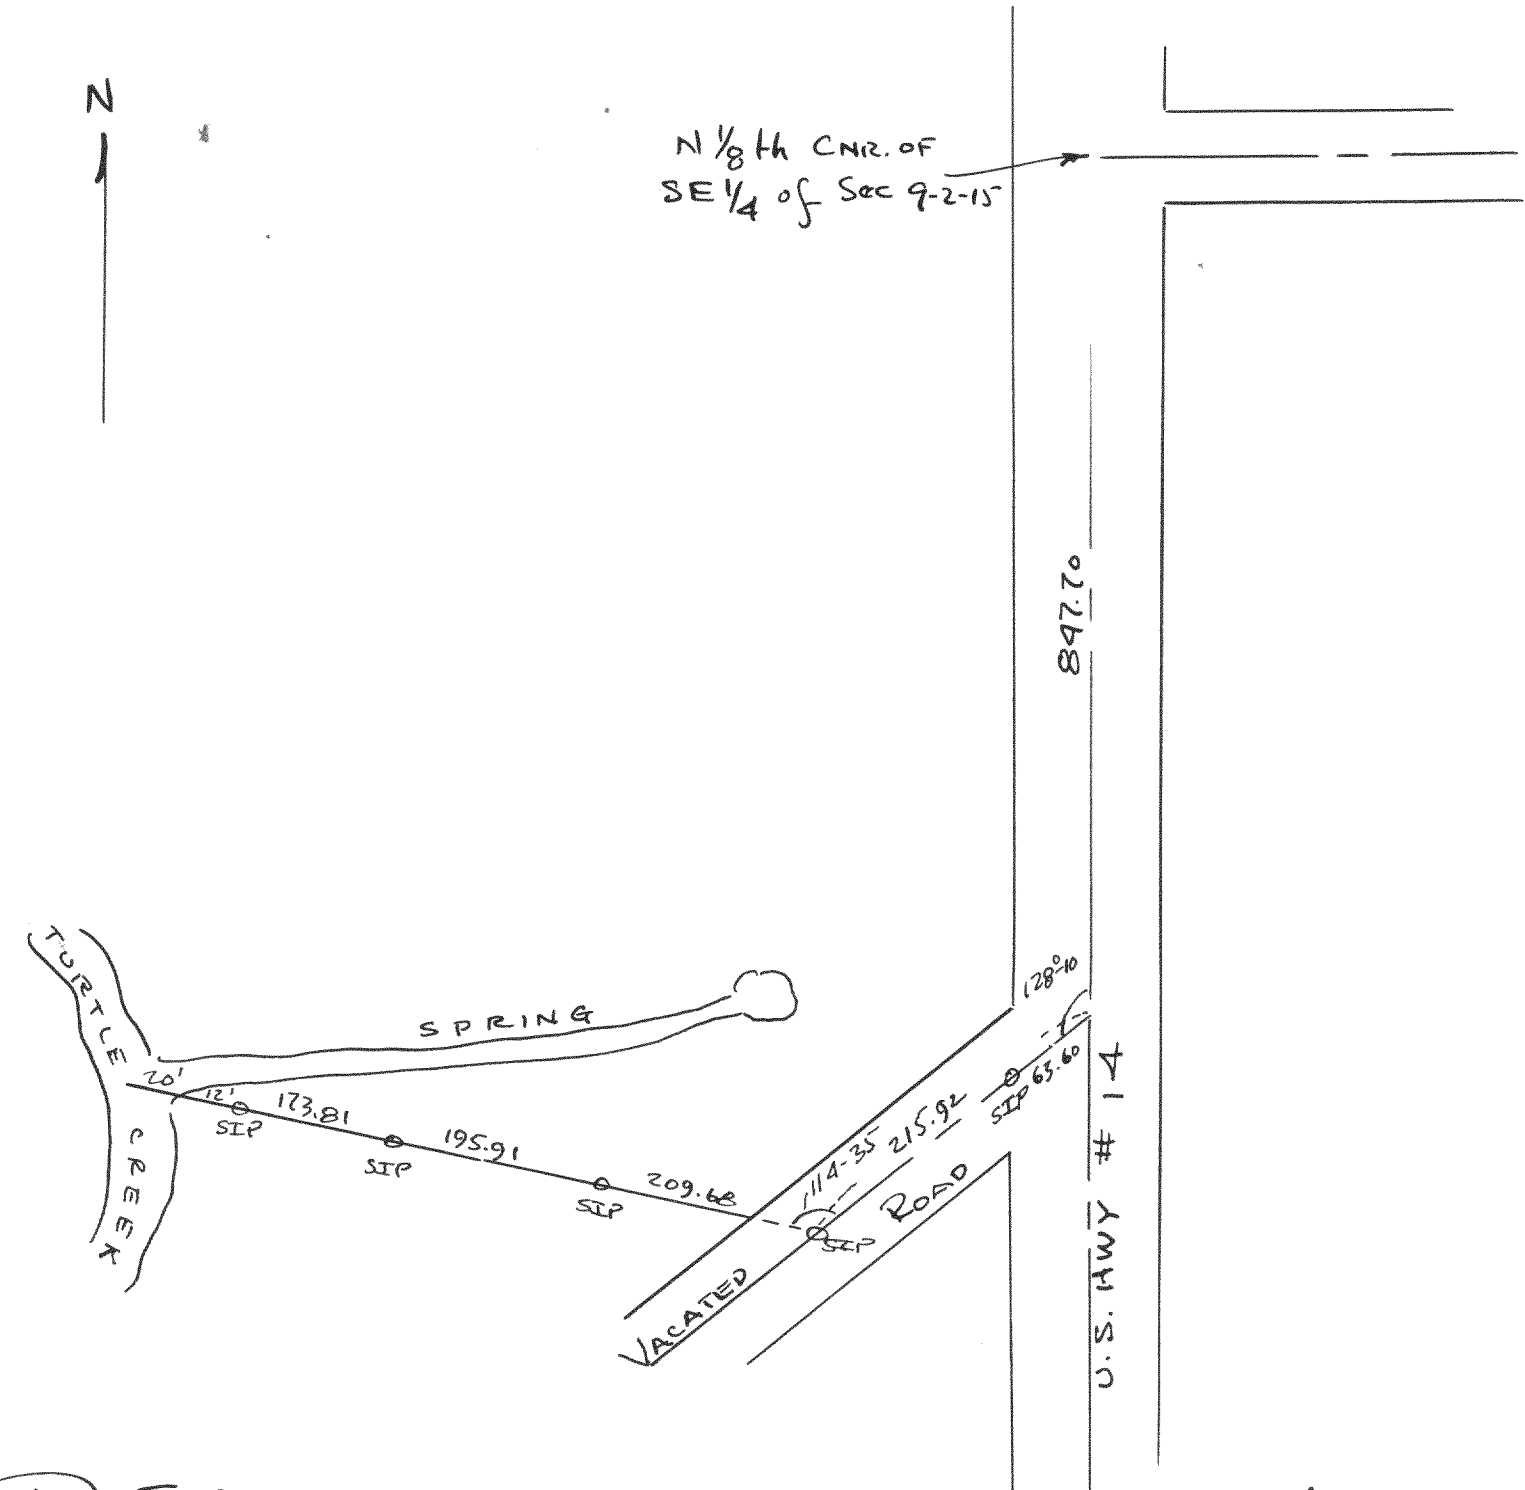

Plat of survey of the South line of the Swan Farm
 located in the SE 1/4 of Section 9, T2N R15E Walworth County
 Wisconsin
 July 31, 1951
 Lloyd L. Jensen *q.e.b.*
 County Surveyor