



2520

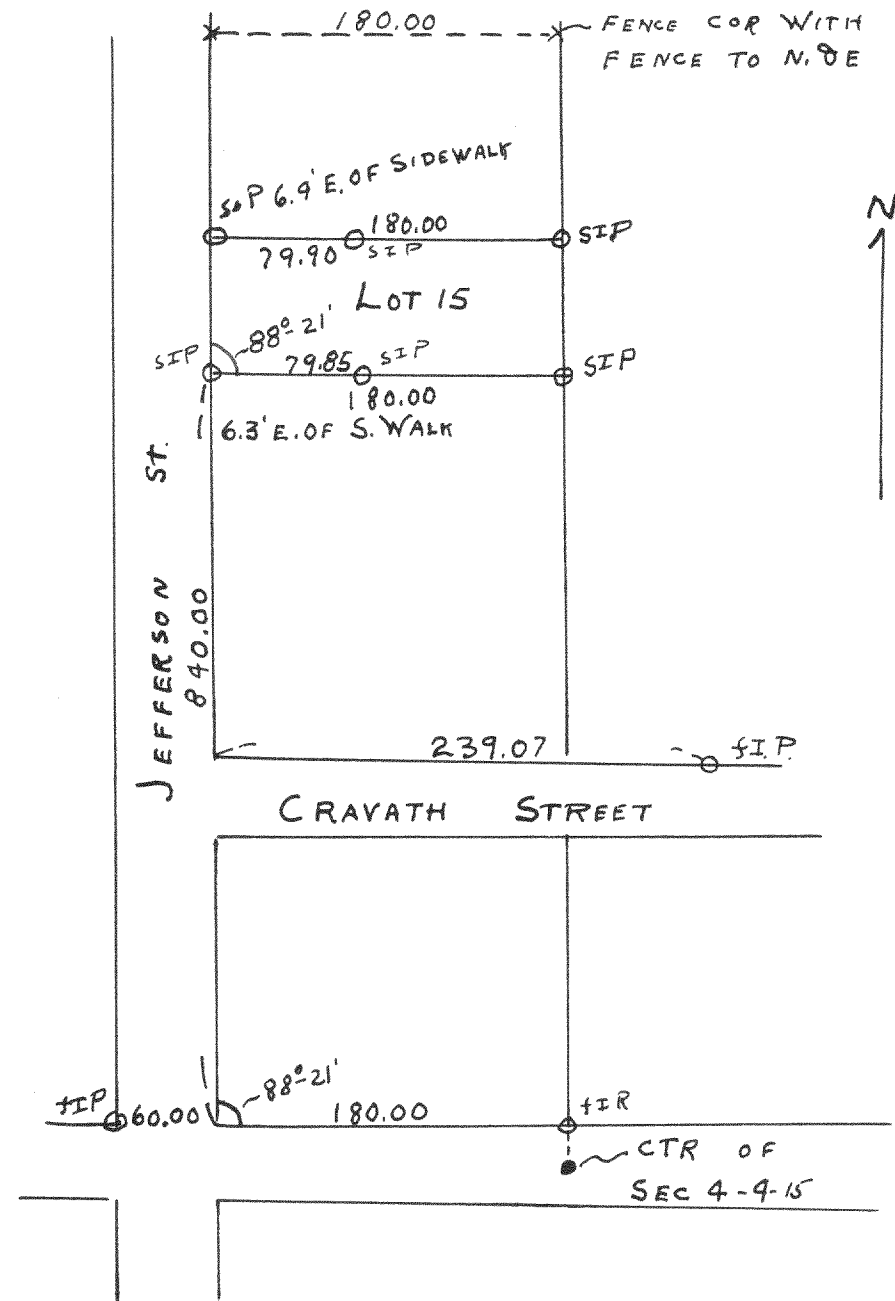


Plat of survey of lot 15 Wilsons Addition to City of
Whitewater Section 4 T4 N R16 E Walworth County, Wisconsin
June 22, 1951
Lloyd S. Jensen
County Surveyor

2521

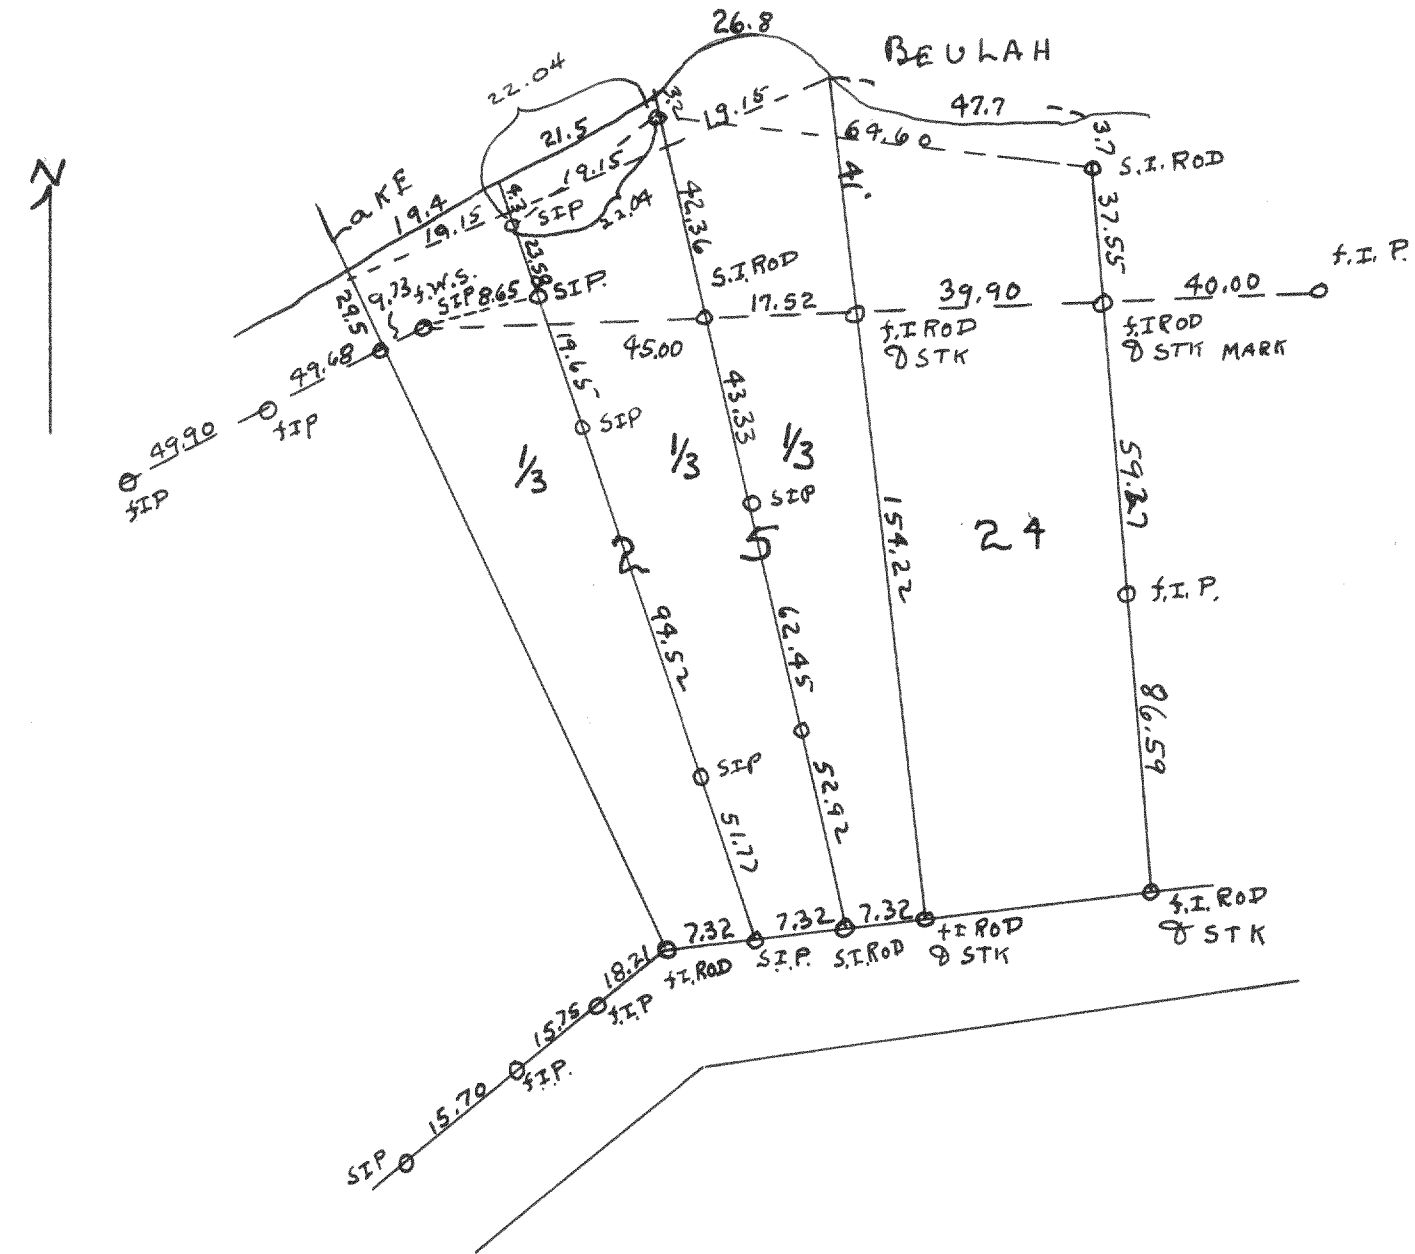

Plat of Survey of Lot 24 & division of lot 25 into 3rds of Wilmar
Grove Beach located in Section 18, T4 N R16 E, Walworth County, Wis.
Aug 2, 1951
Lloyd S. Jensen JCB
County Surveyor

2522

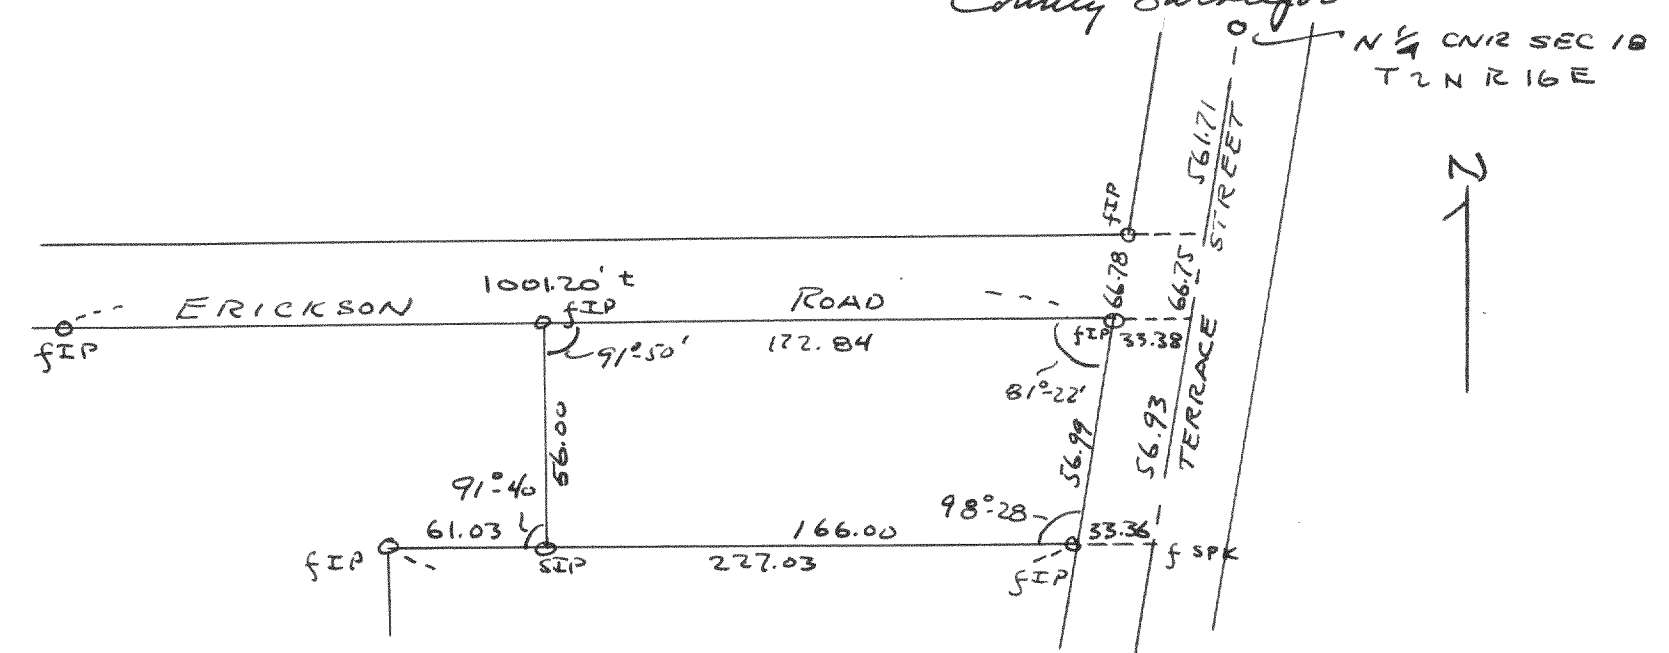

Plat of survey of Marino House located in NW 1/4 of Section 18, T2 N
R16 E, City of Delavan, Walworth County, Wisconsin
Dec. 29, 1951
Lloyd S. Jensen JCB
County Surveyor