



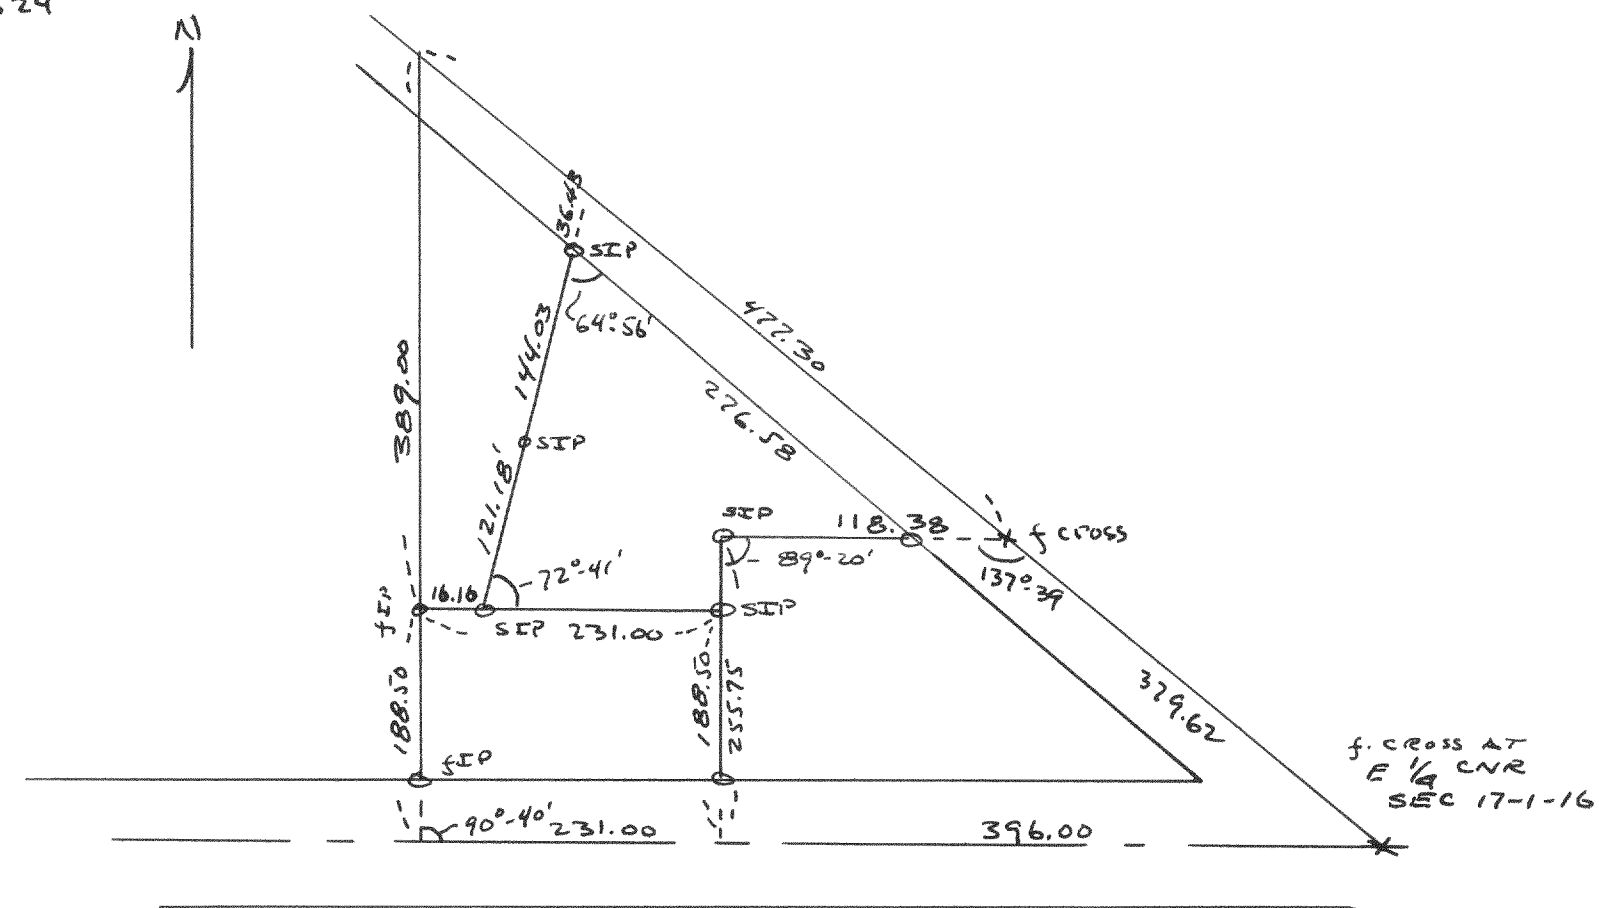

Plat of survey of land south of Globe Marine Co. located in
NW 1/4 Section 6, T1N R1E, Walworth County, Wisconsin
Dec. 28, 1951 Lloyd L. Jensen JEB
County Surveyor



Plate of description of Rented property located in the SE 1/4
of Section 23, T2N R16E of Walworth County, Wisconsin
1951
Lloyd S. Jensen S-C-B
County Surveyor

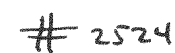

Plat of survey of land at Six Corners Northwest of
Walworth located in Section 17, T14N R16E, Walworth County, Wis.
1951 Lloyd L. Jensen JCS
County Surveyor

2526 Plat of Grinke Estates in Section 10, T14N R17E, W4000th
County, Wisconsin - See recorded plat on file in the
Register of Deeds Office at the County Court House
1951 Lloyd L. Jensen JCB
County Surveyor