



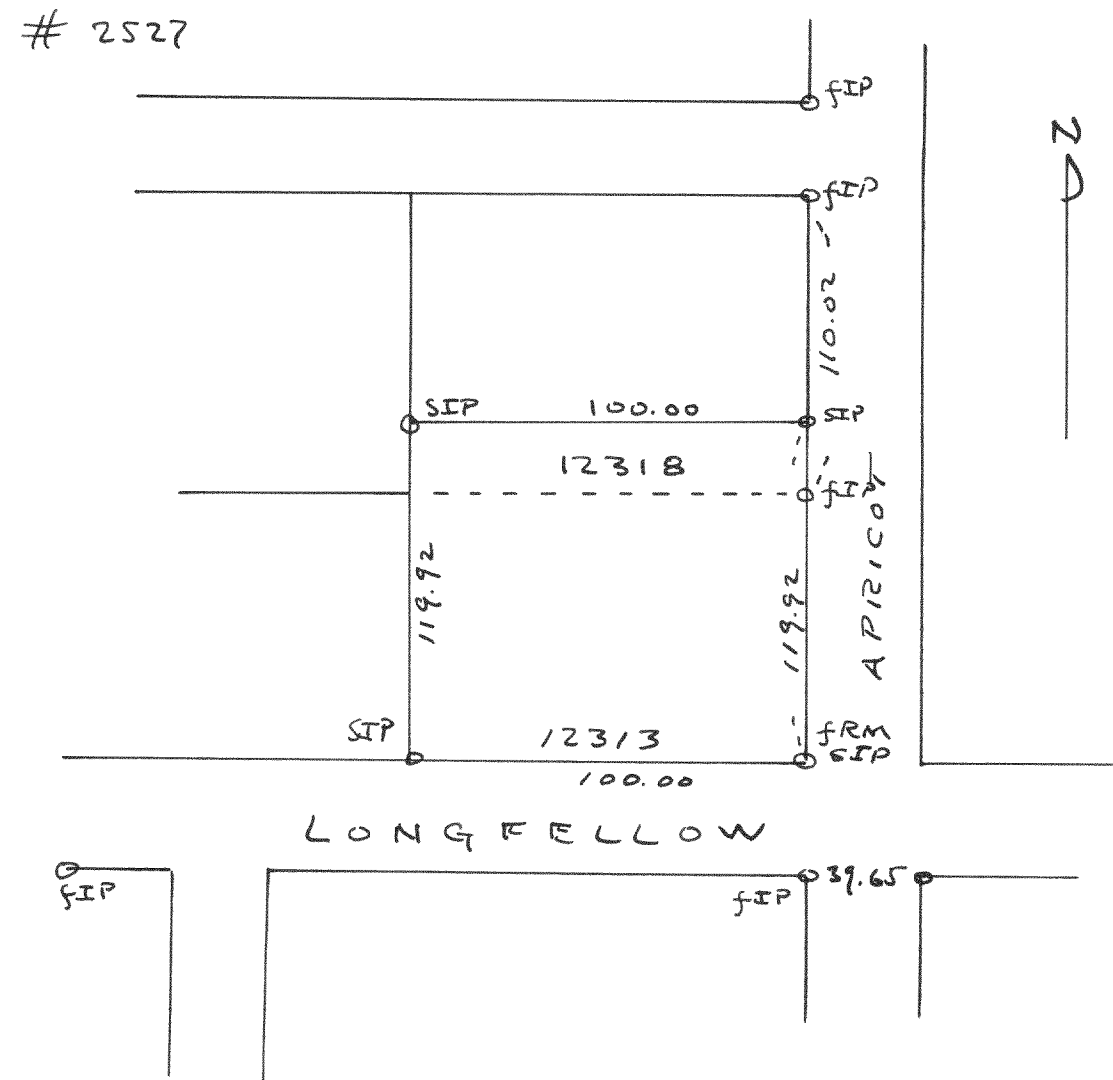

Plat of survey of lots 12313-12318 Lake Como Beach Subdivision, T2N R17E, Walworth County, Wisconsin
April 20, 1951
Floyd L. Jensen JCB
County Surveyor

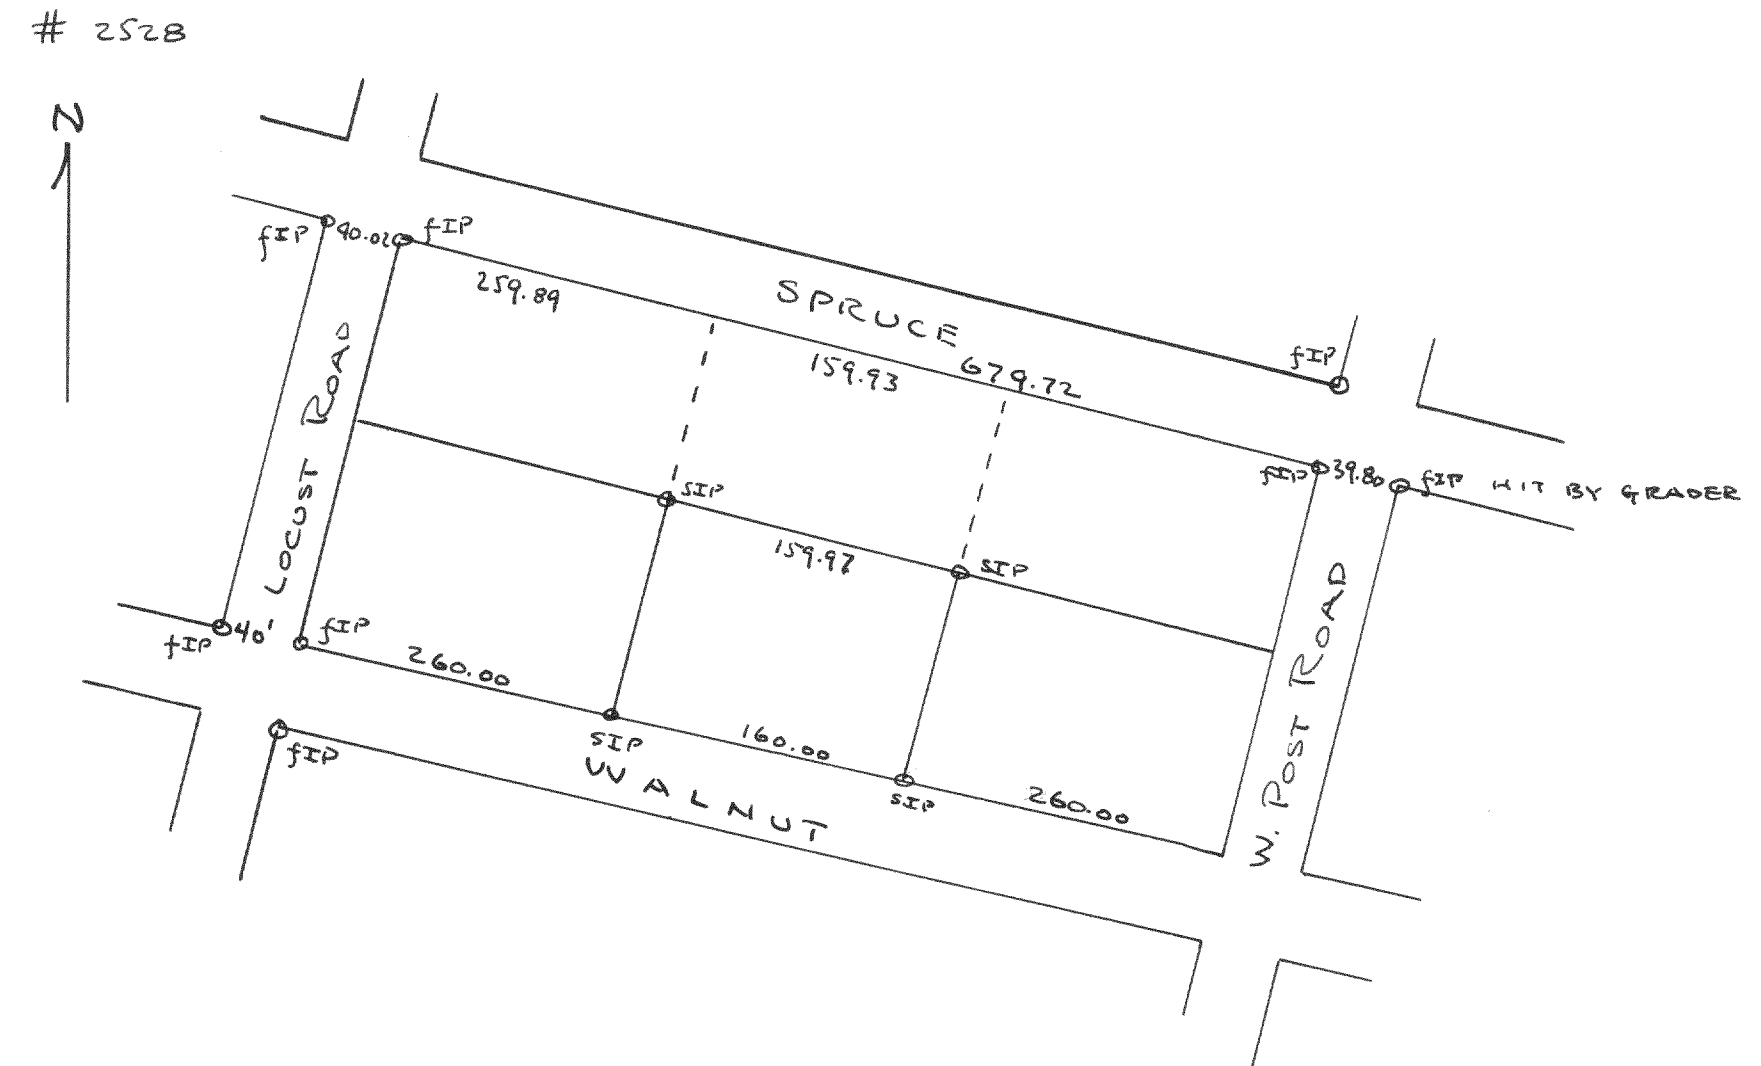

Plat of survey of lots 561-568 Pelee Lake Subdivision T1N R18E, Walworth County, Wisconsin
Sept 18, 1951
Floyd L. Jensen JCB
County Surveyor

2529 Plat of Oak Shores Subdivision in Section 18, T1N R17E Walworth County, Wisconsin - See recorded plat on file in the Register of Deeds Office at the County Court House
1951
Floyd L. Jensen JCB
County Surveyor

2530 Plat of survey of Mippersink Highlands located in Section 24, T1N R18E, Walworth County, Wisconsin - See recorded plat on file in Register of Deeds Office at the County Court House
1951
Floyd L. Jensen JCB
County Surveyor