




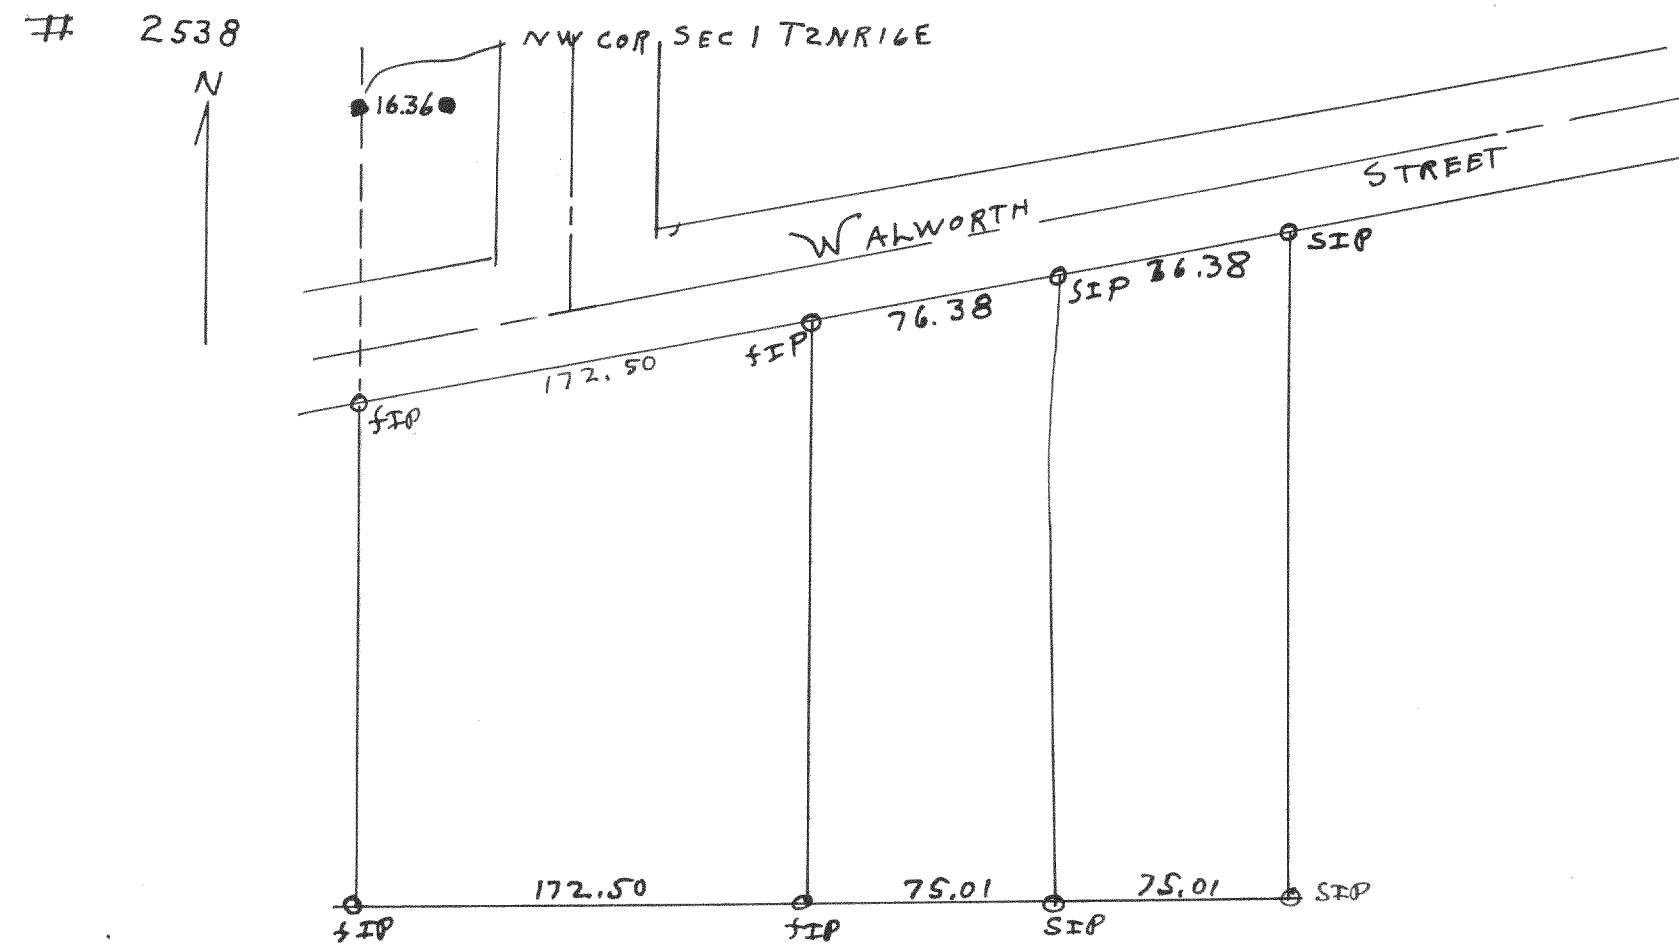


Plat of survey of Alder Lots located in the NW 1/4 of Section 1 T2N R16E Walworth County, Wisconsin July 1951
Lloyd S Jensen
County Surveyor

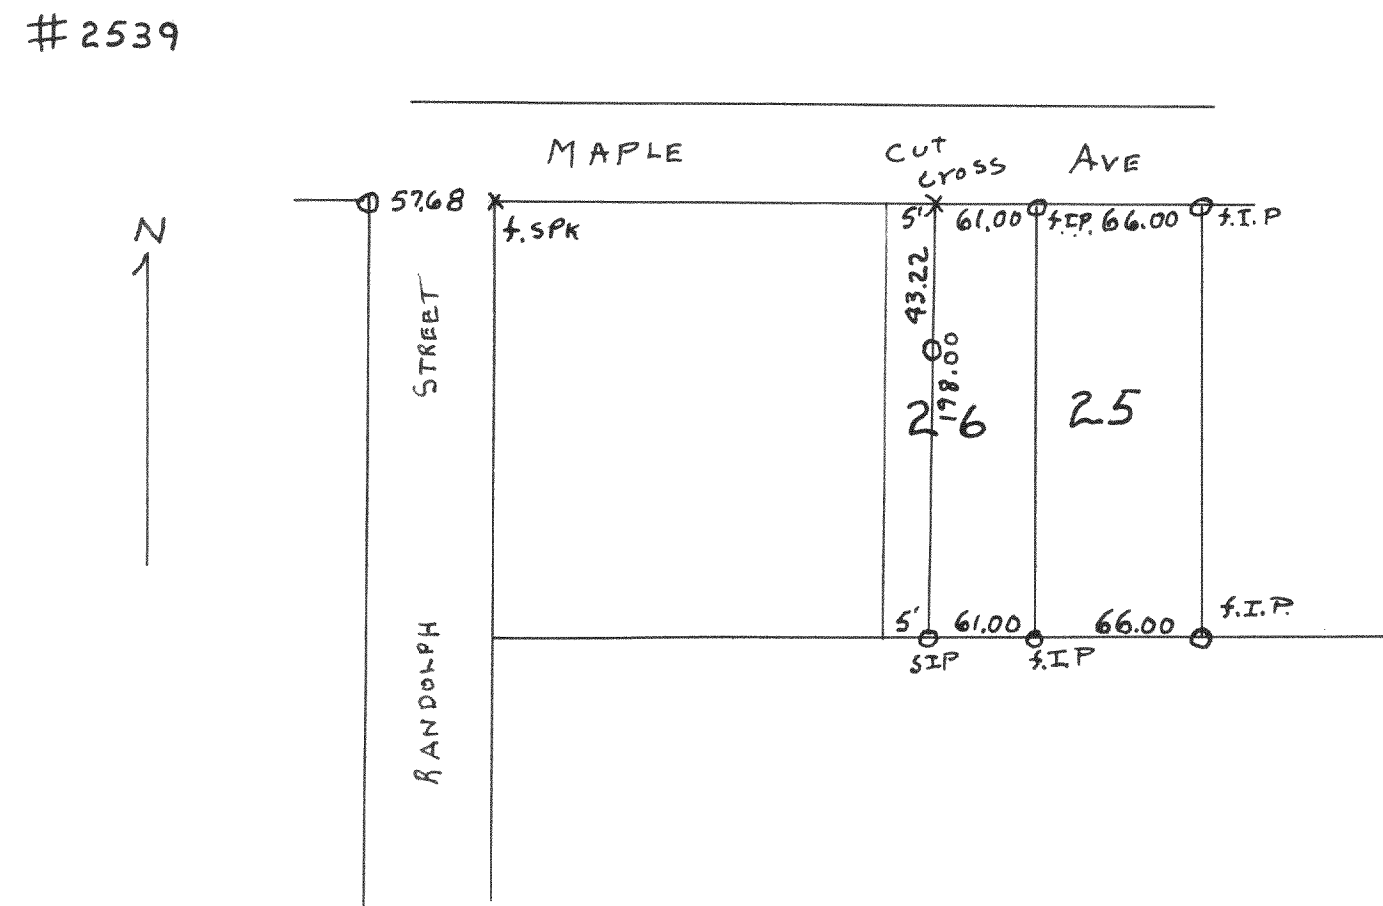

Plat of survey of part of lot 26 of Clarke's Addition located in the SE 1/4 of Section 22, T1N R16E Village of Walworth Walworth County, Wisconsin 1951
Lloyd S Jensen
County Surveyor

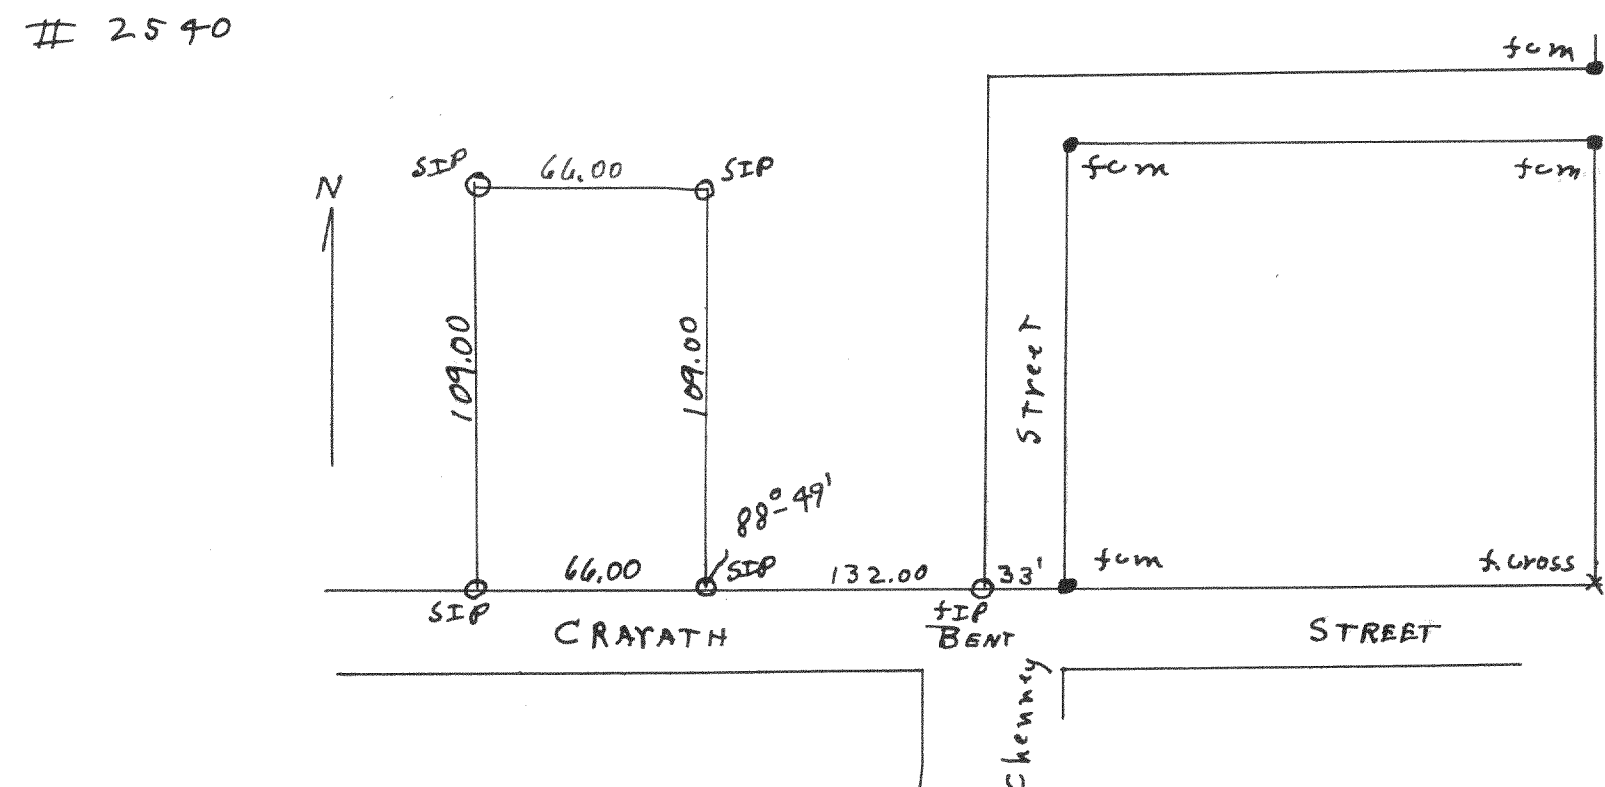

Plat of survey of land located in the NE 1/4 of Section 4 T4N R15E City of Whitewater, Walworth County, Wisconsin May 19, 1951
Lloyd S Jensen
County Surveyor

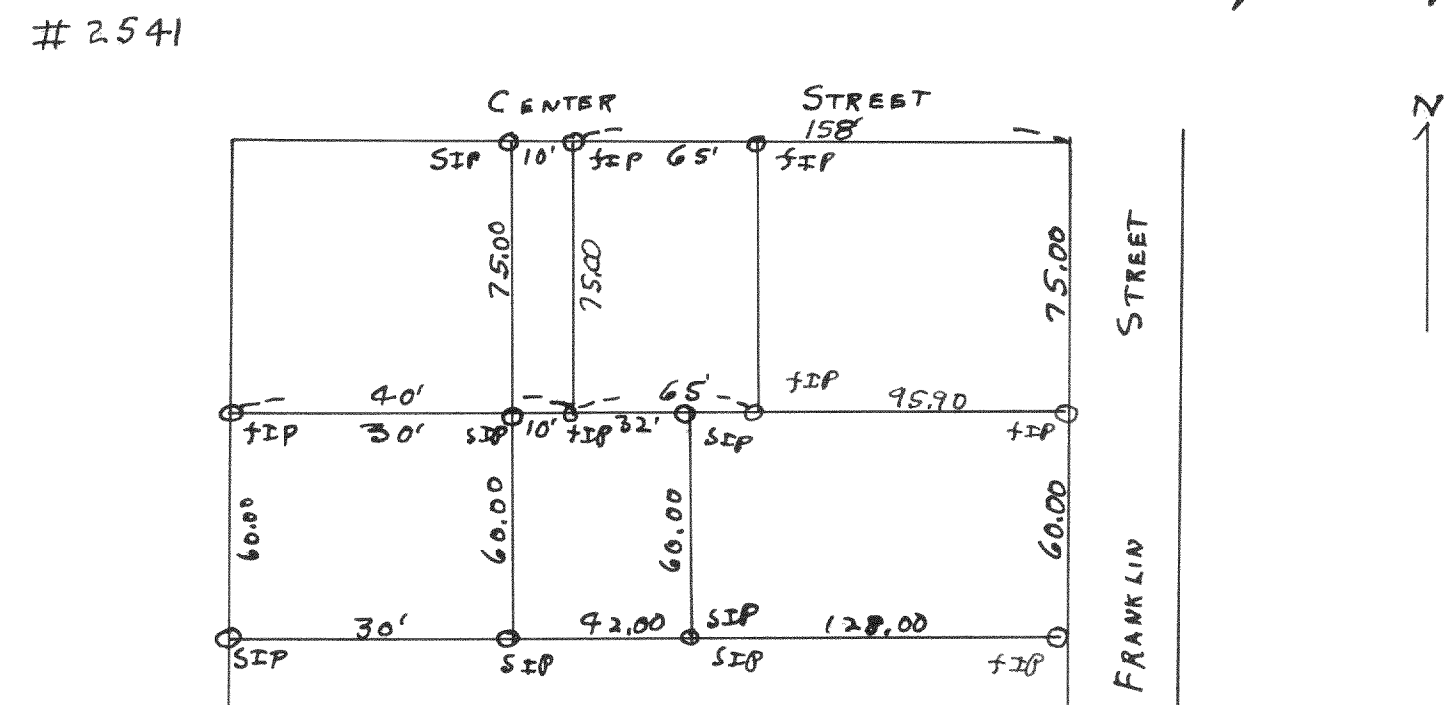

Plat of survey of Rockel land located in Block 22 of Chapman & Ludington's Addition SE 1/4 SEC 5 T4N R15E City of Whitewater, Walworth County Wisconsin 1951
Lloyd S Jensen
County Surveyor