


624

2549

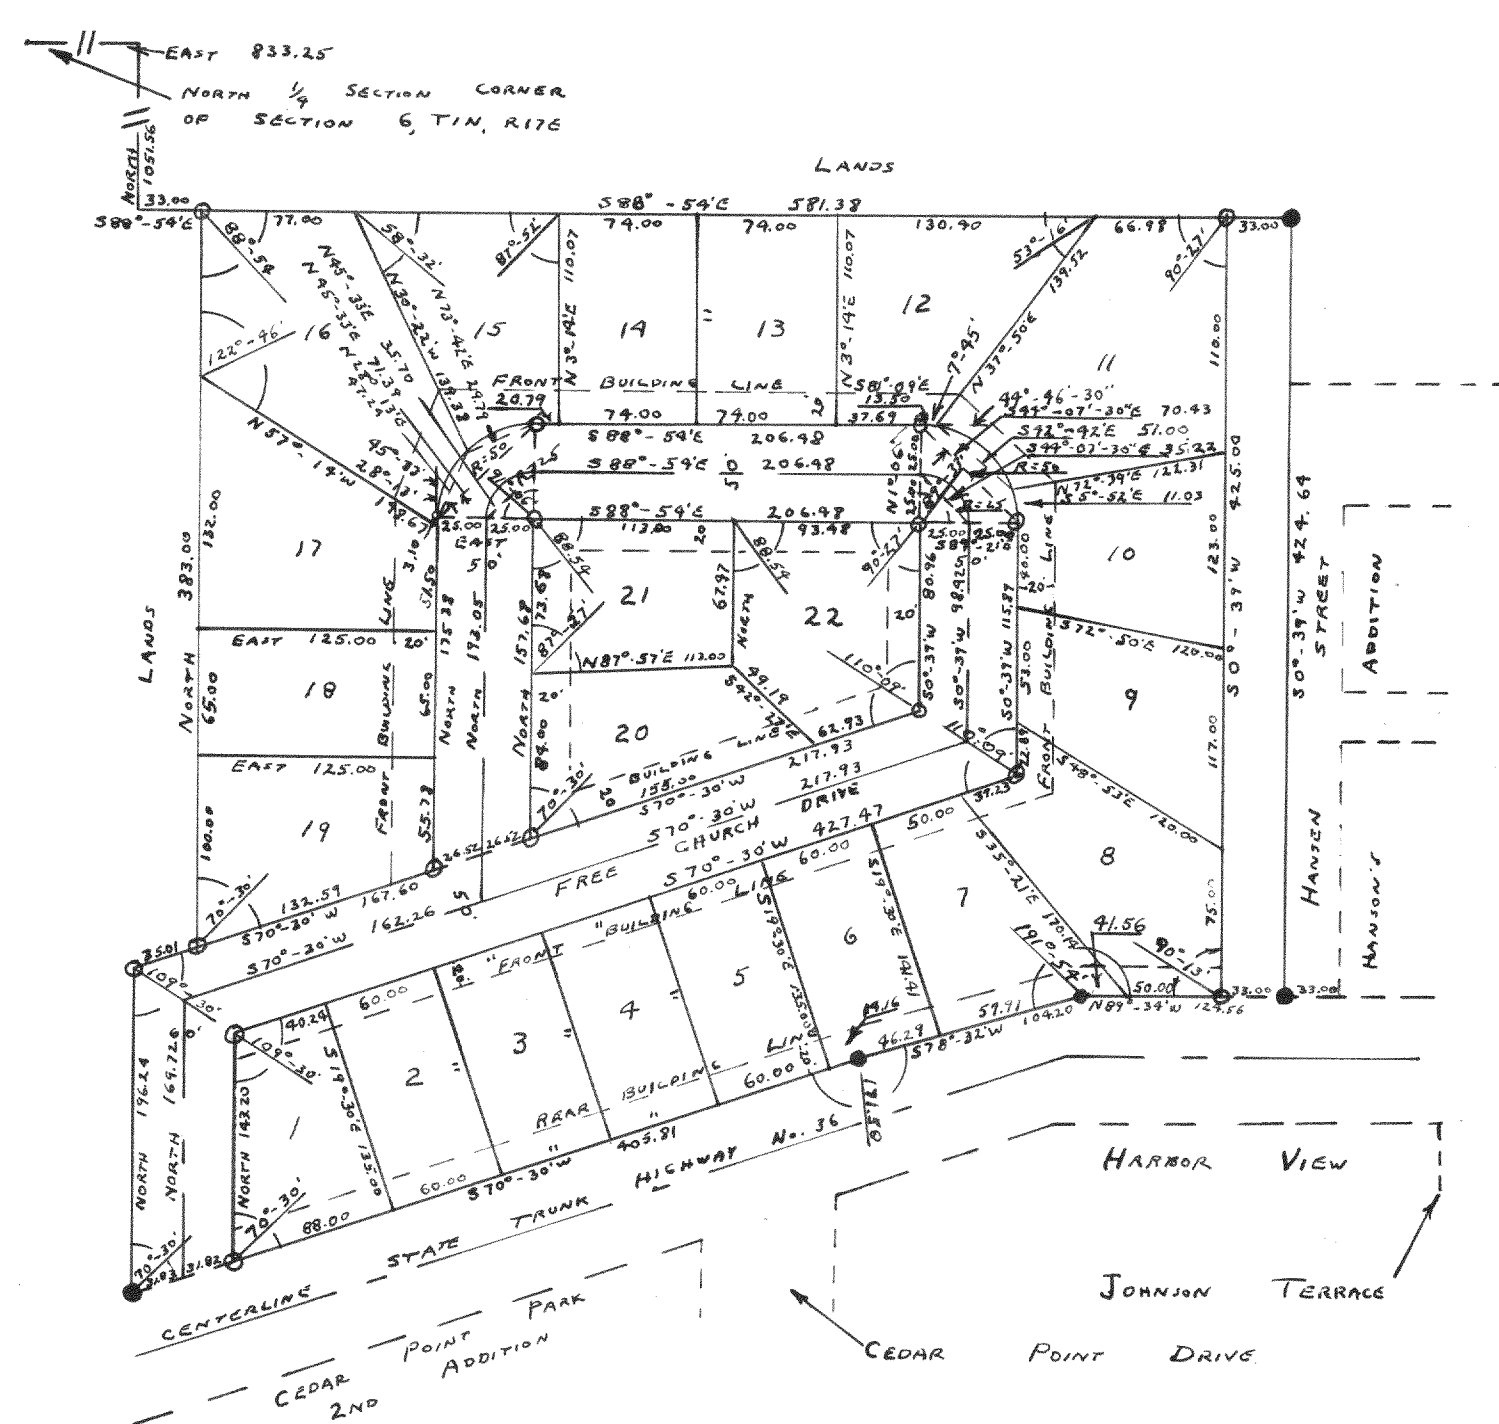


EVANGELICAL FREE CHURCH SUBDIVISION

LOCATED IN THE NE $\frac{1}{4}$ OF THE NE $\frac{1}{4}$ AND THE NW $\frac{1}{4}$ OF THE NE $\frac{1}{4}$ AND THE SW $\frac{1}{4}$ OF THE NE $\frac{1}{4}$ AND THE SE $\frac{1}{4}$ OF THE NE $\frac{1}{4}$ OF SECTION 6, T1N, R16E WALWORTH COUNTY, WISCONSIN.

AUGUST 6, 1952

Lloyd L. Jensen SA
COUNTY SURVEYOR

2550

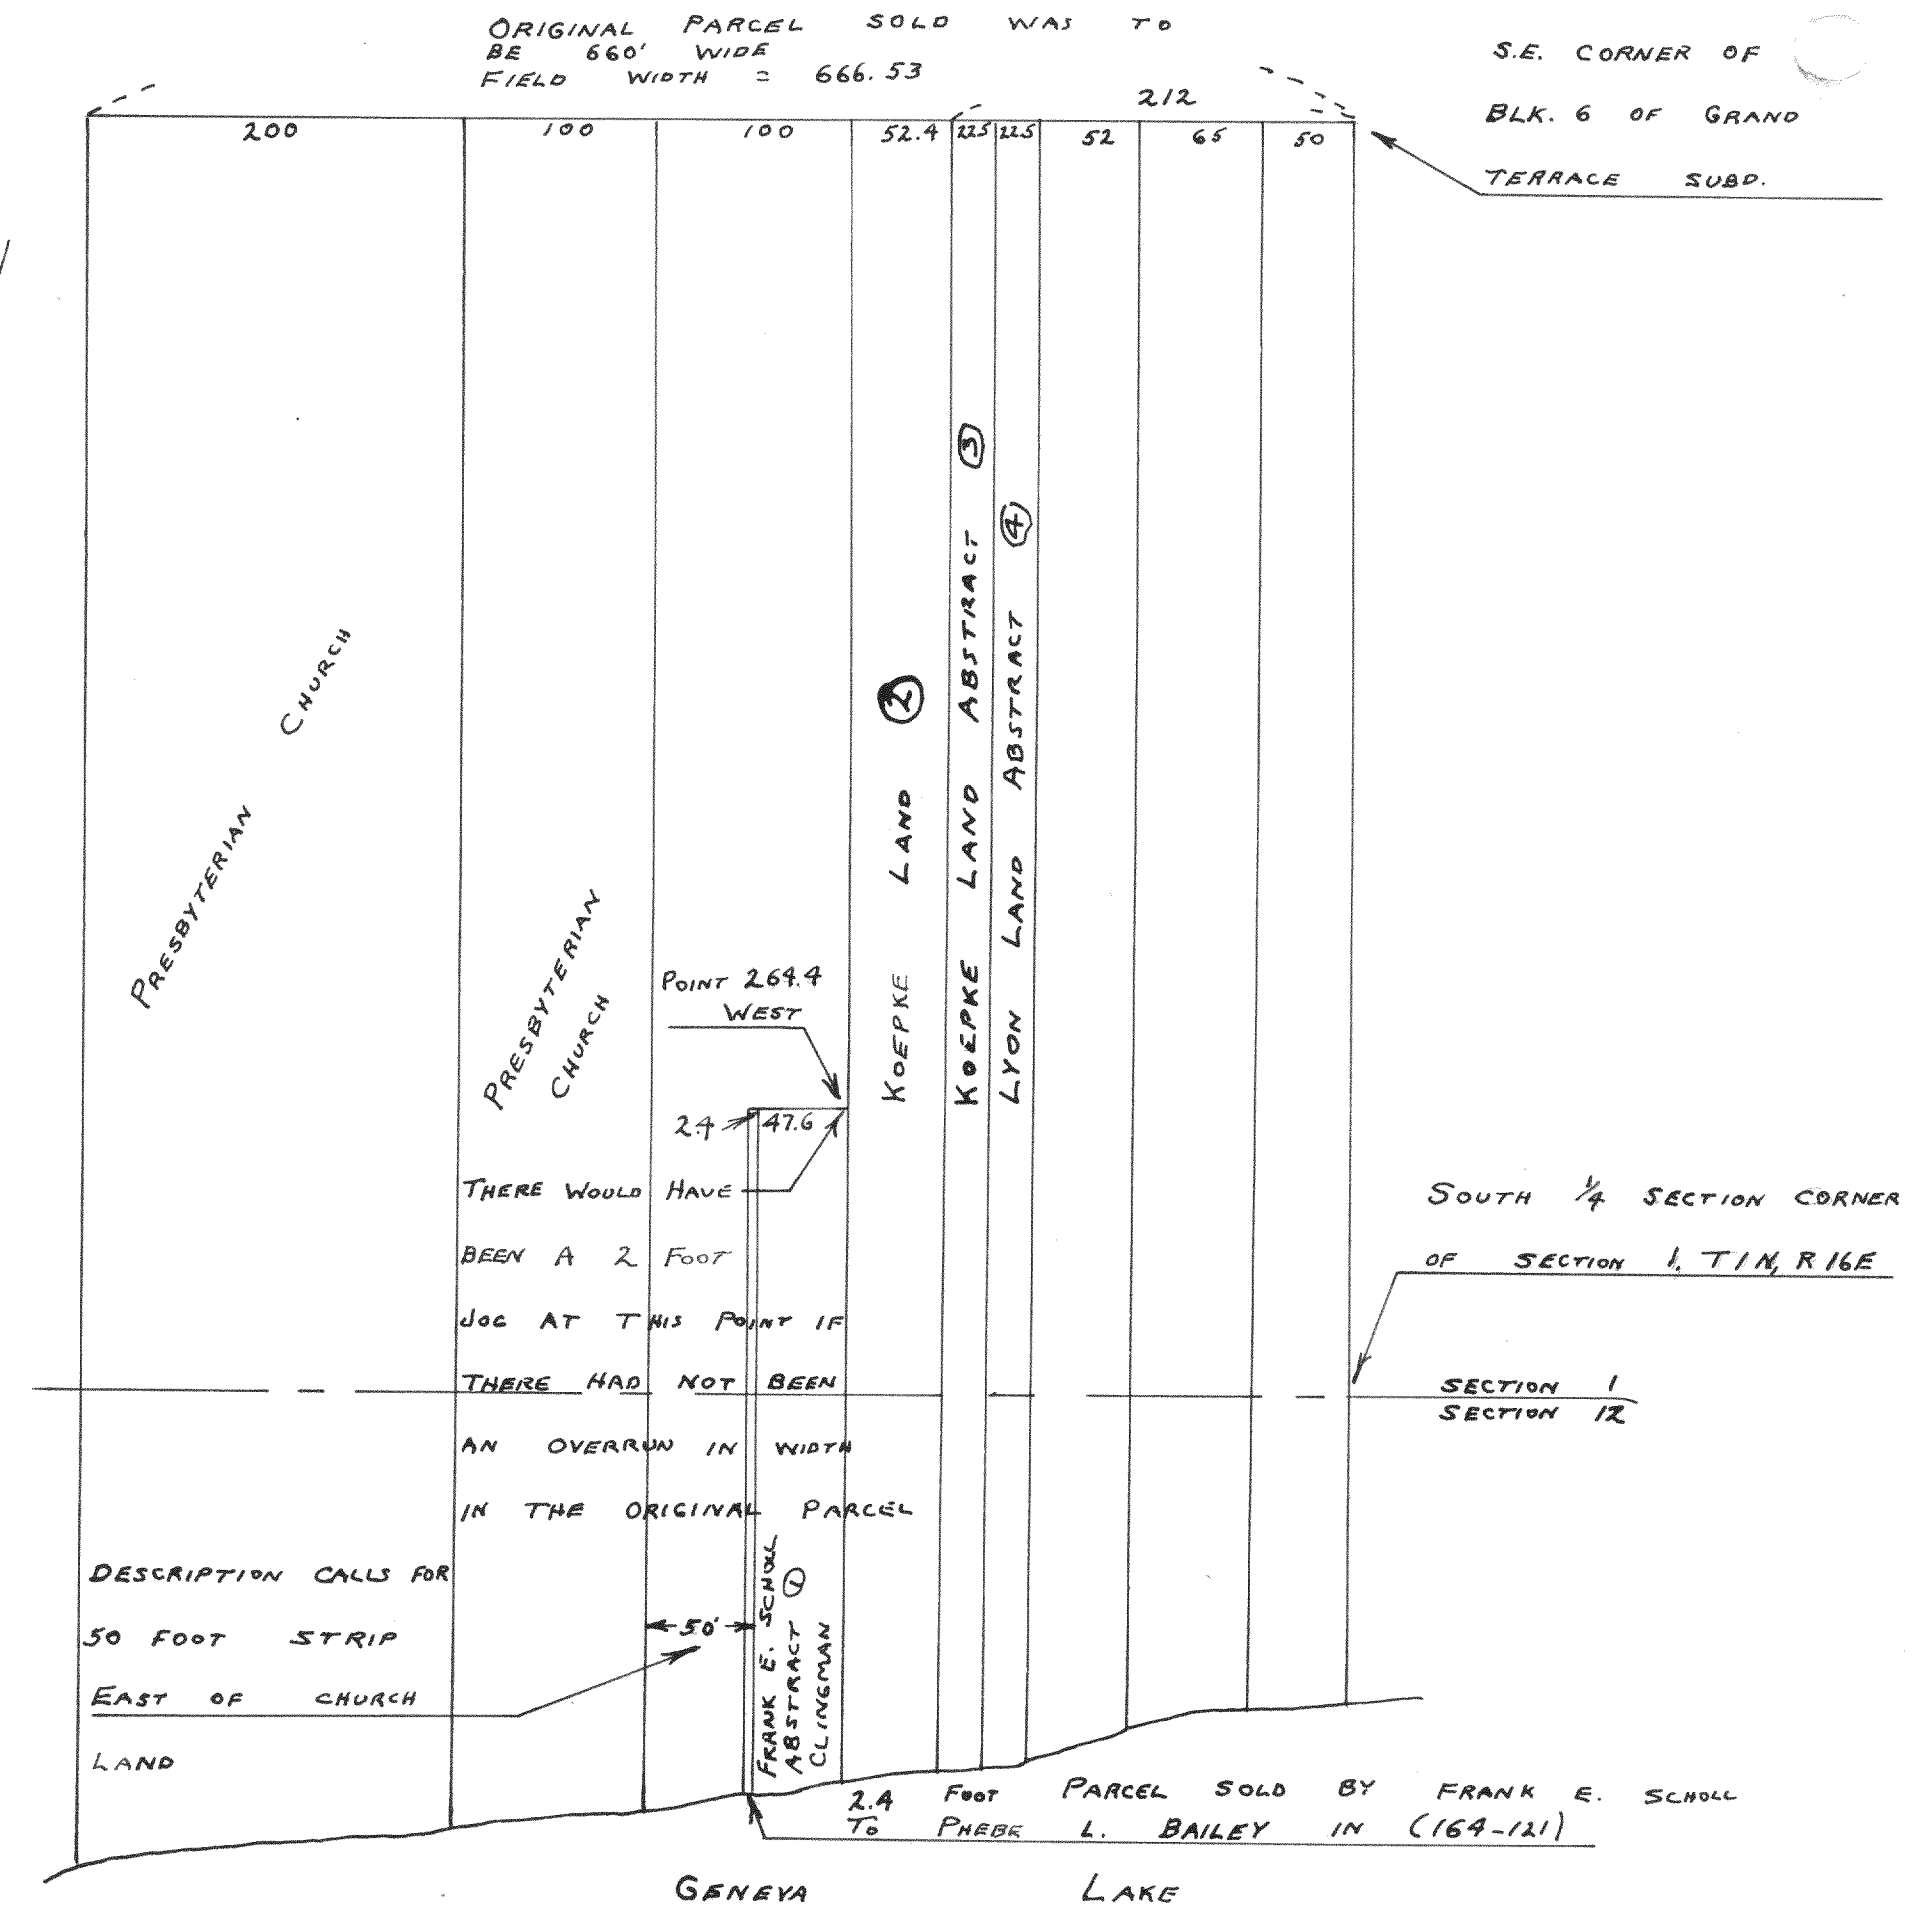

DESCRIPTION CALLS FOR
50 FOOT STRIP
EAST OF CHURCH
LAND

POINT 269.4
WEST

THERE WOULD HAVE
BEEN A 2 FOOT
JOG AT THIS POINT IF
THERE HAD NOT BEEN
AN OVERRUN IN WIDTH
IN THE ORIGINAL PARCEL

FRANK E. SCHOLL
ABSTRACT 1
CLINGMAN

2.4 FOOT PARCEL SOLD BY FRANK E. SCHOLL
TO PHEBE L. BAILEY IN (164-121)

GENEVA LAKE

PLAT OF SURVEY OF LAND LOCATED IN THE
SE $\frac{1}{4}$ OF THE SW $\frac{1}{4}$ OF SECTION 1, T1N, R16E
VILLAGE OF WILLIAMS BAY WALWORTH COUNTY,
WISCONSIN

JANUARY 18, 1952

Lloyd L. Jensen SA
COUNTY SURVEYOR