


2551

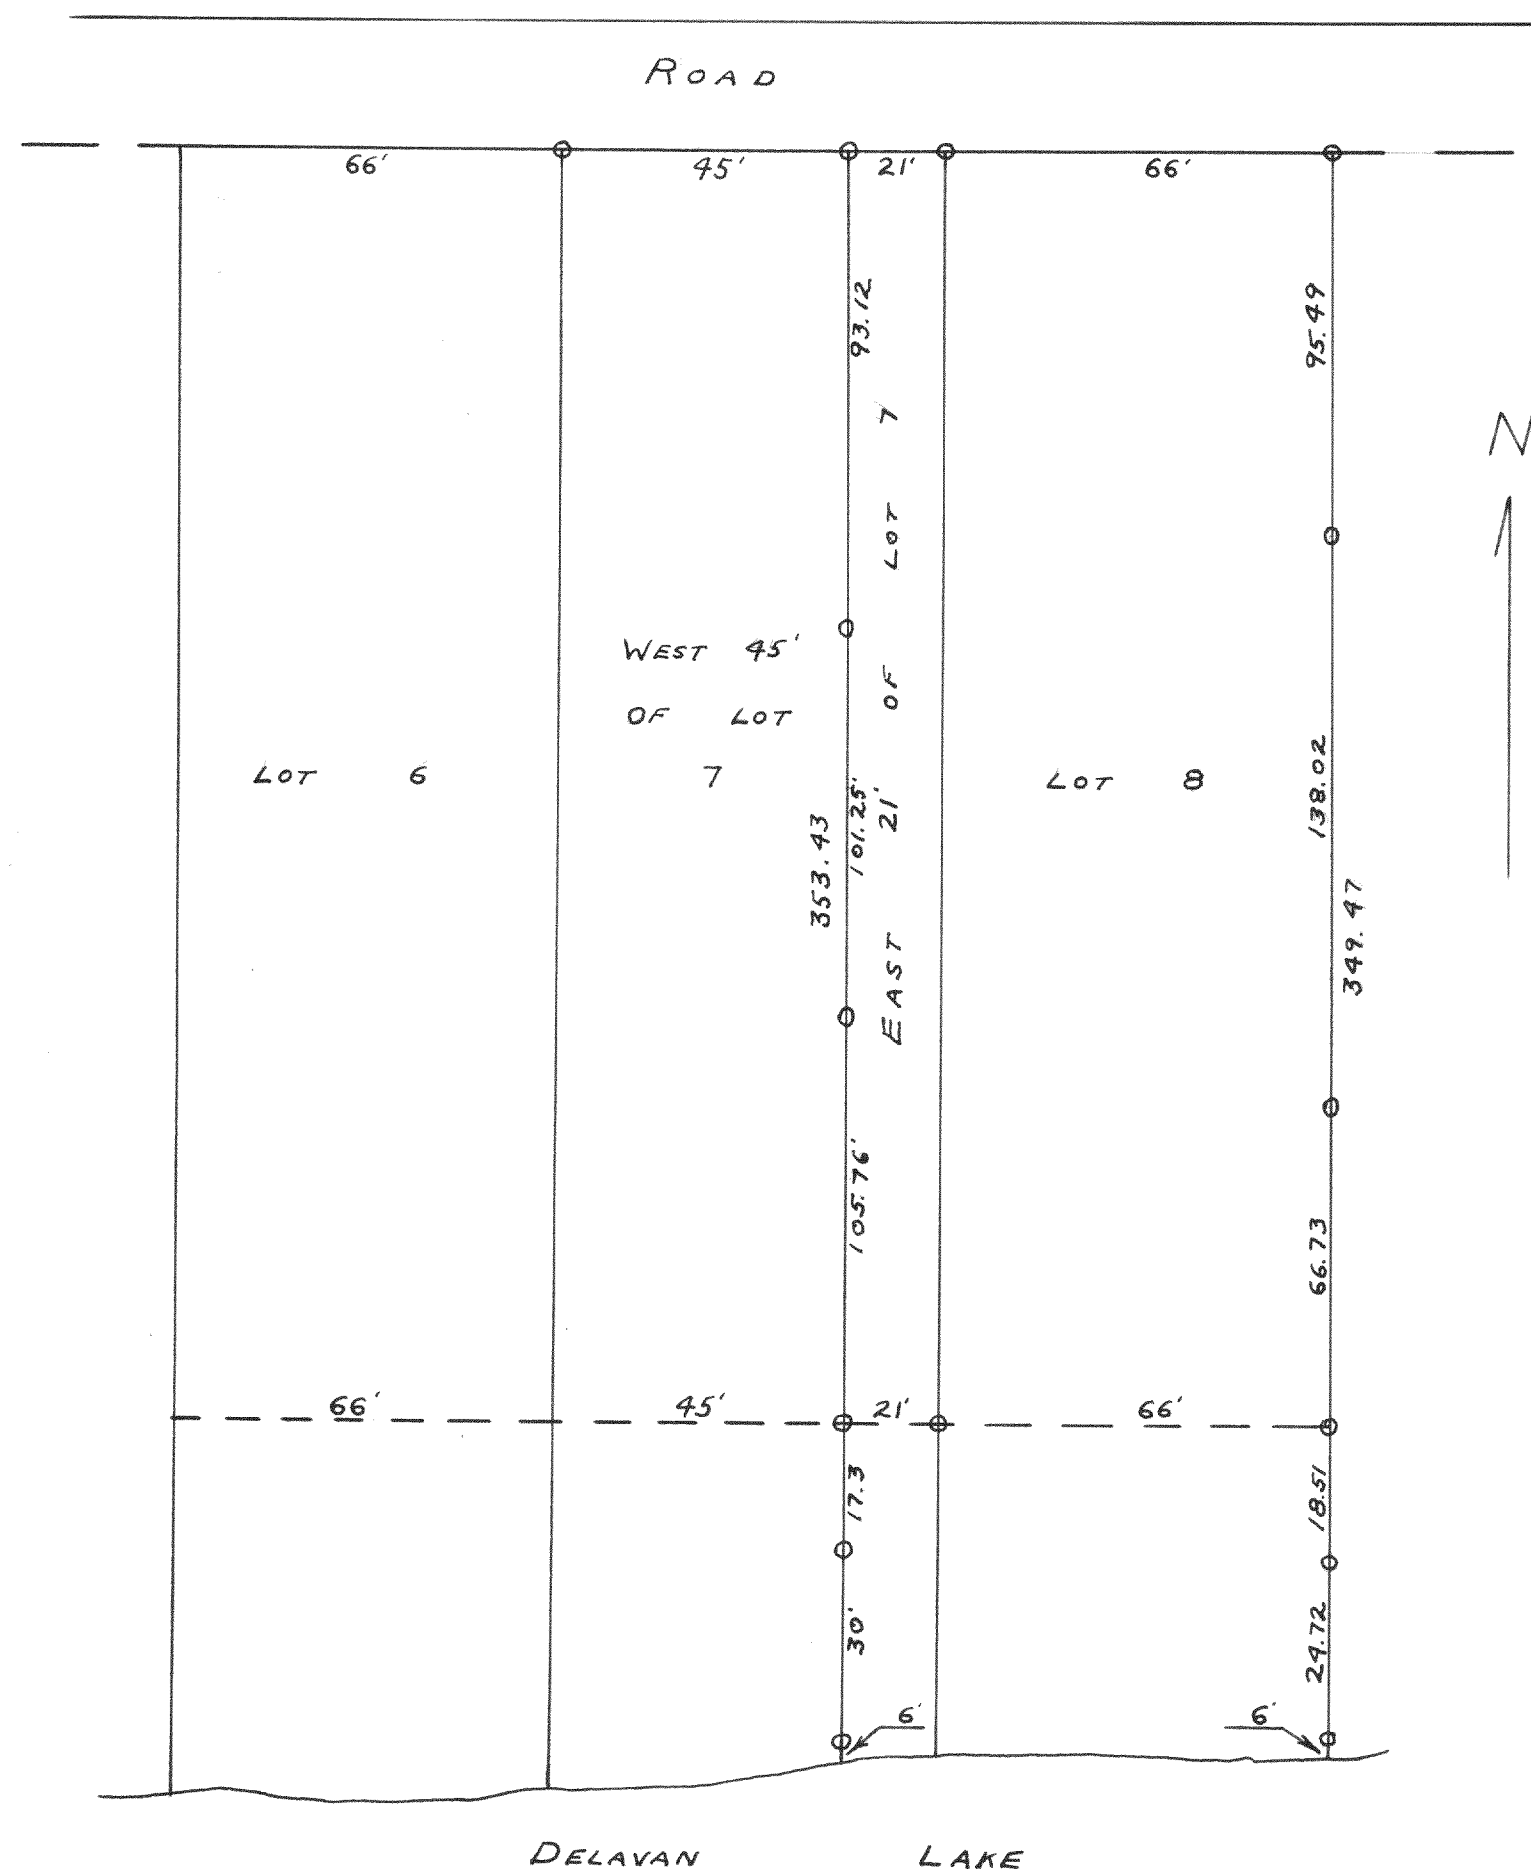


PLAT OF SURVEY OF LOT 8 AND THE EAST 21 FEET OF LOT 7, ALSO A COPY OF THE RECORDED PLAT OF THE WEST 45 FEET OF LOT 7 AND LOT 6 ALL OF CEDAR POINT SUBDIVISION, LOCATED IN SECTION 28, T2N, R16E OF WALWORTH COUNTY, WISCONSIN.

JUNE 1952

Lloyd L. Jensen SA
COUNTY SURVEYOR

2552

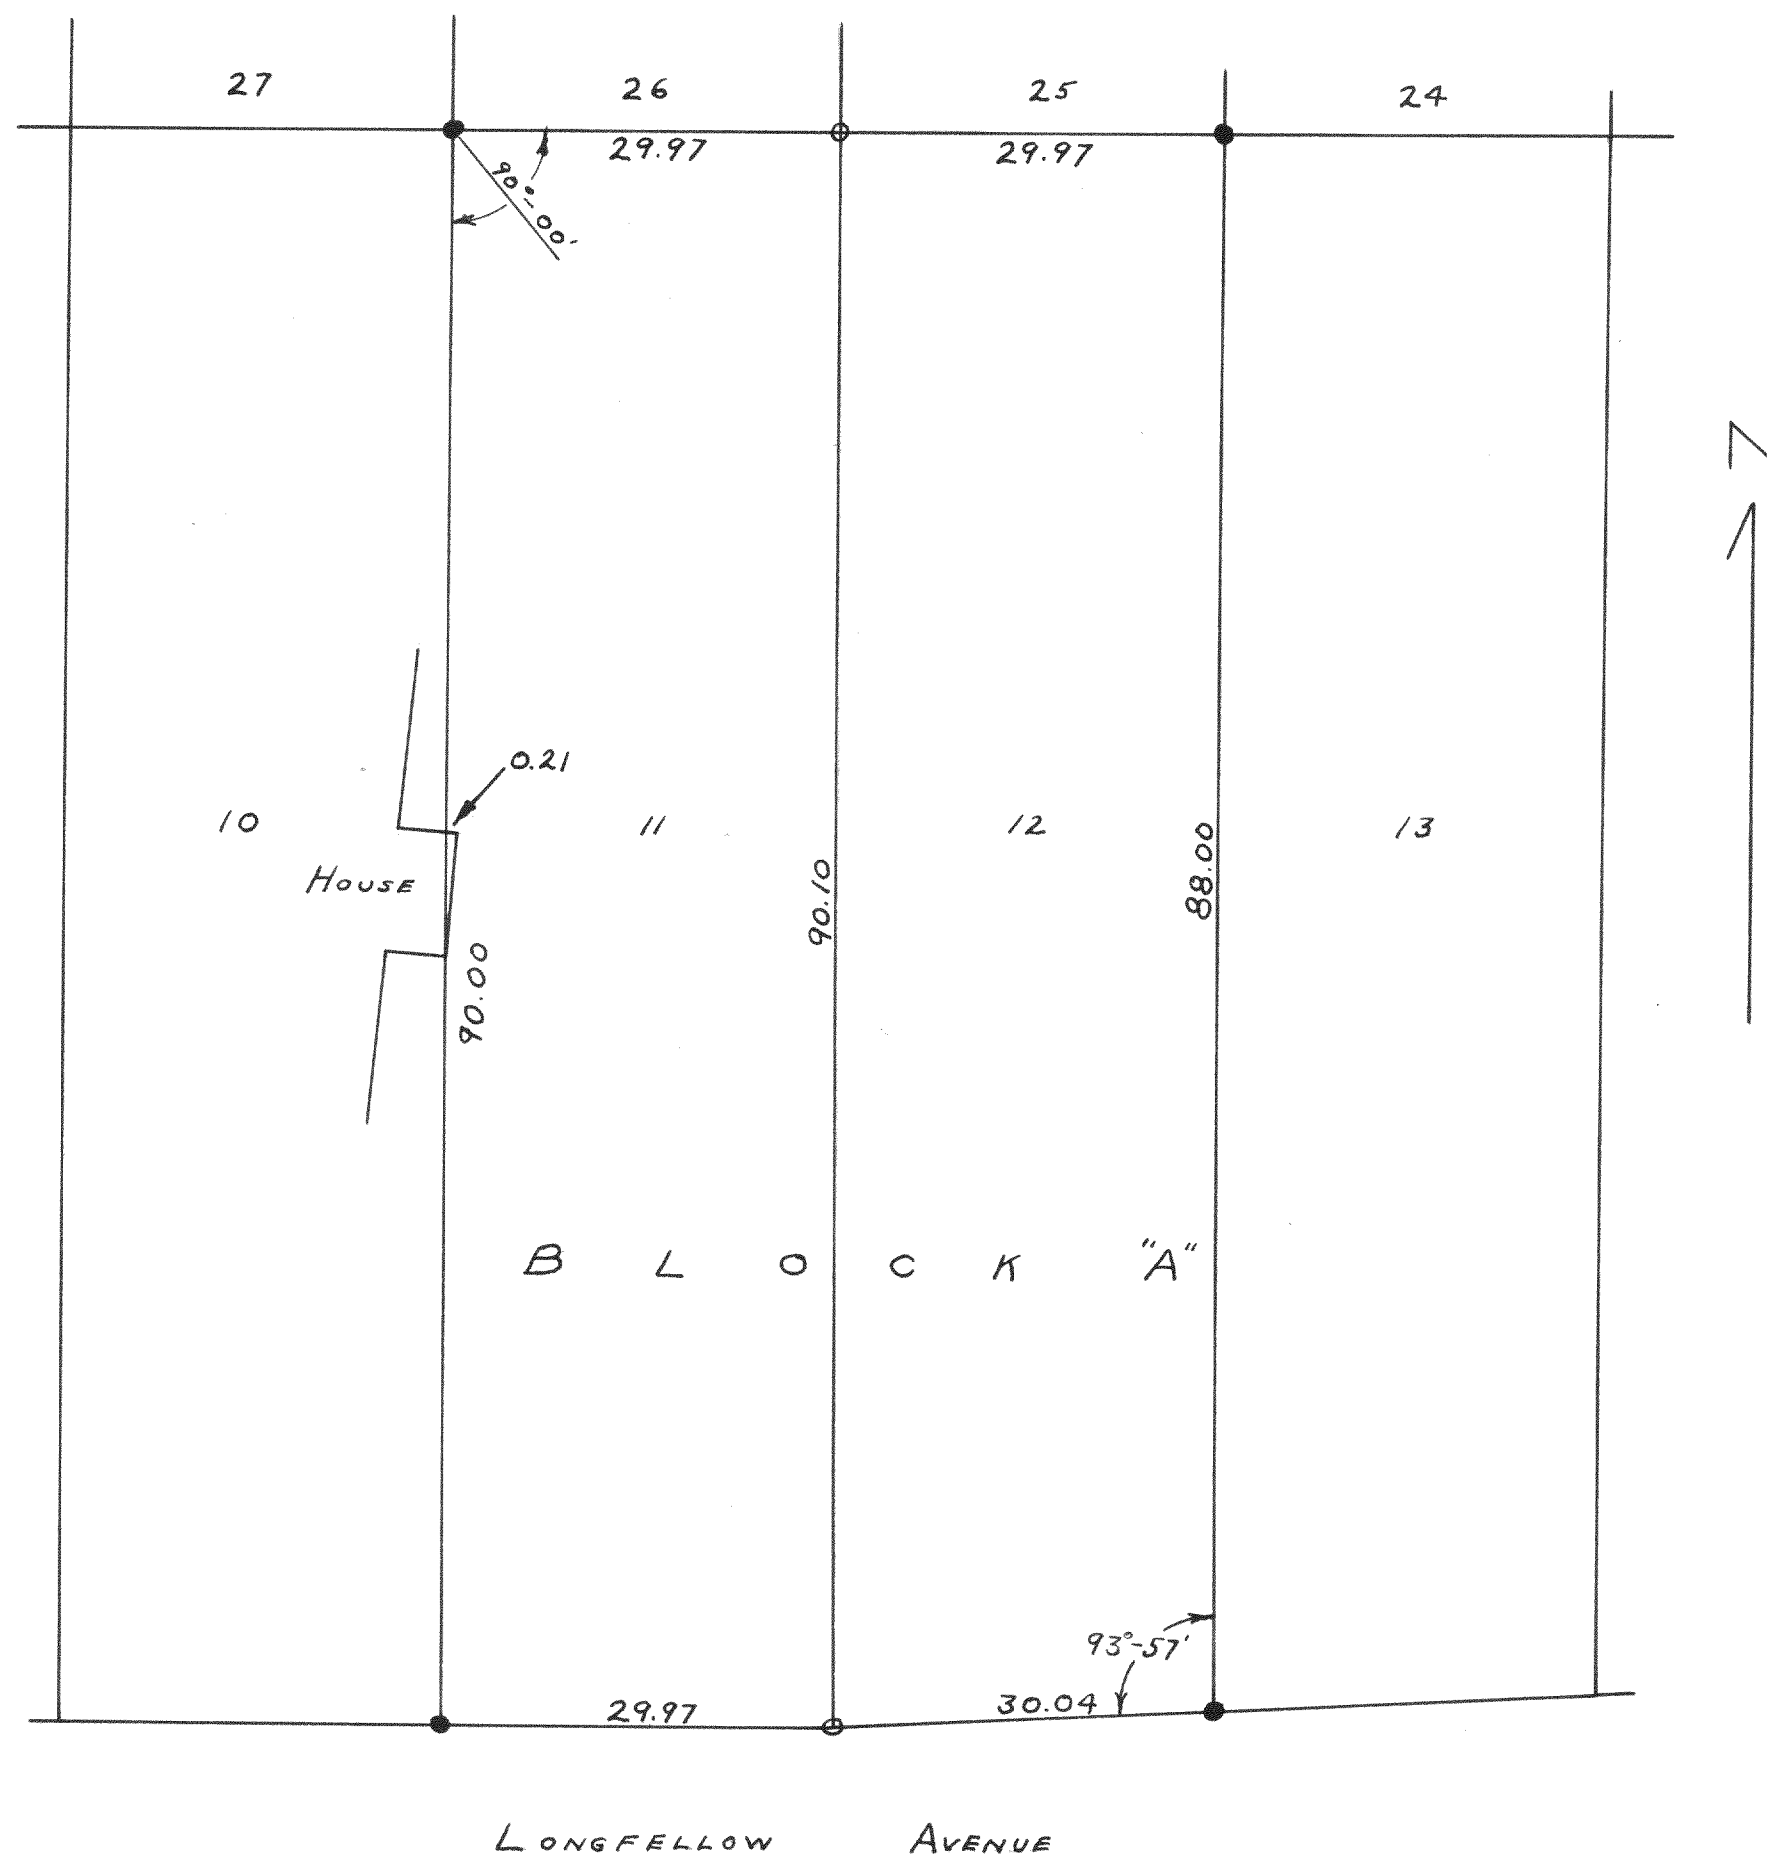

PLAT OF SURVEY OF LOTS 11 AND 12, BLOCK "A" OF DELAVAN LAKE ASSEMBLY GROUNDS SUBDIVISION, LOCATED IN SECTION 21, T2N, R16E WALWORTH COUNTY, WISCONSIN.

MAY 1952

Lloyd L. Jensen SA
COUNTY SURVEYOR