


2553

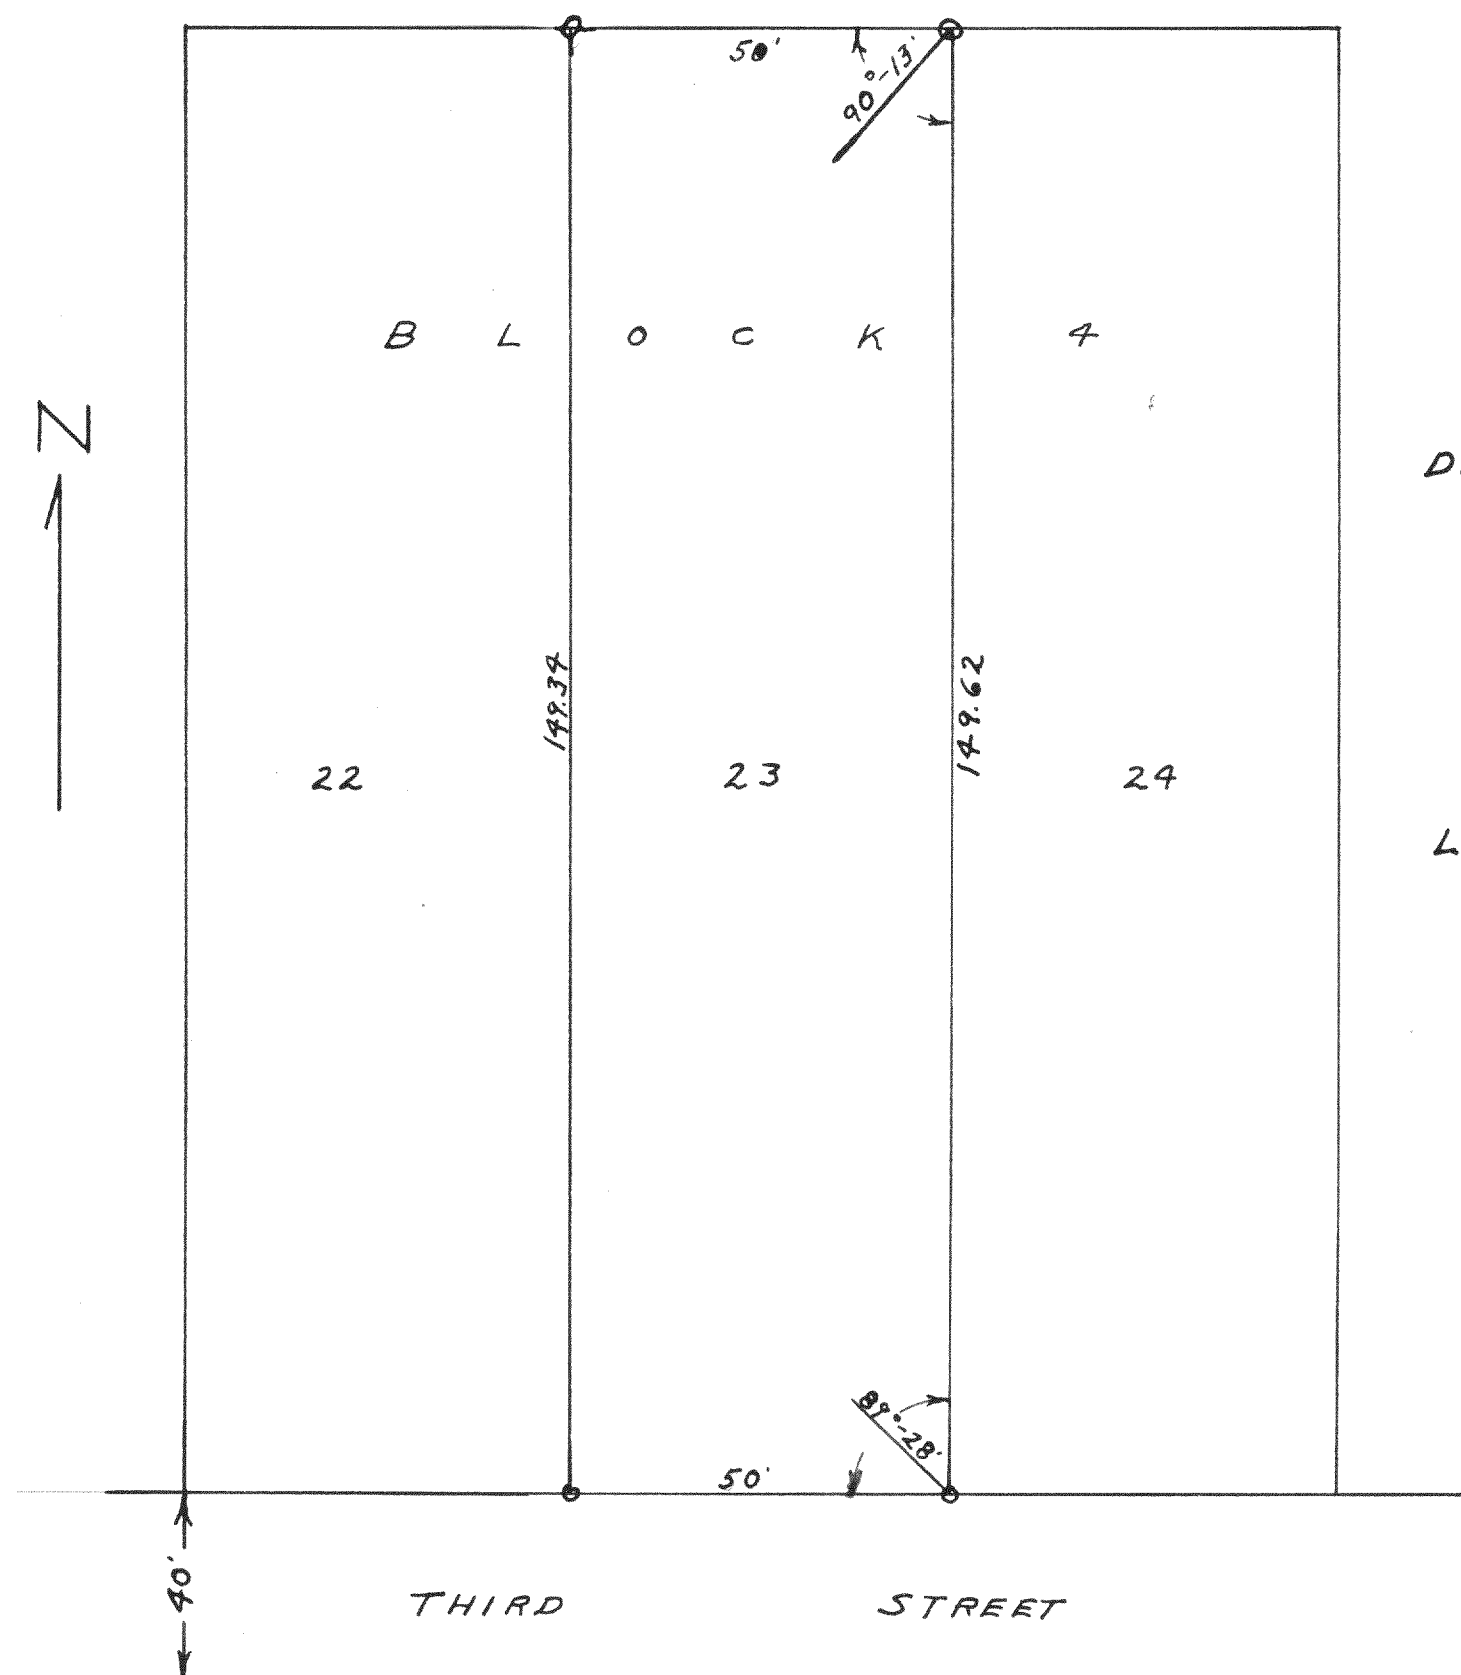


I HEREBY CERTIFY THAT THE ABOVE PLAT IS A CORRECT REPRESENTATION OF THE SURVEY OF LOT 23 OF BLOCK 4 OF INLET OAKS No. 3 OF THE TOWN OF DELAVAN, WALWORTH COUNTY, WISCONSIN AND THAT I HAVE SHOWN ALL BUILDINGS AS THEY ARE LOCATED ON THE LOT AT THIS DATE.

JULY 1952

Lloyd L. Jensen SA
COUNTY SURVEYOR

2554

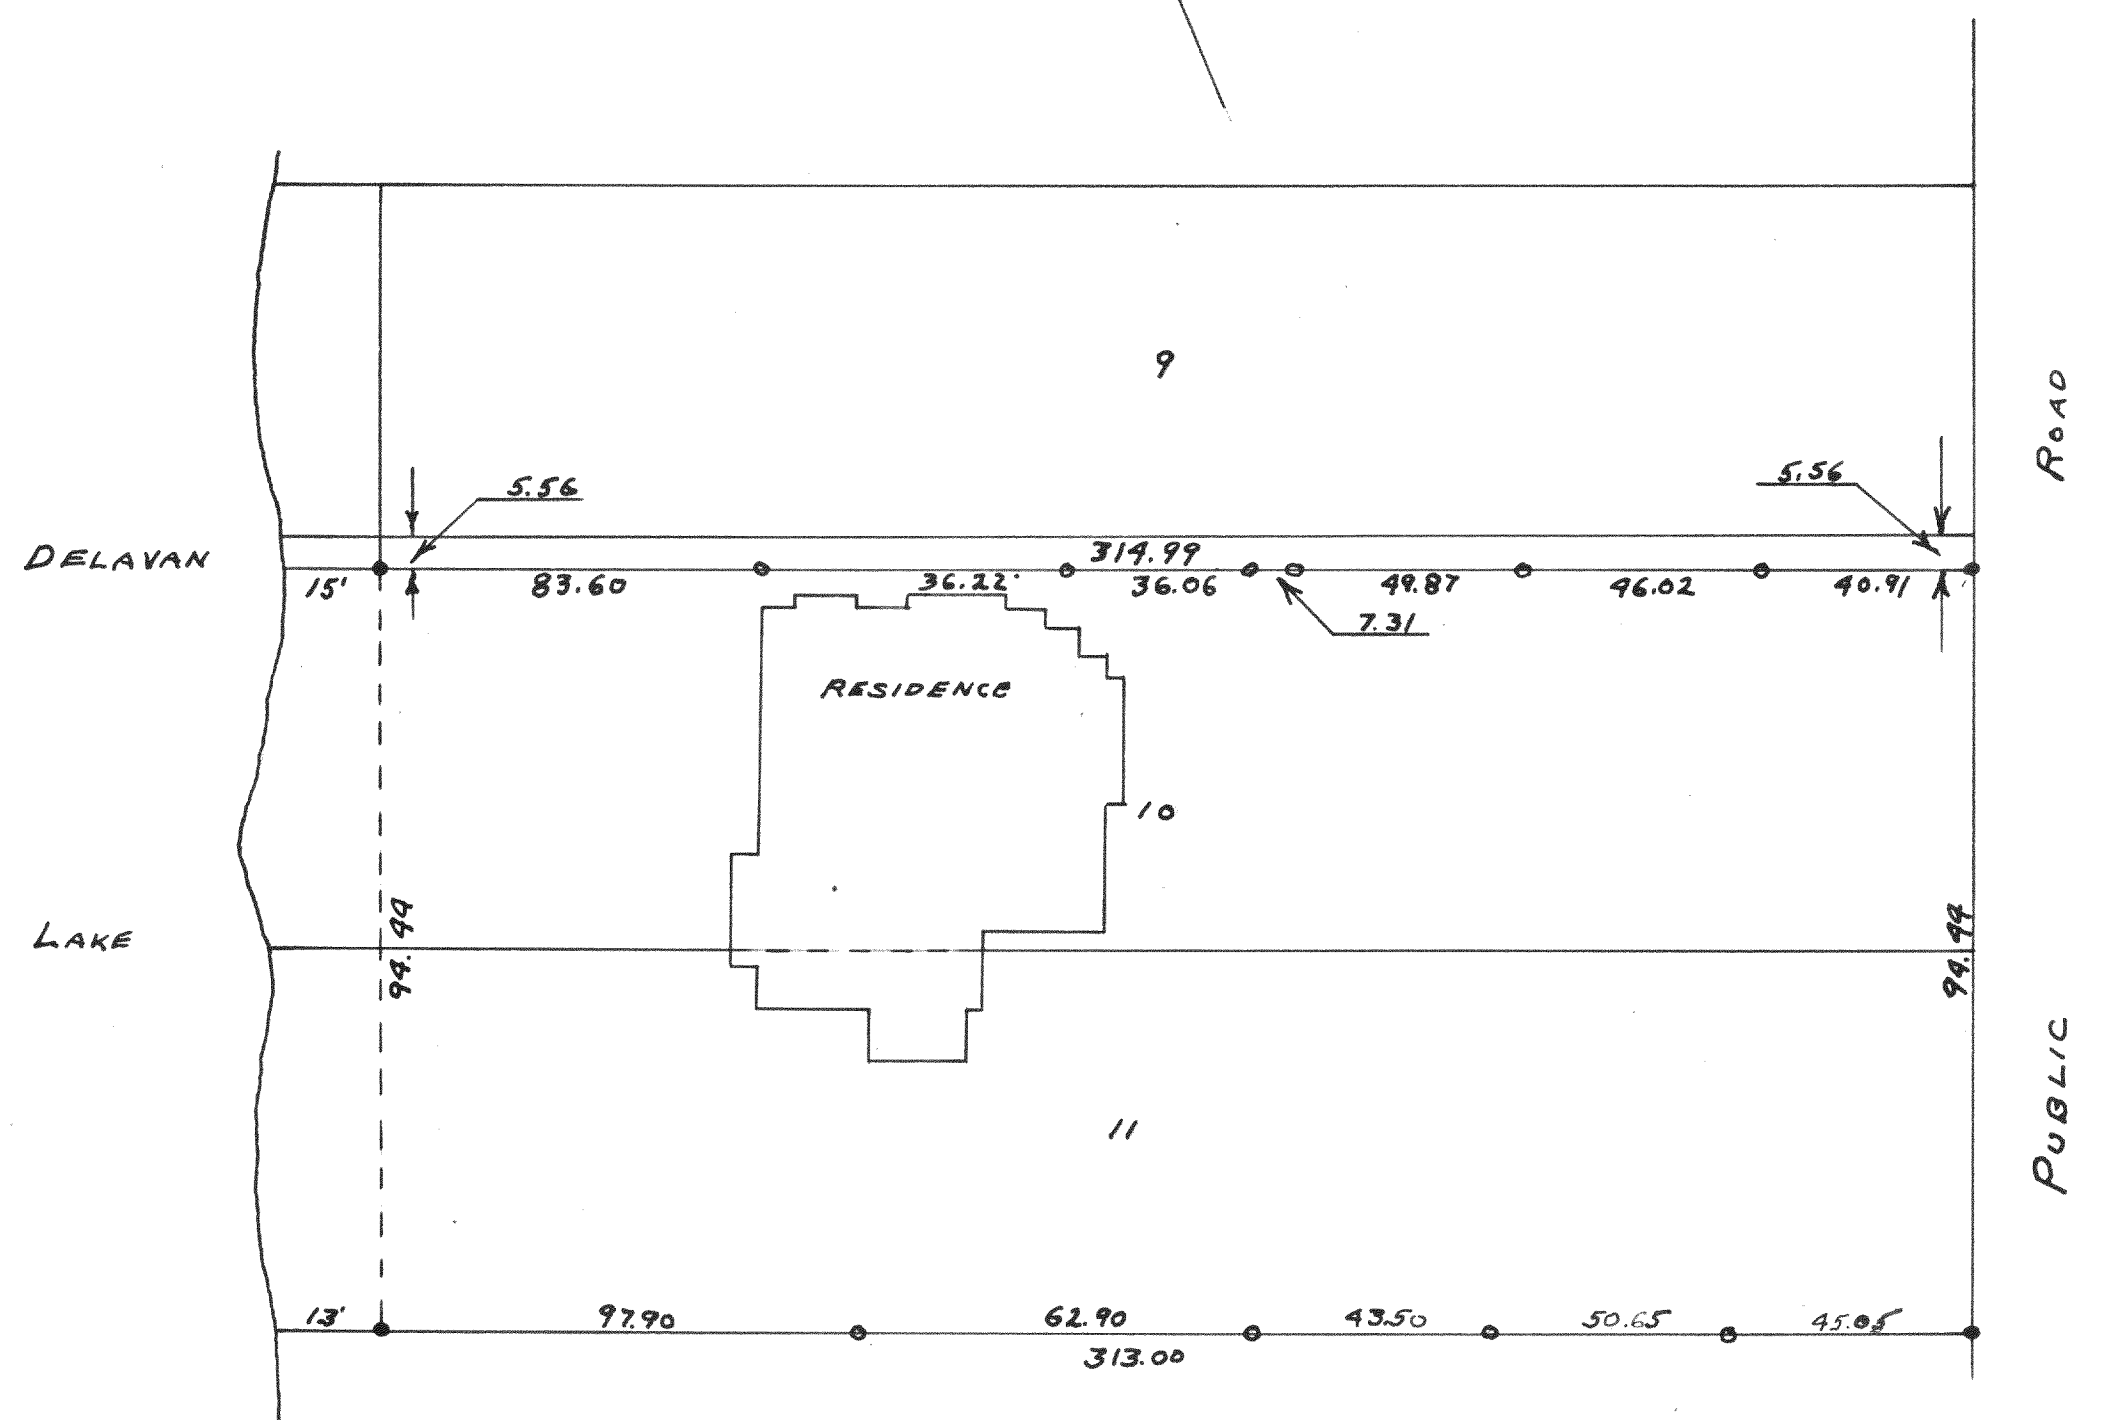

I HEREBY CERTIFY THAT I HAVE SURVEYED THE LAND SHOWN ON THIS PLAT ACCORDING TO THE OFFICIAL RECORDS, THE DESCRIPTION OF SAID LAND IS AS FOLLOWS: LOTS NUMBERED (10) AND ELEVEN (11), IN BAILEY'S SUBDIVISION OF A PART OF SECTION 27, T2N, R16E, WALWORTH COUNTY, WISCONSIN, EXCEPTING THEREFROM THE NORTHERLY 5.56 FEET OF SAID LOT 10; THAT I HAVE LOCATED ALL BUILDINGS, FENCES, AND OTHER IMPROVEMENTS THAT ARE ON THE PROPERTY AS DESCRIBED HEREINBEFORE; THAT THE PLAT SHOWN HEREON, IS A CORRECT REPRESENTATION OF THE LOT LINES AND THE PRINCIPAL LINES OF ALL BUILDINGS AND OTHER IMPROVEMENTS THEREON

JUNE 23, 1952

Lloyd L. Jensen SA
COUNTY SURVEYOR