



2557

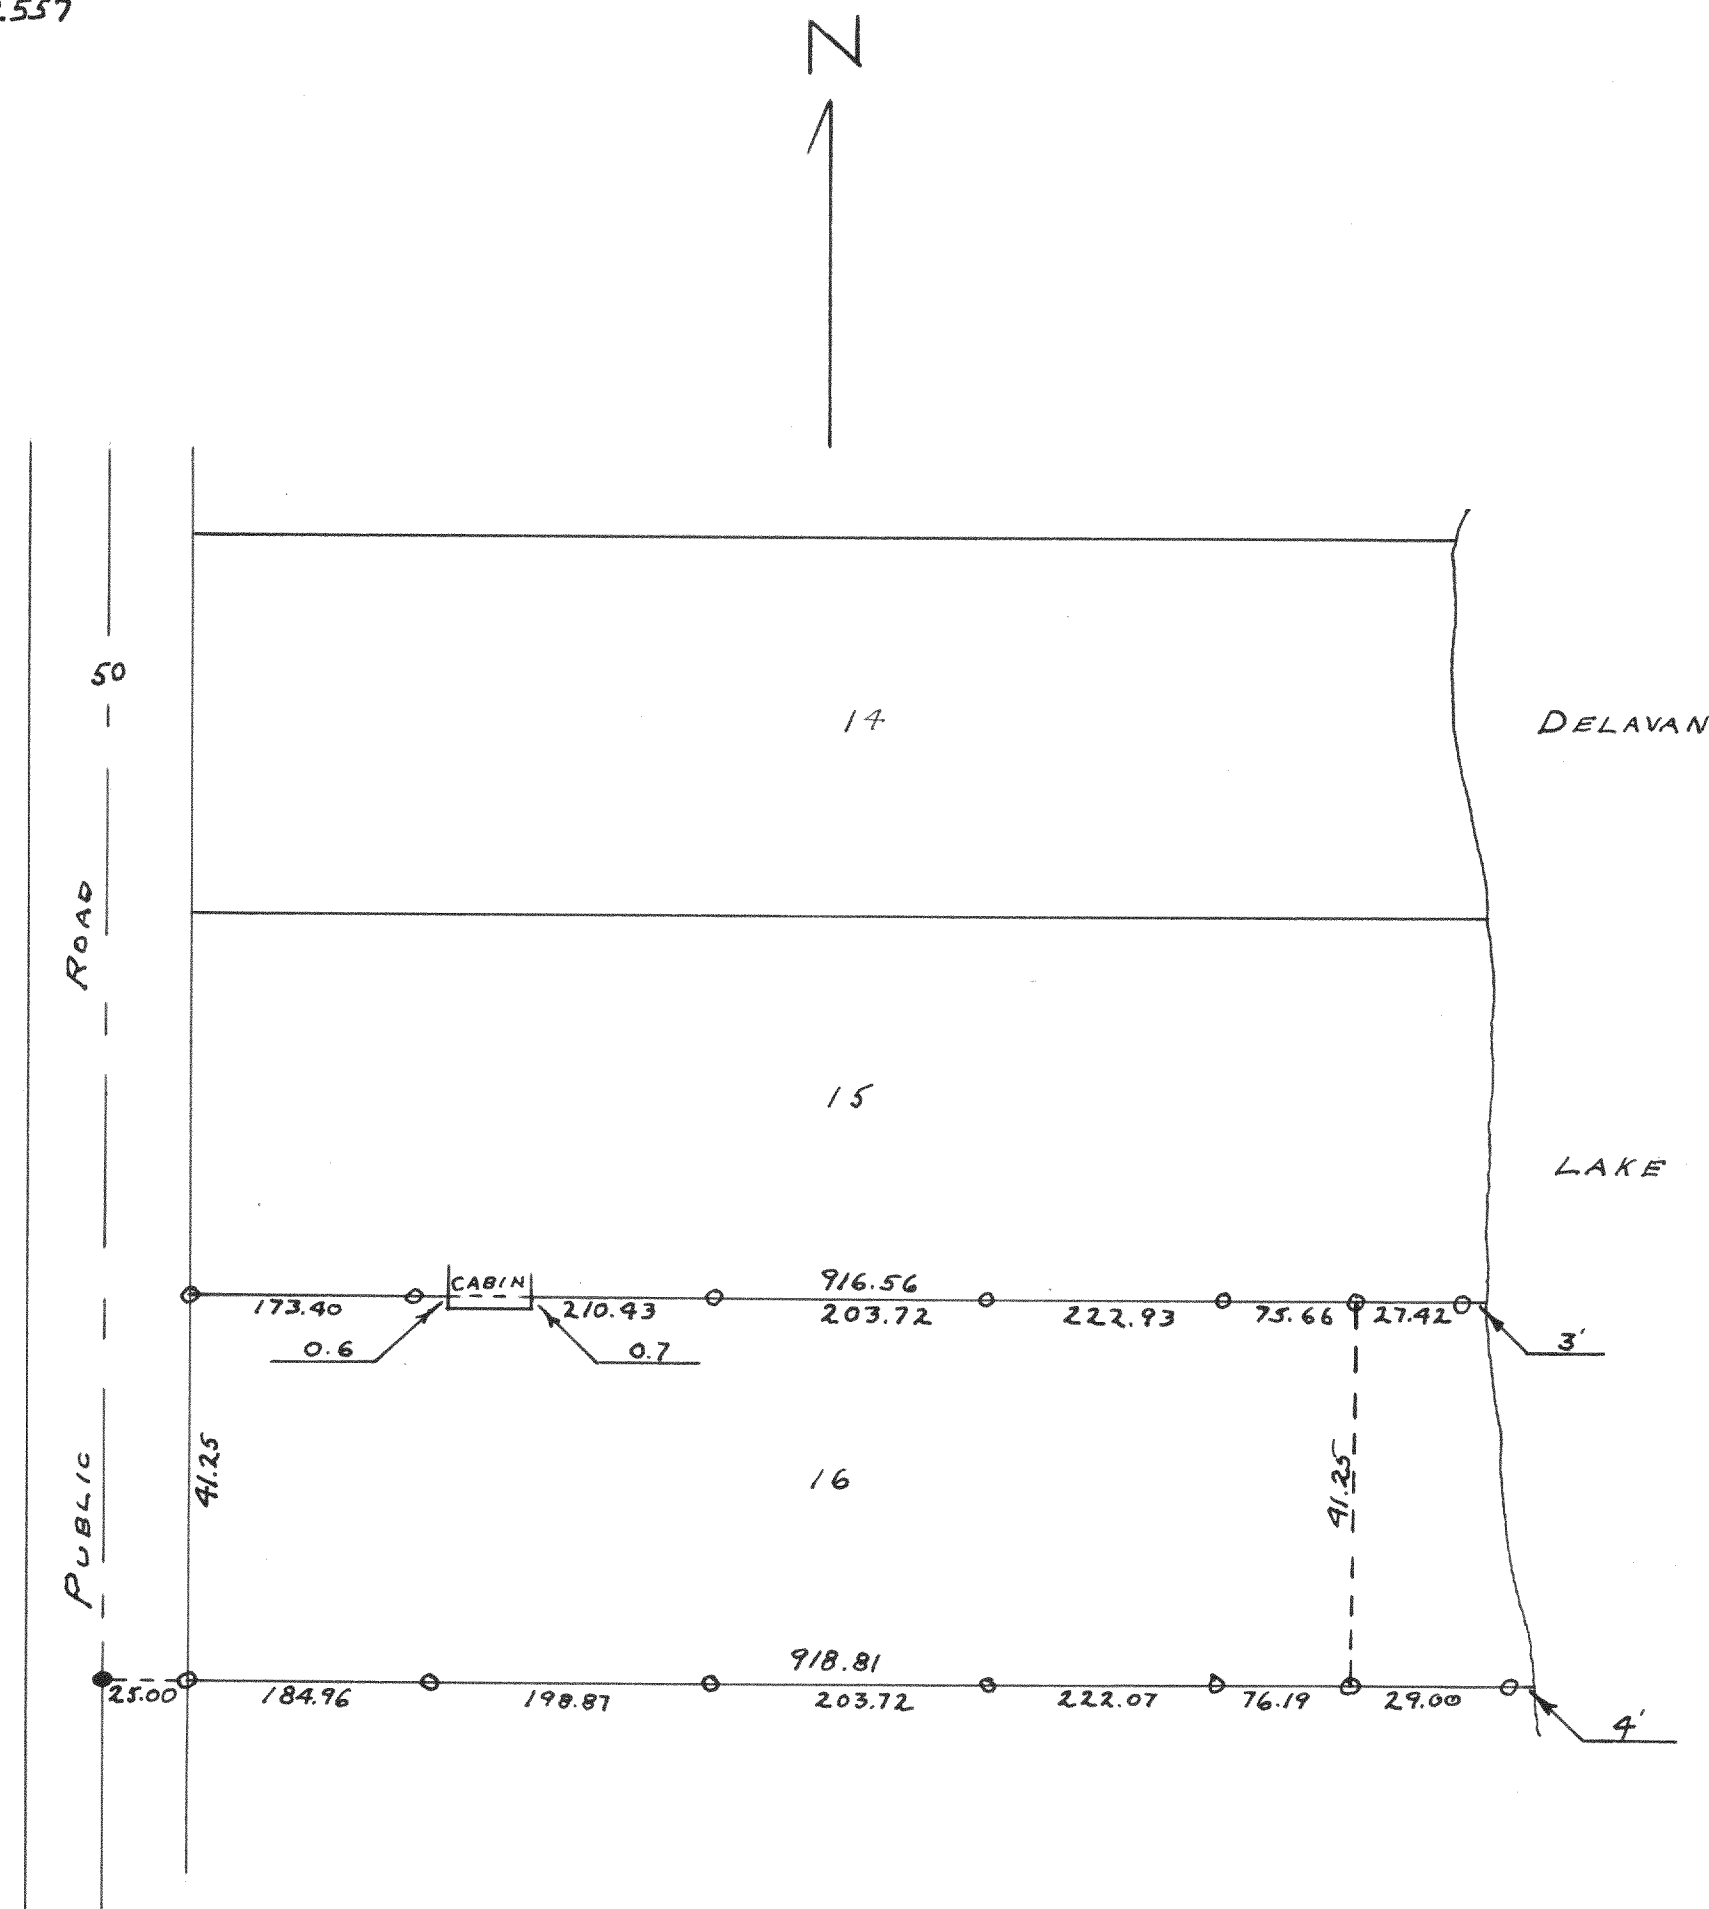

PLAT OF A SURVEY OF LOT 16 OF STROW
PARK SUBDIVISION, LOCATED IN SECTION 28, T2N,
R 16 E OF WALWORTH COUNTY, WISCONSIN.
JULY 1952

Lloyd L. Jensen SA
COUNTY SURVEYOR

2558

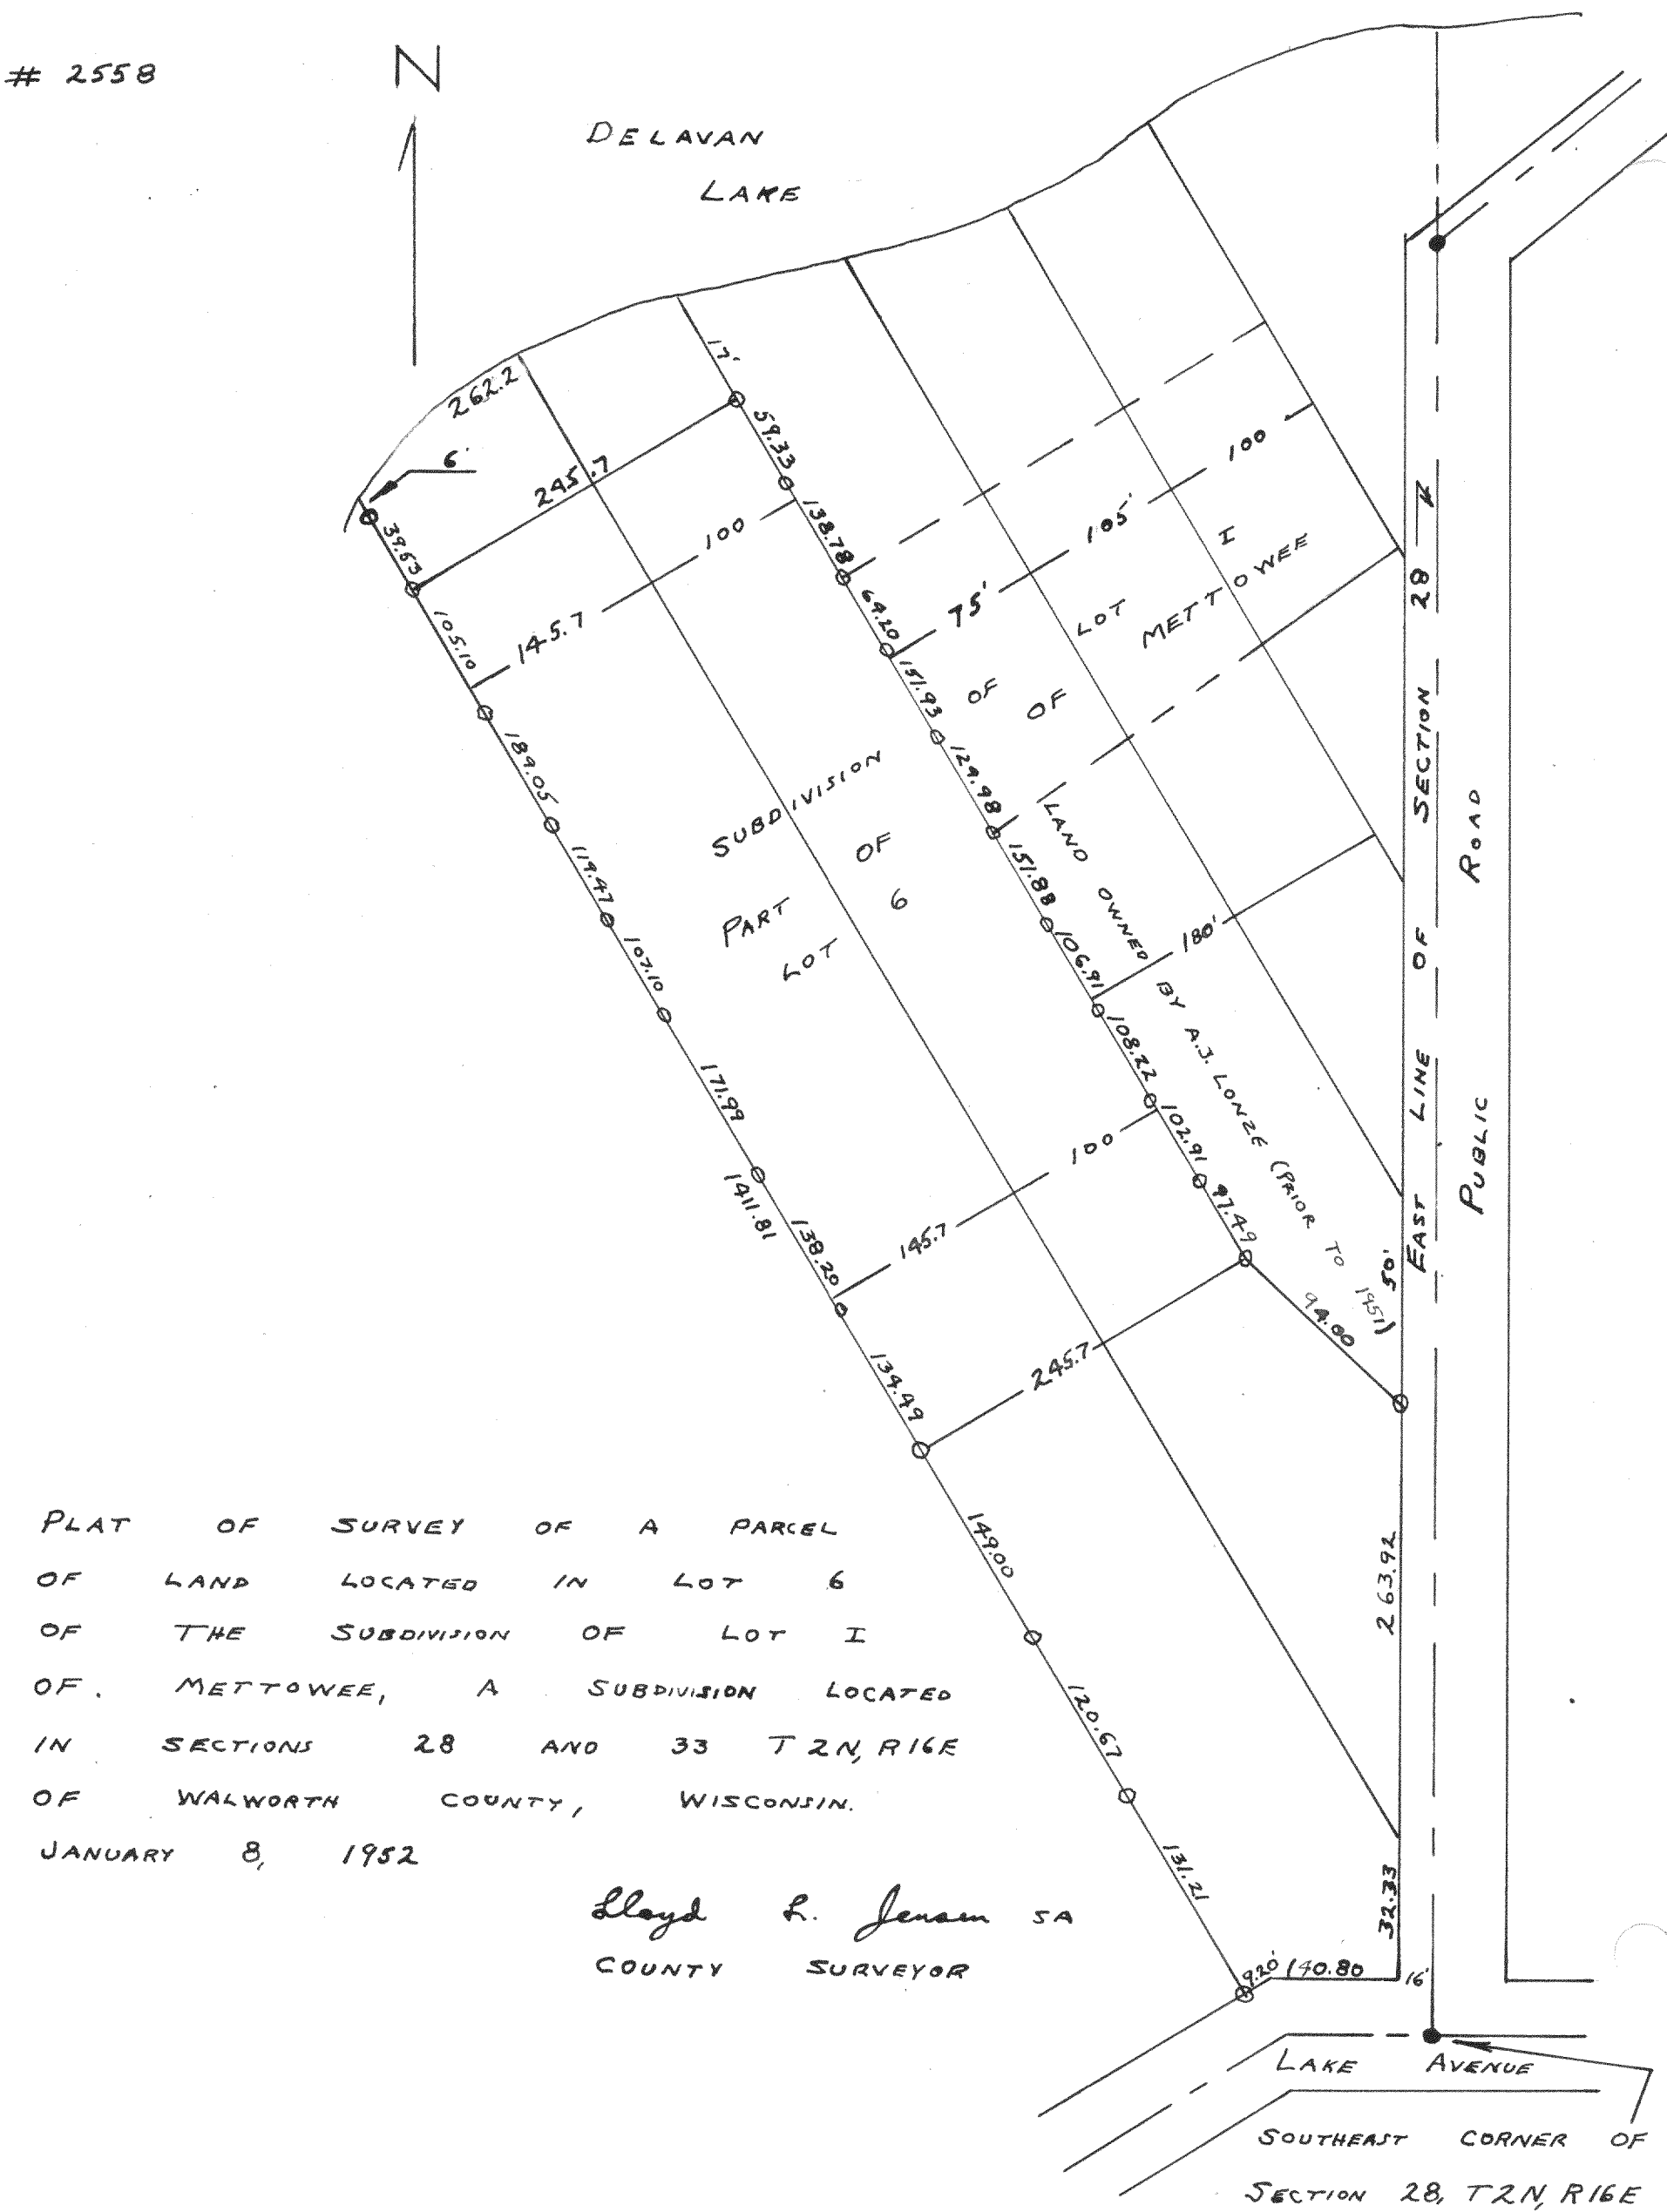

PLAT OF SURVEY OF A PARCEL
OF LAND LOCATED IN LOT 6
OF THE SUBDIVISION OF LOT I
OF, METTOWEE, A SUBDIVISION LOCATED
IN SECTIONS 28 AND 33 T2N, R16E
OF WALWORTH COUNTY, WISCONSIN.
JANUARY 8, 1952

Lloyd L. Jensen SA
COUNTY SURVEYOR

LAKE AVENUE
SOUTHEAST CORNER OF
SECTION 28, T2N, R16E