



2561

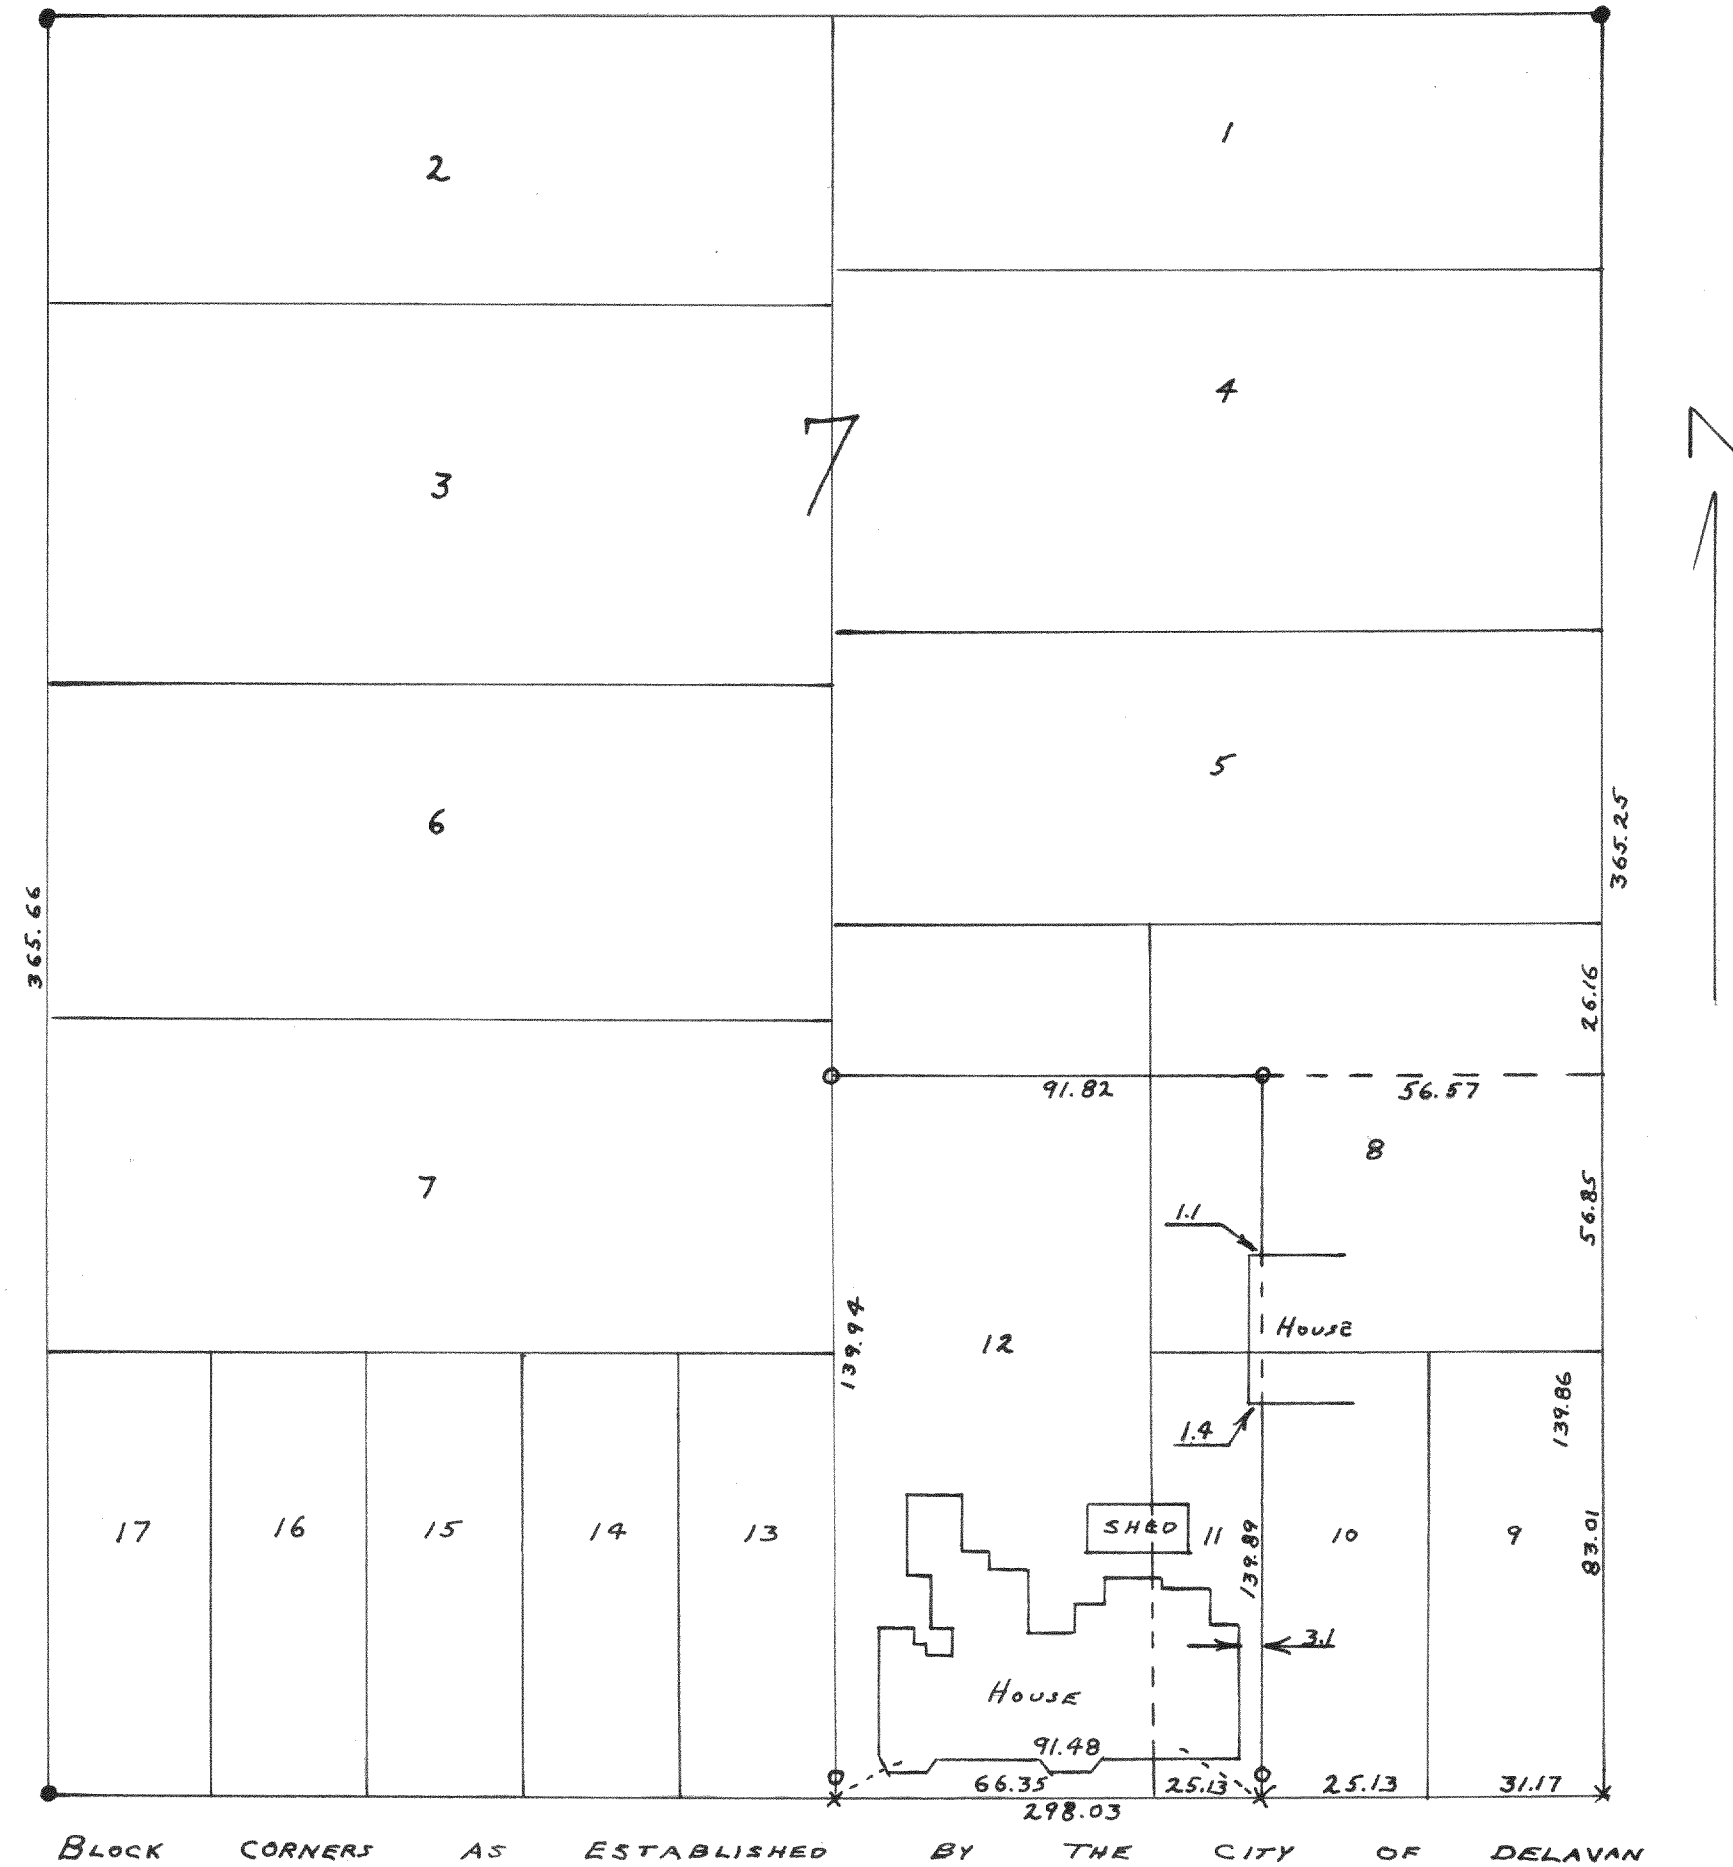

PLAT OF SURVEY OF LOT 11, THE WEST 25 FEET OF THE
SOUTH 56 1/2 FEET OF LOT 8 AND LOT 12 EXCEPT THE NORTH
26 FEET, THEREOF IN BLOCK 7 OF THE ORIGINAL PLAT OF THE
VILLAGE, NOW CITY OF DELAVAN, WALWORTH COUNTY, WISCONSIN.
NOVEMBER 1951 Lloyd L. Jensen SA

Lloyd L. Jensen SA
COUNTY SURVEYOR

2562

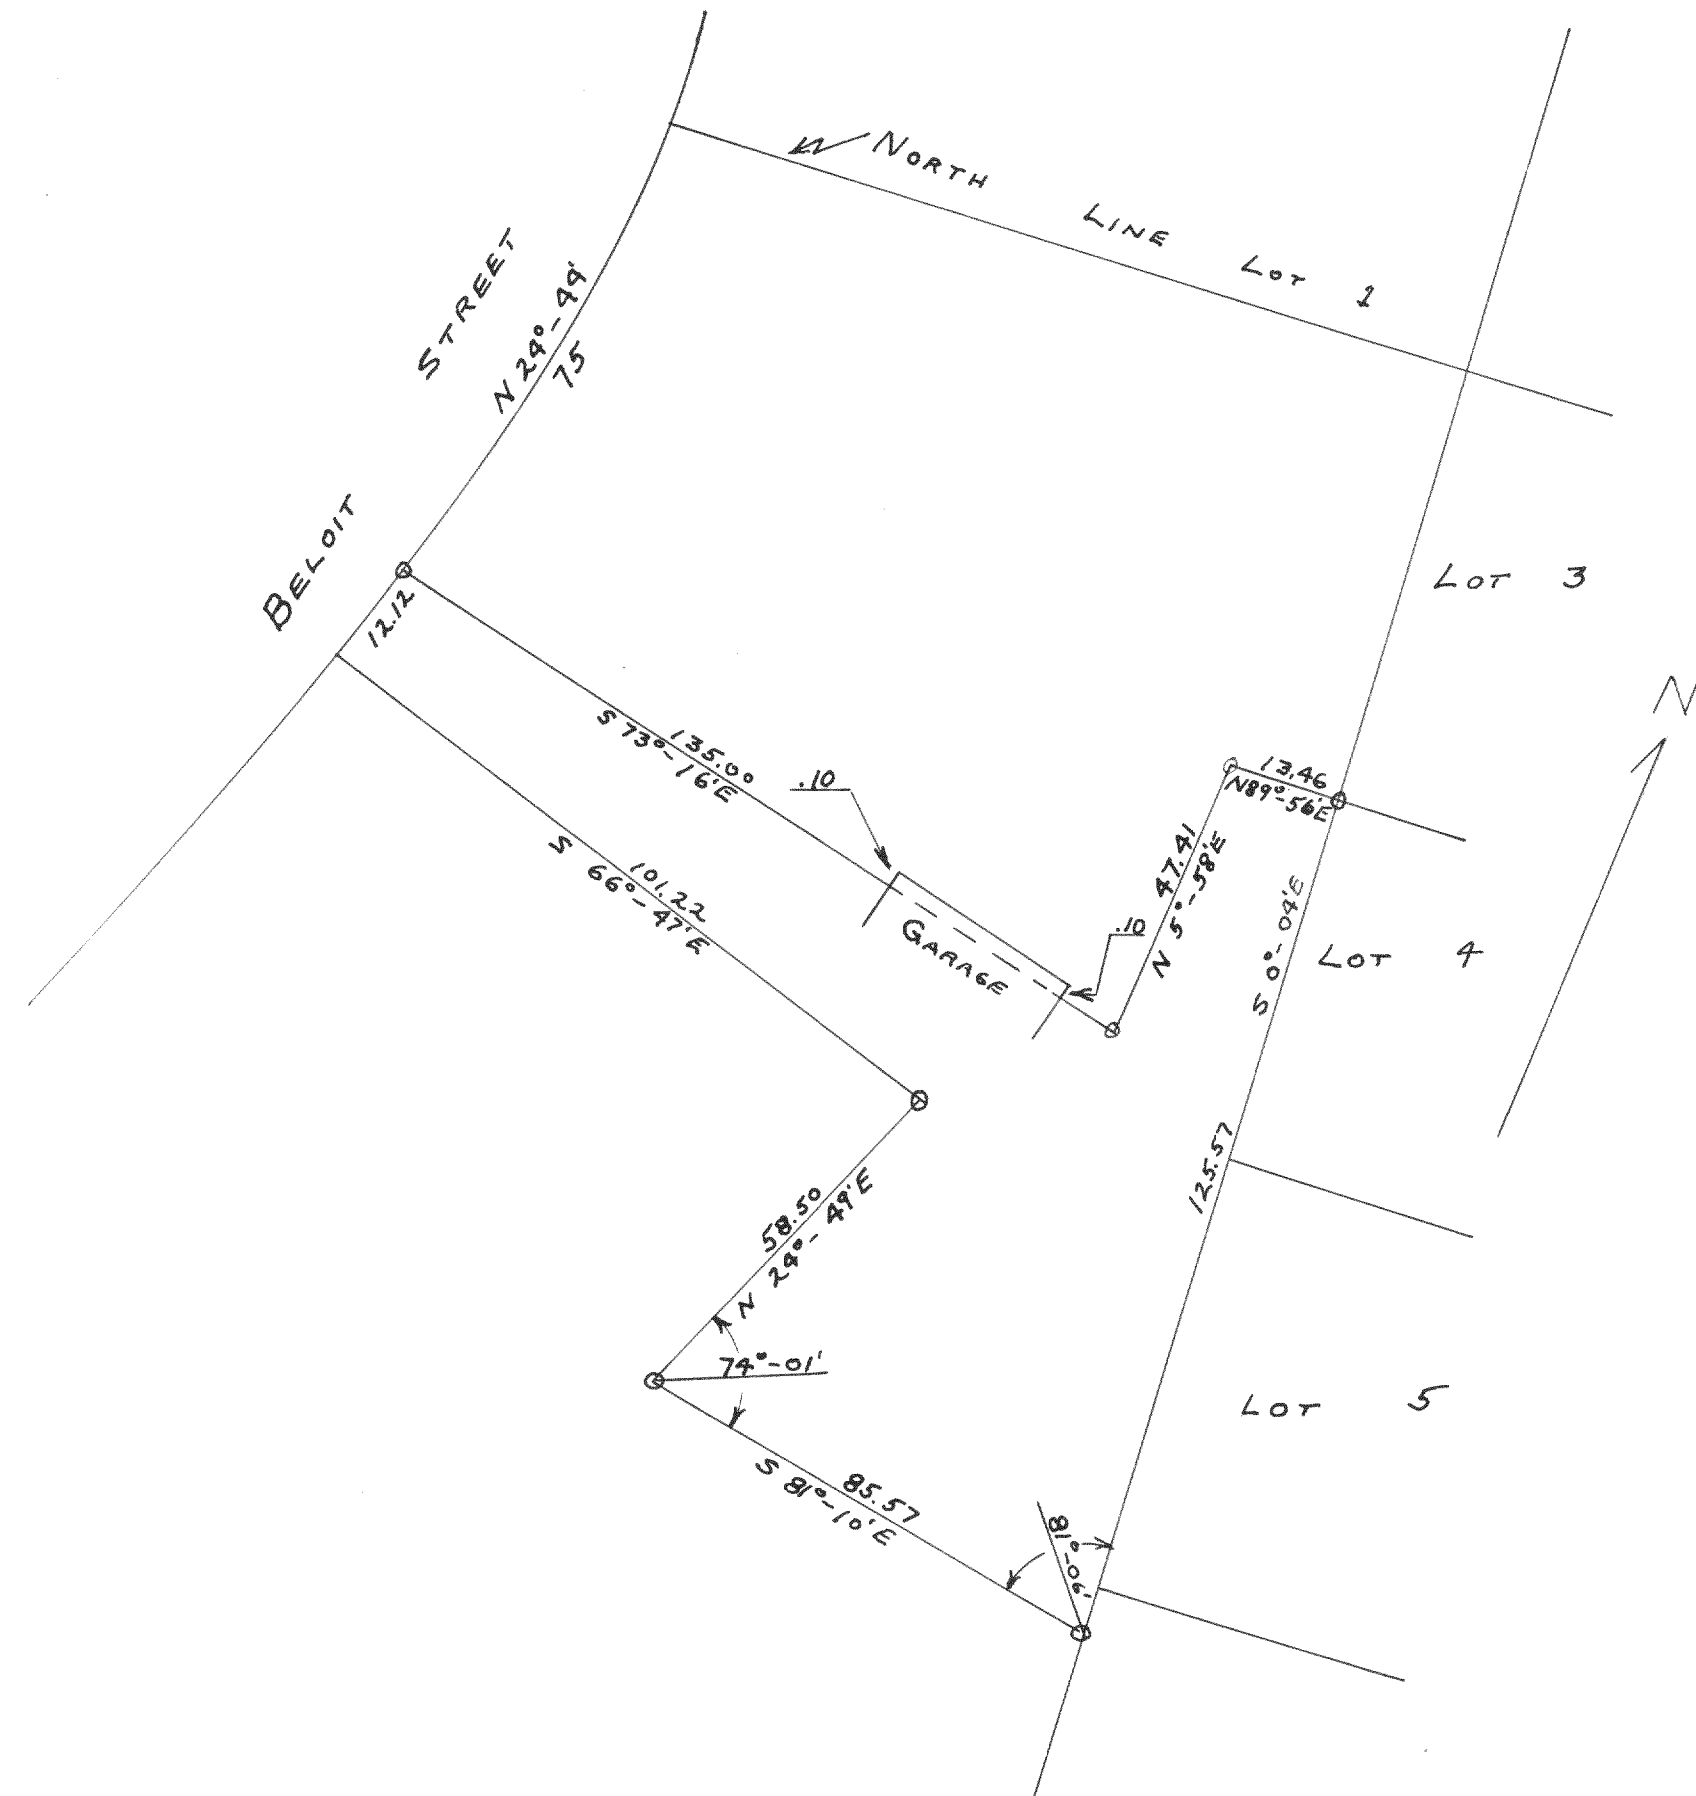

PLAT OF SURVEY OF A PARCEL OF LAND
LOCATED IN LOT 1 BLOCK I OF SUNSET
VIEW SUBDIVISION IN THE CITY OF DELAWARE,
WALWORTH COUNTY, WISCONSIN.
APRIL 27, 1952

Lloyd L. Jensen SA
COUNTY SURVEYOR