



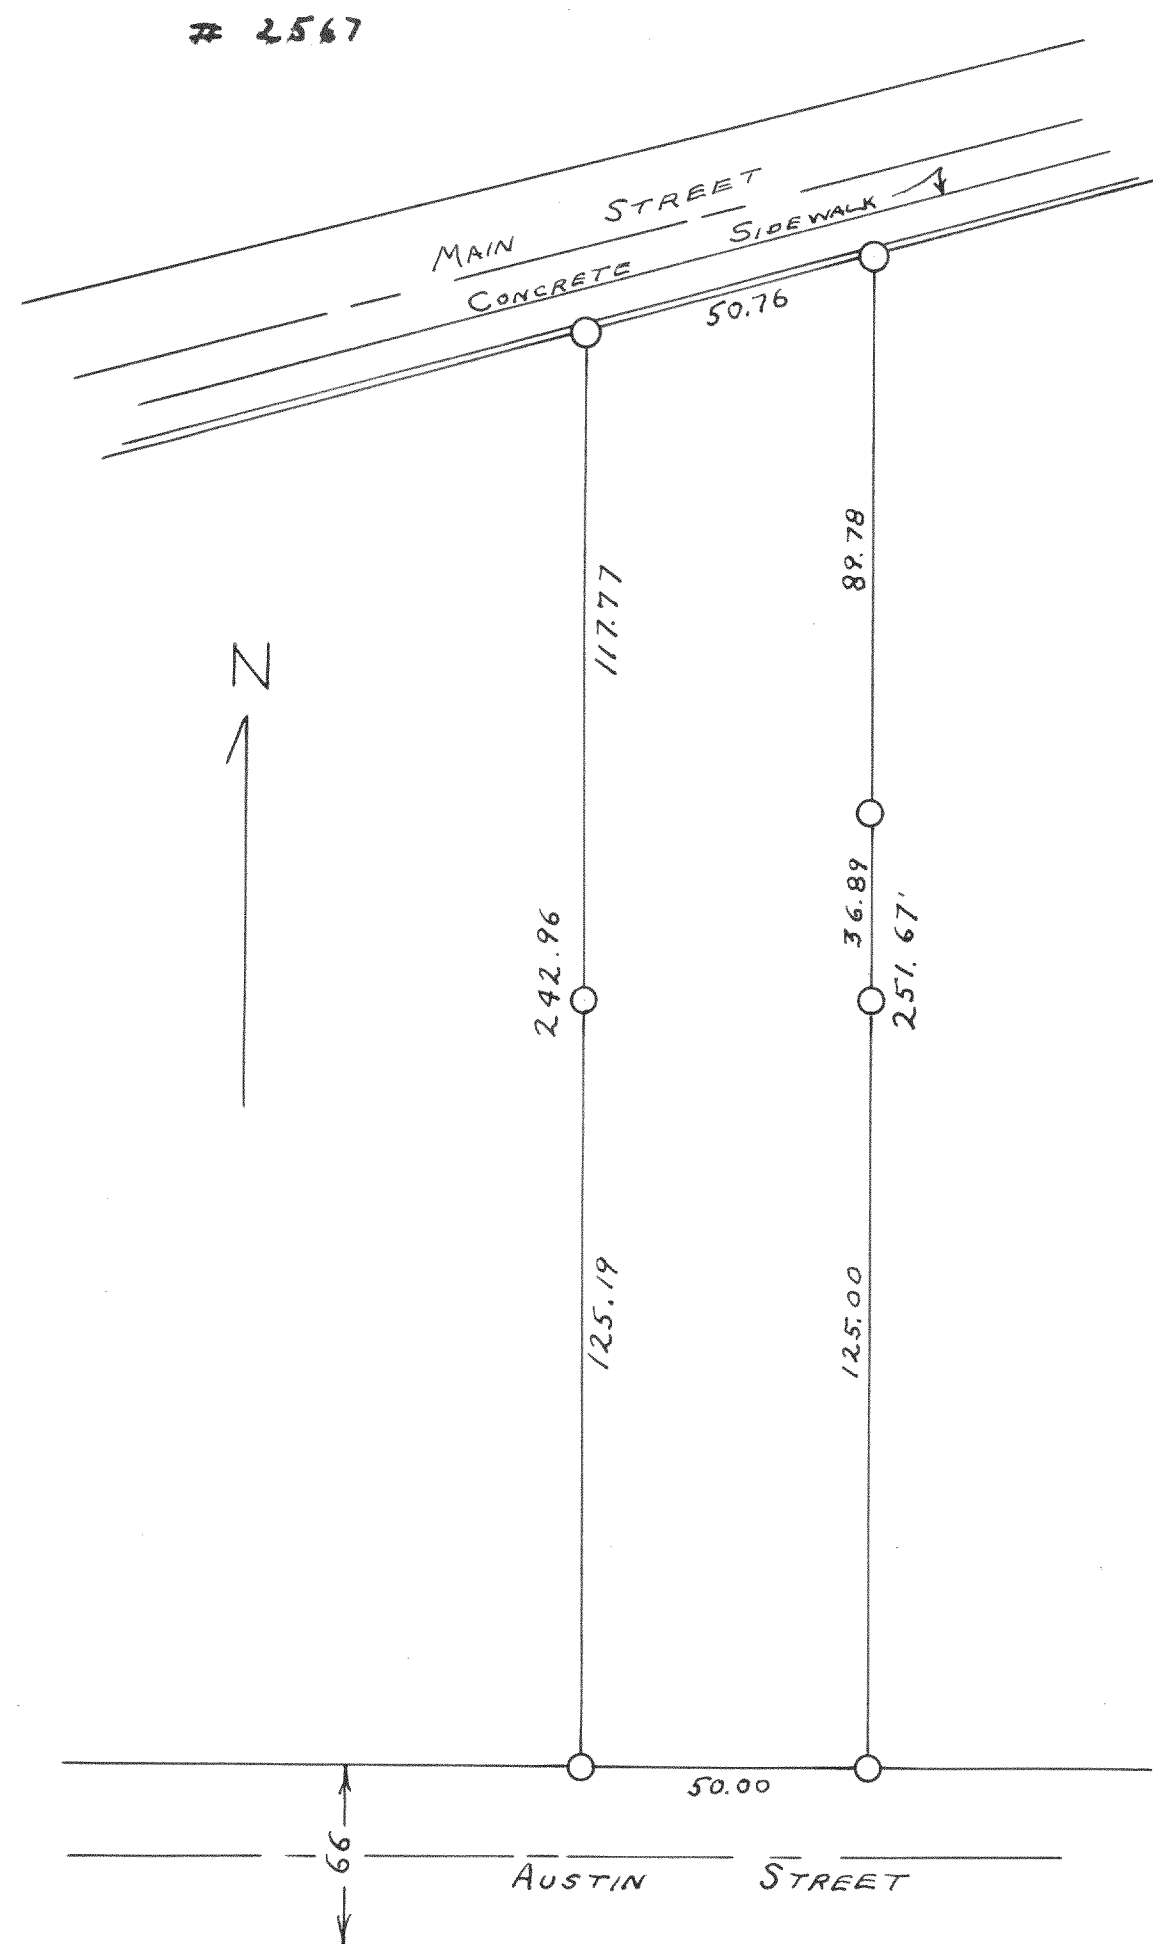

PLAT OF SURVEY OF THE EAST 50 FEET OF LOT 2 OF BLOCK 10 OF THE ORIGINAL PLAT OF THE VILLAGE OF EAST TROY, WALWORTH COUNTY WISCONSIN JANUARY 1952

Lloyd L. Jensen SA
COUNTY SURVEYOR

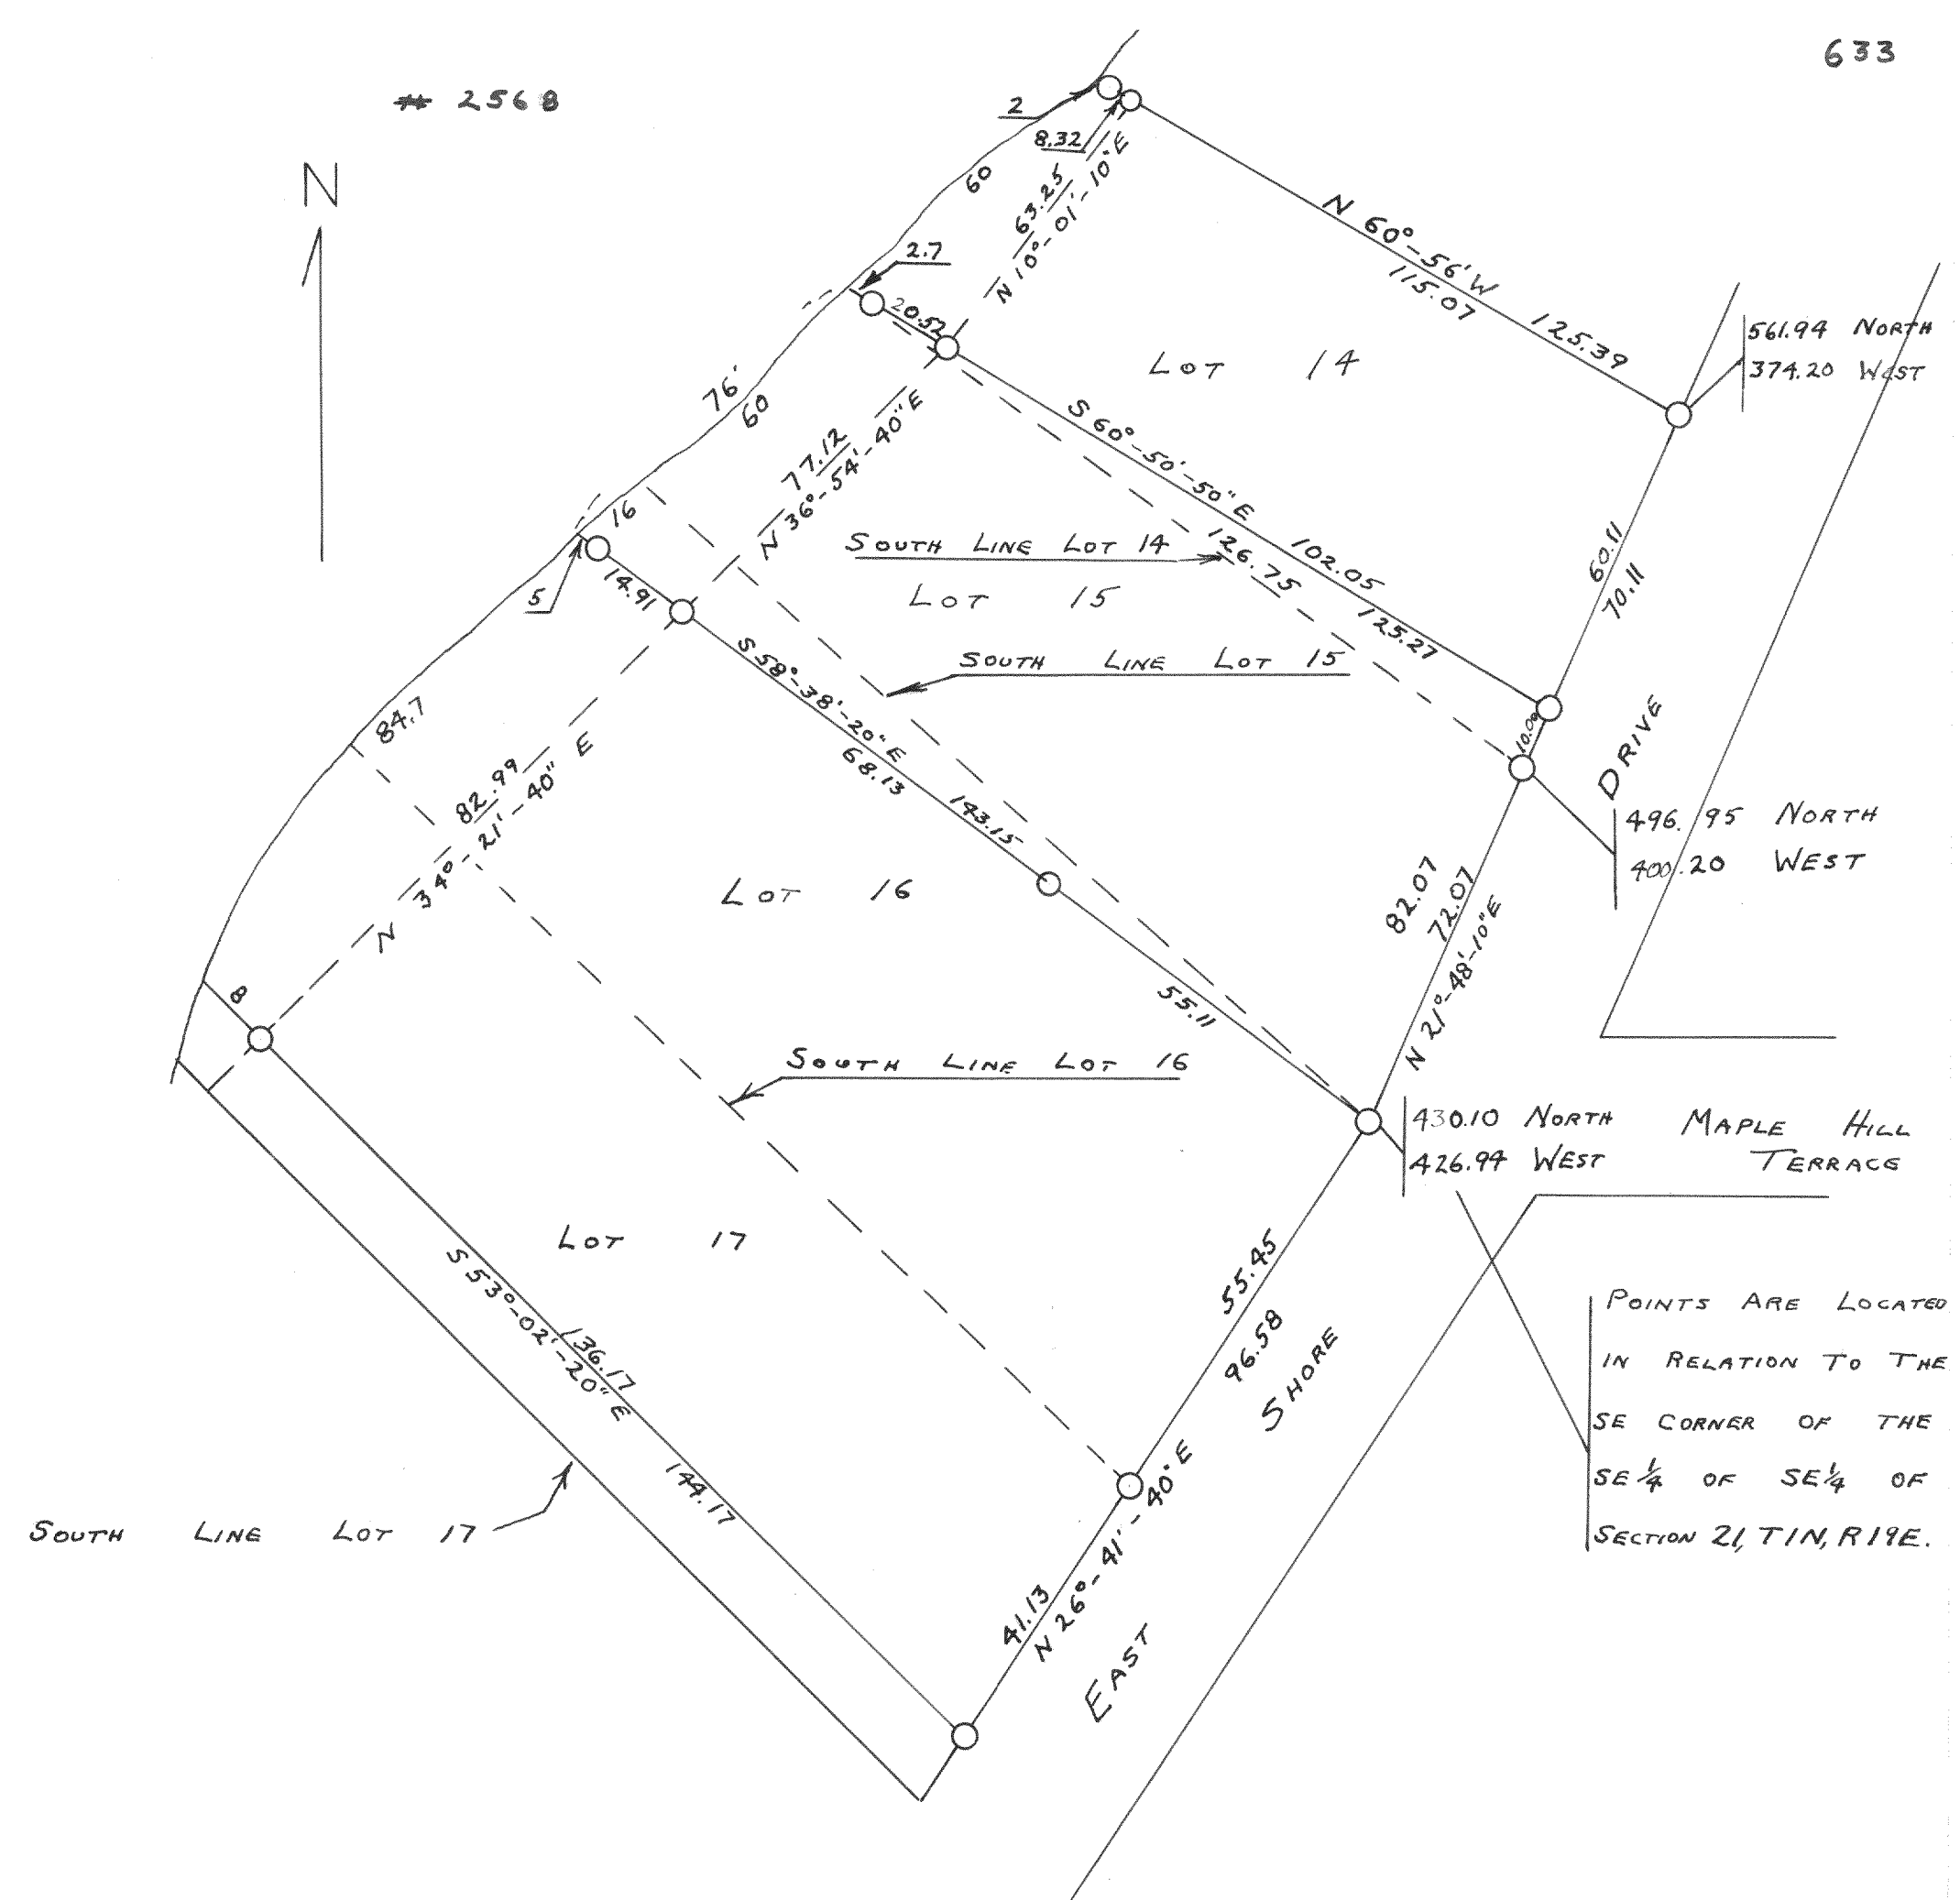

PLAT OF SURVEY OF LAND LOCATED IN THE SOUTHEAST FRACTIONAL 1/4 OF THE SOUTHEAST FRACTIONAL 1/4 OF SECTION 21, T1N, R19E OF THE 4TH PRINCIPAL MERIDIAN AND BEING IN THE VILLAGE OF TWIN LAKES, KENOSHA COUNTY, WISCONSIN JULY 1952

Lloyd L. Jensen SA
COUNTY